


GEORGE T. DUNHAM
SURVEYING & ENGINEERING
DELAVER, WISCONSIN

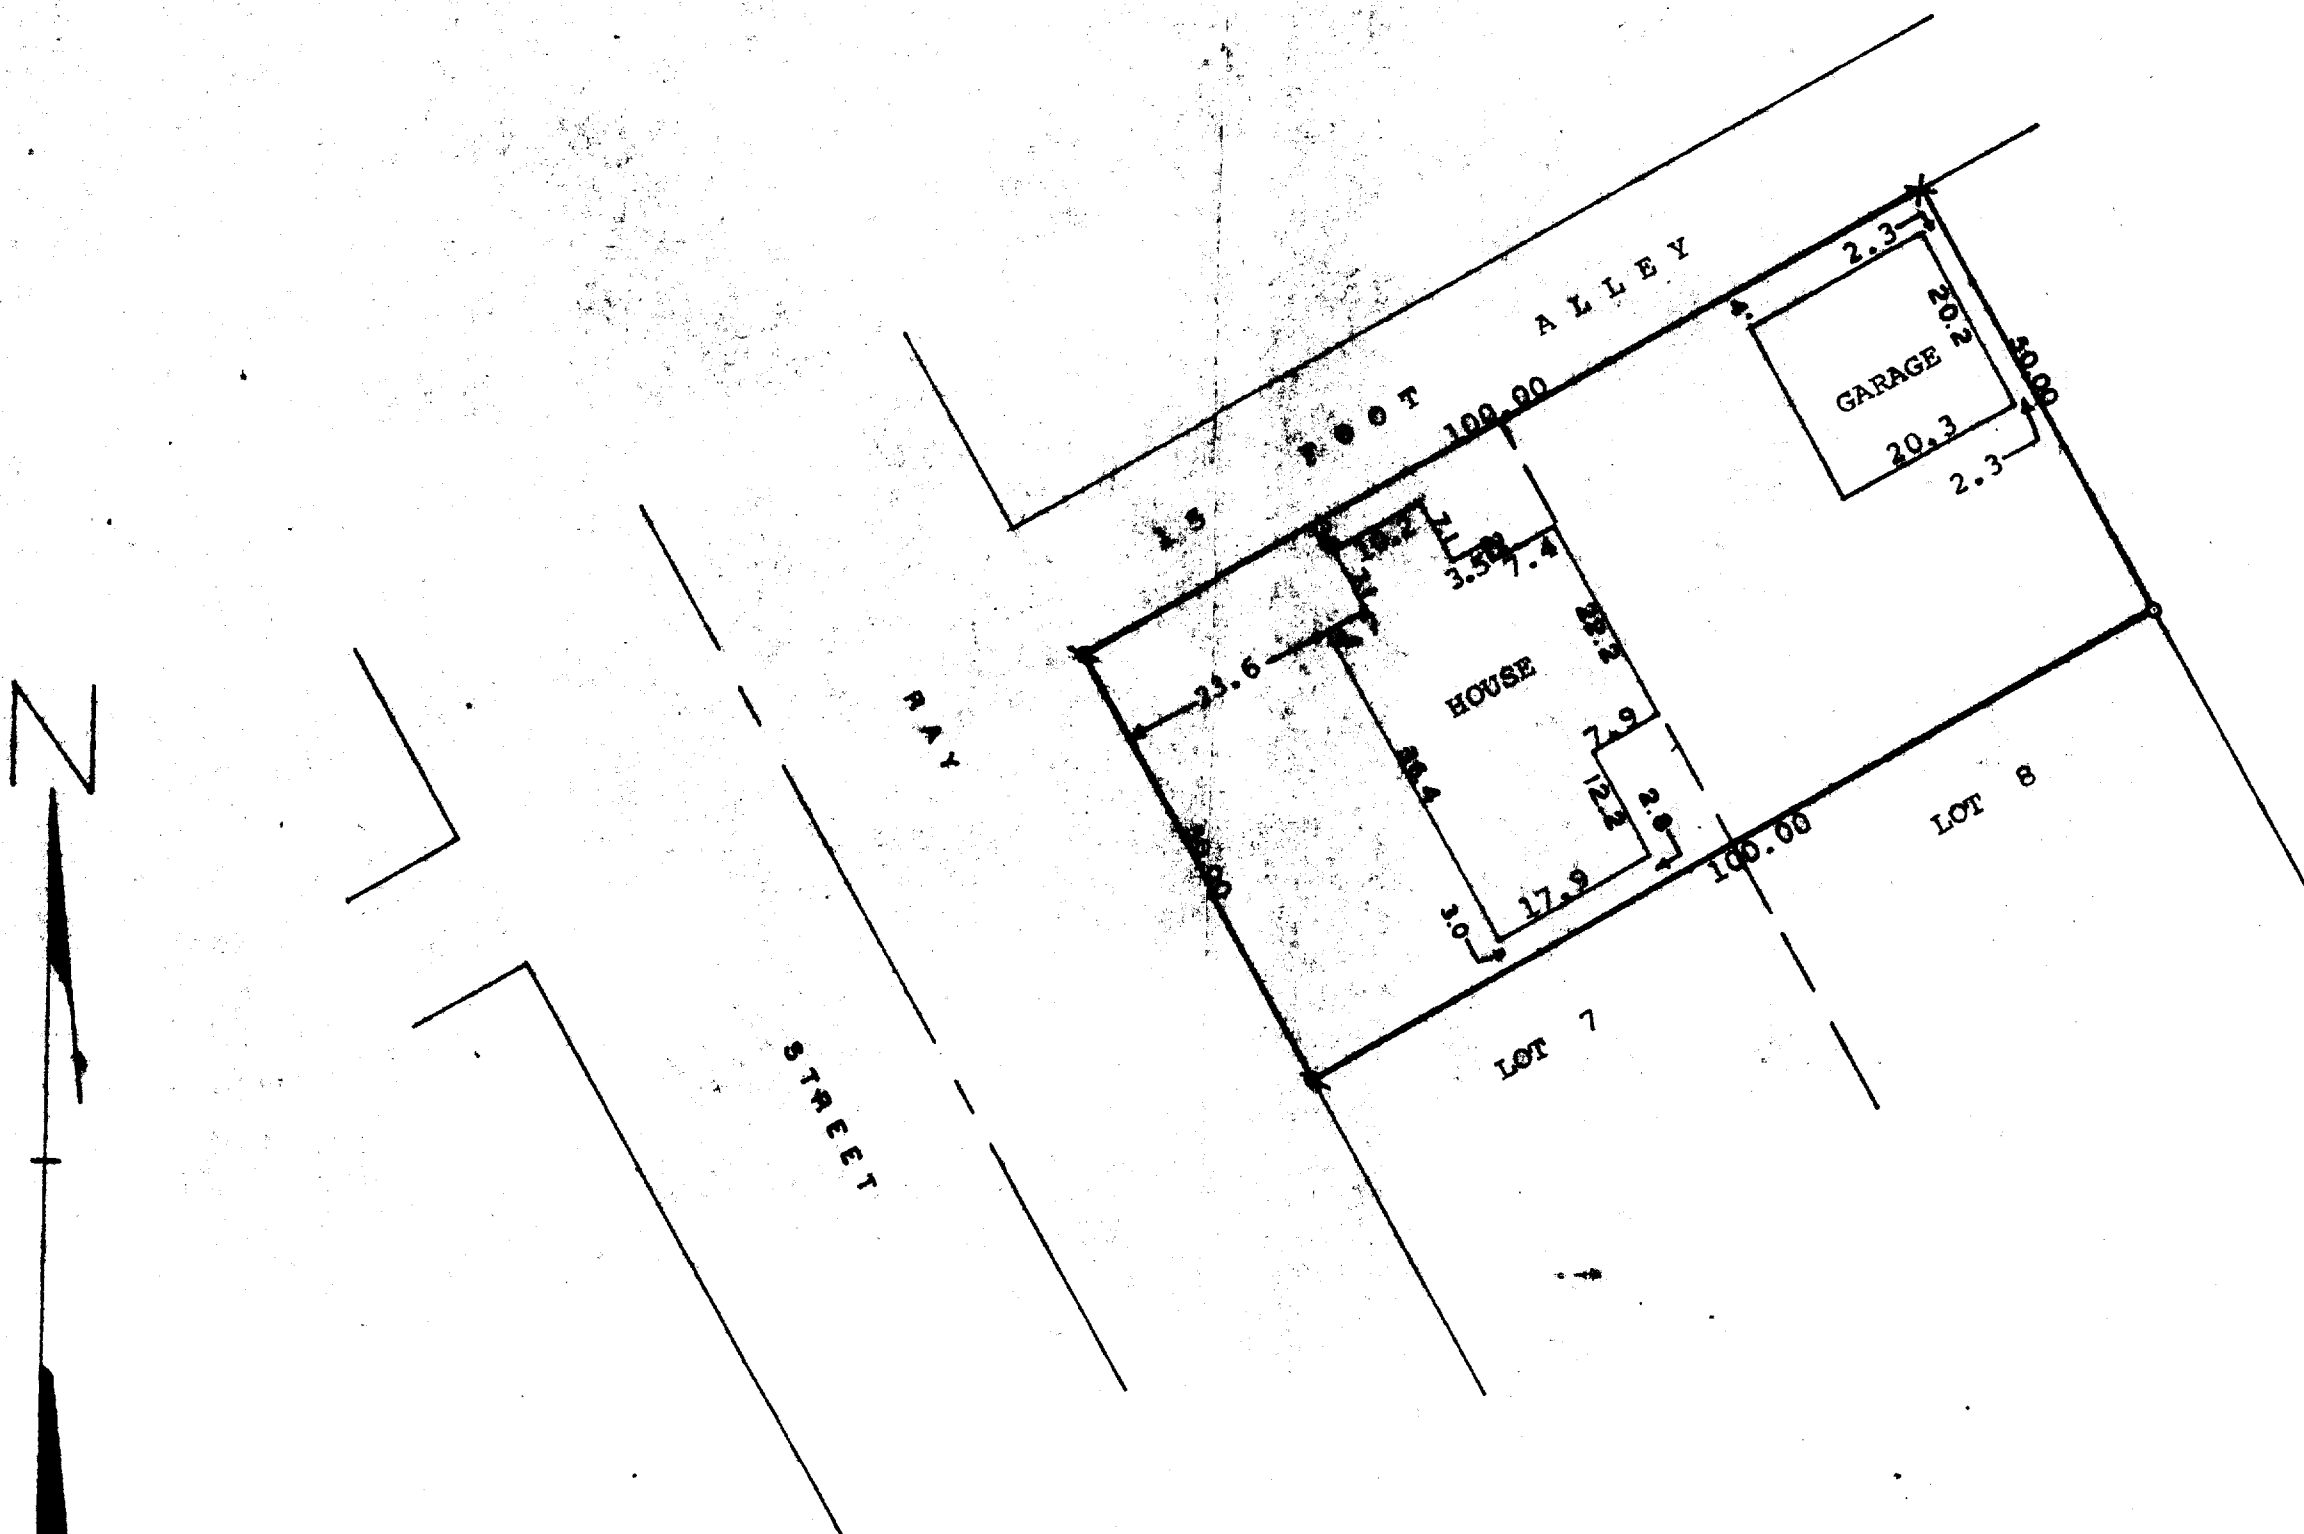

Scale - 1" = 20'
 # = Iron Pipe Found
 o = Iron Pipe Set
 X = Cross in Concrete

STATE OF WISCONSIN)
 COUNTY OF WALWORTH) SS

I, James M. Dunham, Surveyor, certify that I have surveyed the property described as follows,

The Northerly 50.00 feet of Lots 7 and 8, Block 1, Converse's Subdivision to the City of Delavan, Walworth County, Wisconsin and that the above map is a true representation thereof and shows the size and location of the property, its exterior boundaries, the location of all visible structures and dimensions of all principal buildings thereon, boundary fences, apparent easements, roadways and visible encroachments, if any.

This survey is made for the use of the present owners of the property, and also those who purchase, mortgage, or guarantee the title thereto within one (1) year from date hereof.
 August 15, 1980

James M. Dunham
 James M. Dunham, Surveyor

