


DUNHAM SURVEYING, S.C.
 SURVEYING & SUBDIVIDING
 DELAVAN, WISCONSIN 53115

N



Scale - 1" = 20'
 ○ = Iron Pipe Found

NOTE: Driveway difficult to locate because of snow cover.

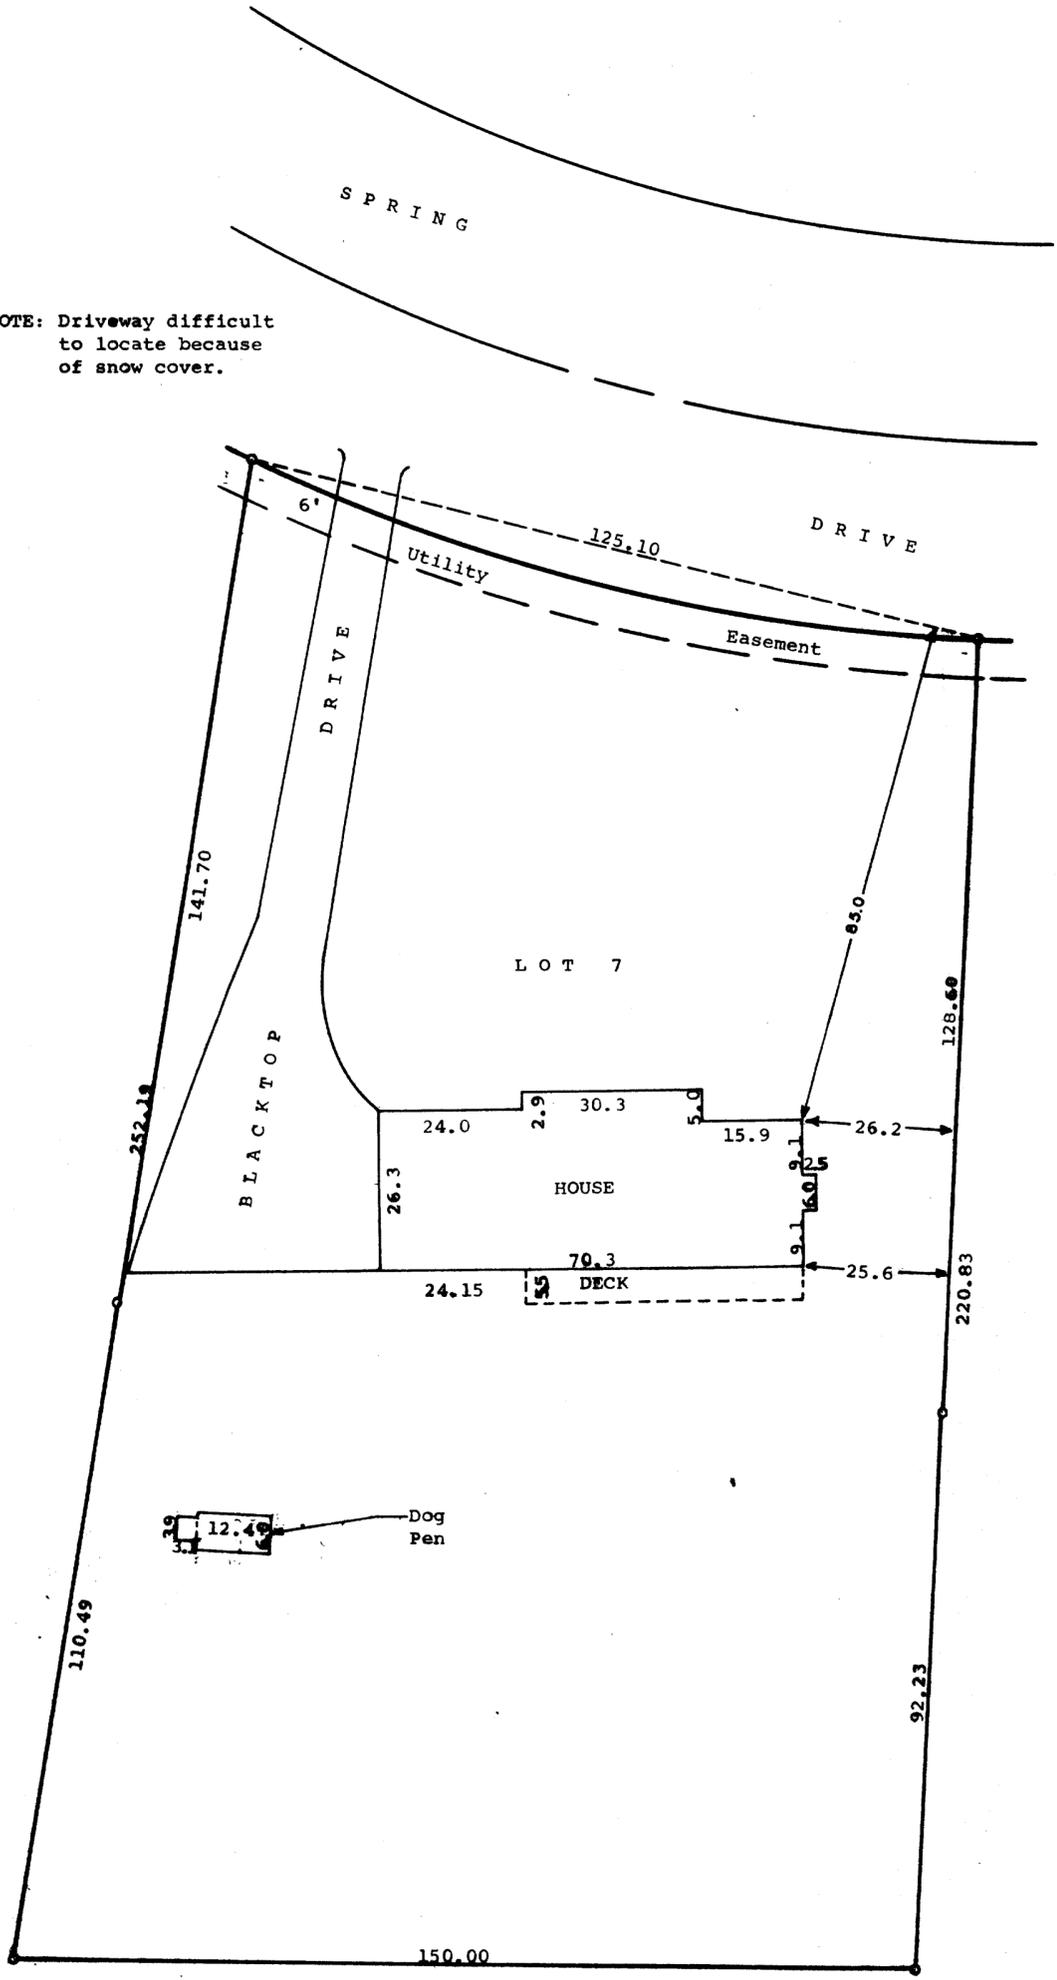

STATE OF WISCONSIN) SS
 COUNTY OF WALWORTH)
 I, George T. Dunham, Surveyor, certify that I have surveyed the property described as follows;
 Lot 7, Block 7 of Springs Park Subdivision Addition No. 2, located in the City of Delavan, Walworth County, Wisconsin,
 and the above map is a true representation thereof and shows the size and location of the property, its exterior boundaries, the location and dimensions of all structures thereon, fences, apparent easements and roadways and visible encroachments, if any.
 This survey is made for the exclusive use of the present owners of the property, and also those who purchase, mortgage, or guarantee the title thereto within one (1) year from date hereof; and as to them I warrant the accuracy of said survey and map.
 January 18, 1979

George T. Dunham
 George T. Dunham, Surveyor

