


DUNHAM SURVEYING, S.C.
SURVEYING & SUBDIVIDING
DELAVAN, WISCONSIN 53115

WASHINGTON

STREET

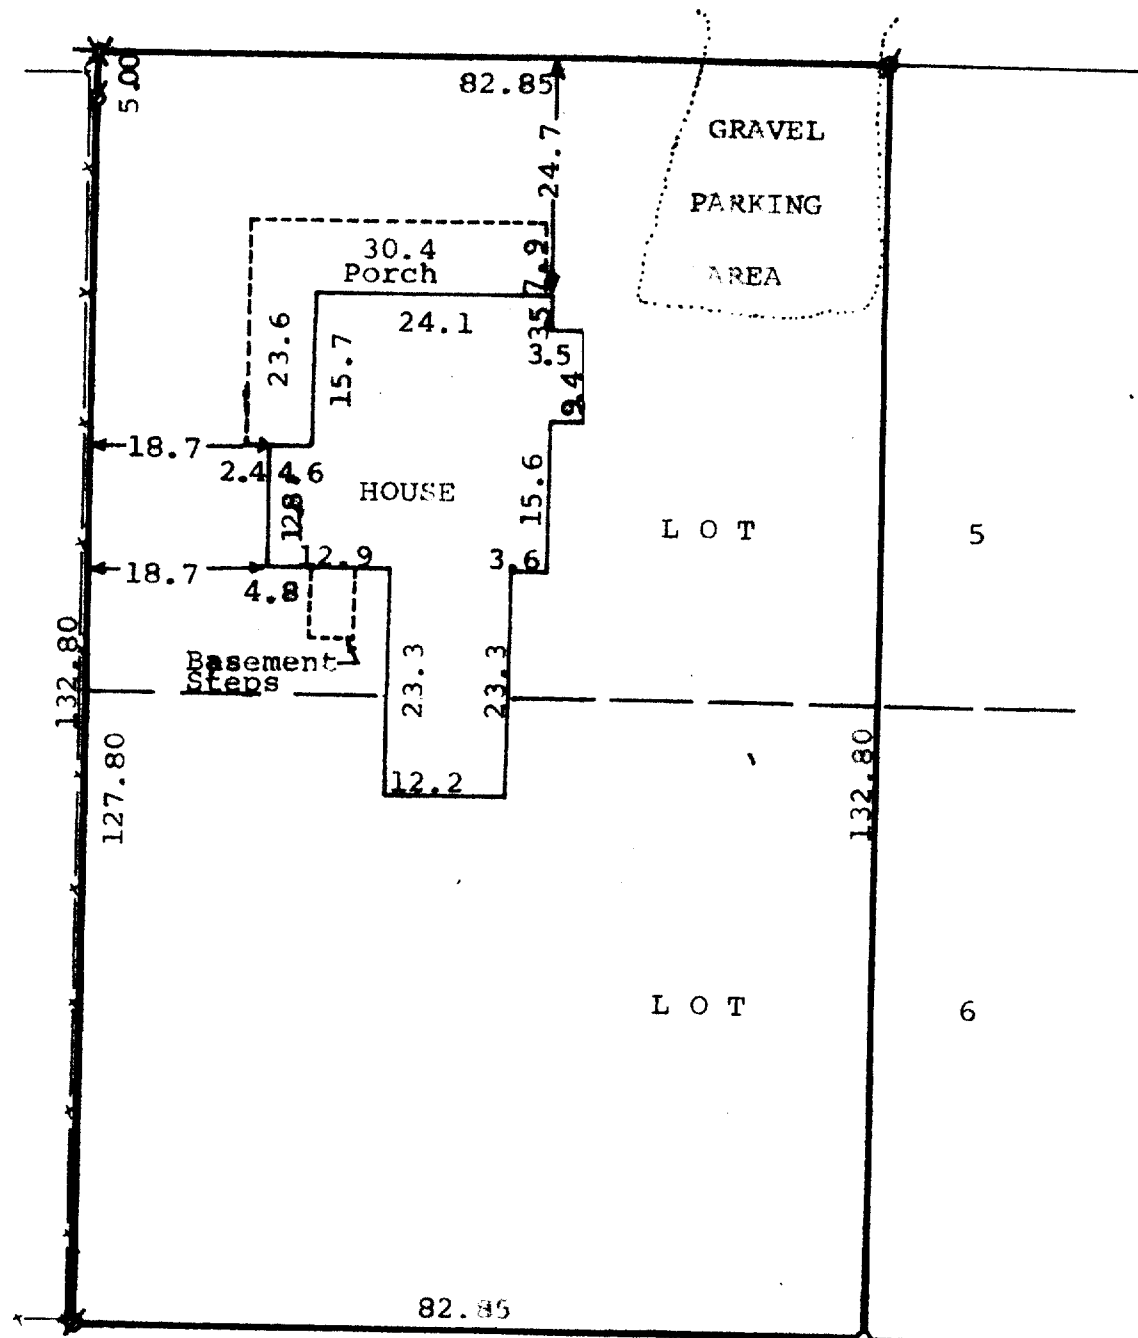

Scale - 1" = 20'
 ⦿ = Iron Pipe Found
 ⊗ = Iron Pipe Set
 X = Cross in Concrete
 -X- = Fence Line

STATE OF WISCONSIN)
COUNTY OF WALWORTH) SS

I, James M. Dunham, Surveyor, certify that I have surveyed the property described as follows,

The West 1/2 of Lots 5 and 6, Block 2 of Passage, Aram, and Downies Addition to the City of Delavan, Walworth County, Wisconsin, and that the above map is a true representation thereof and shows the size and location of the property, its exterior boundaries, the location of all visible structures and dimensions of all principal buildings thereon, boundary fences, apparent easements, roadways and visible encroachments, if any.

This survey is made for the use of the present owners of the property, and also those who purchase, mortgage, or guarantee the title thereto within one (1) year from date hereof.

July 19, 1979

James M. Dunham
James M. Dunham, Surveyor

