


DUNHAM SURVEYING, S. C.
SURVEYING & SUBDIVIDING
DELAVAN, WISCONSIN 53115

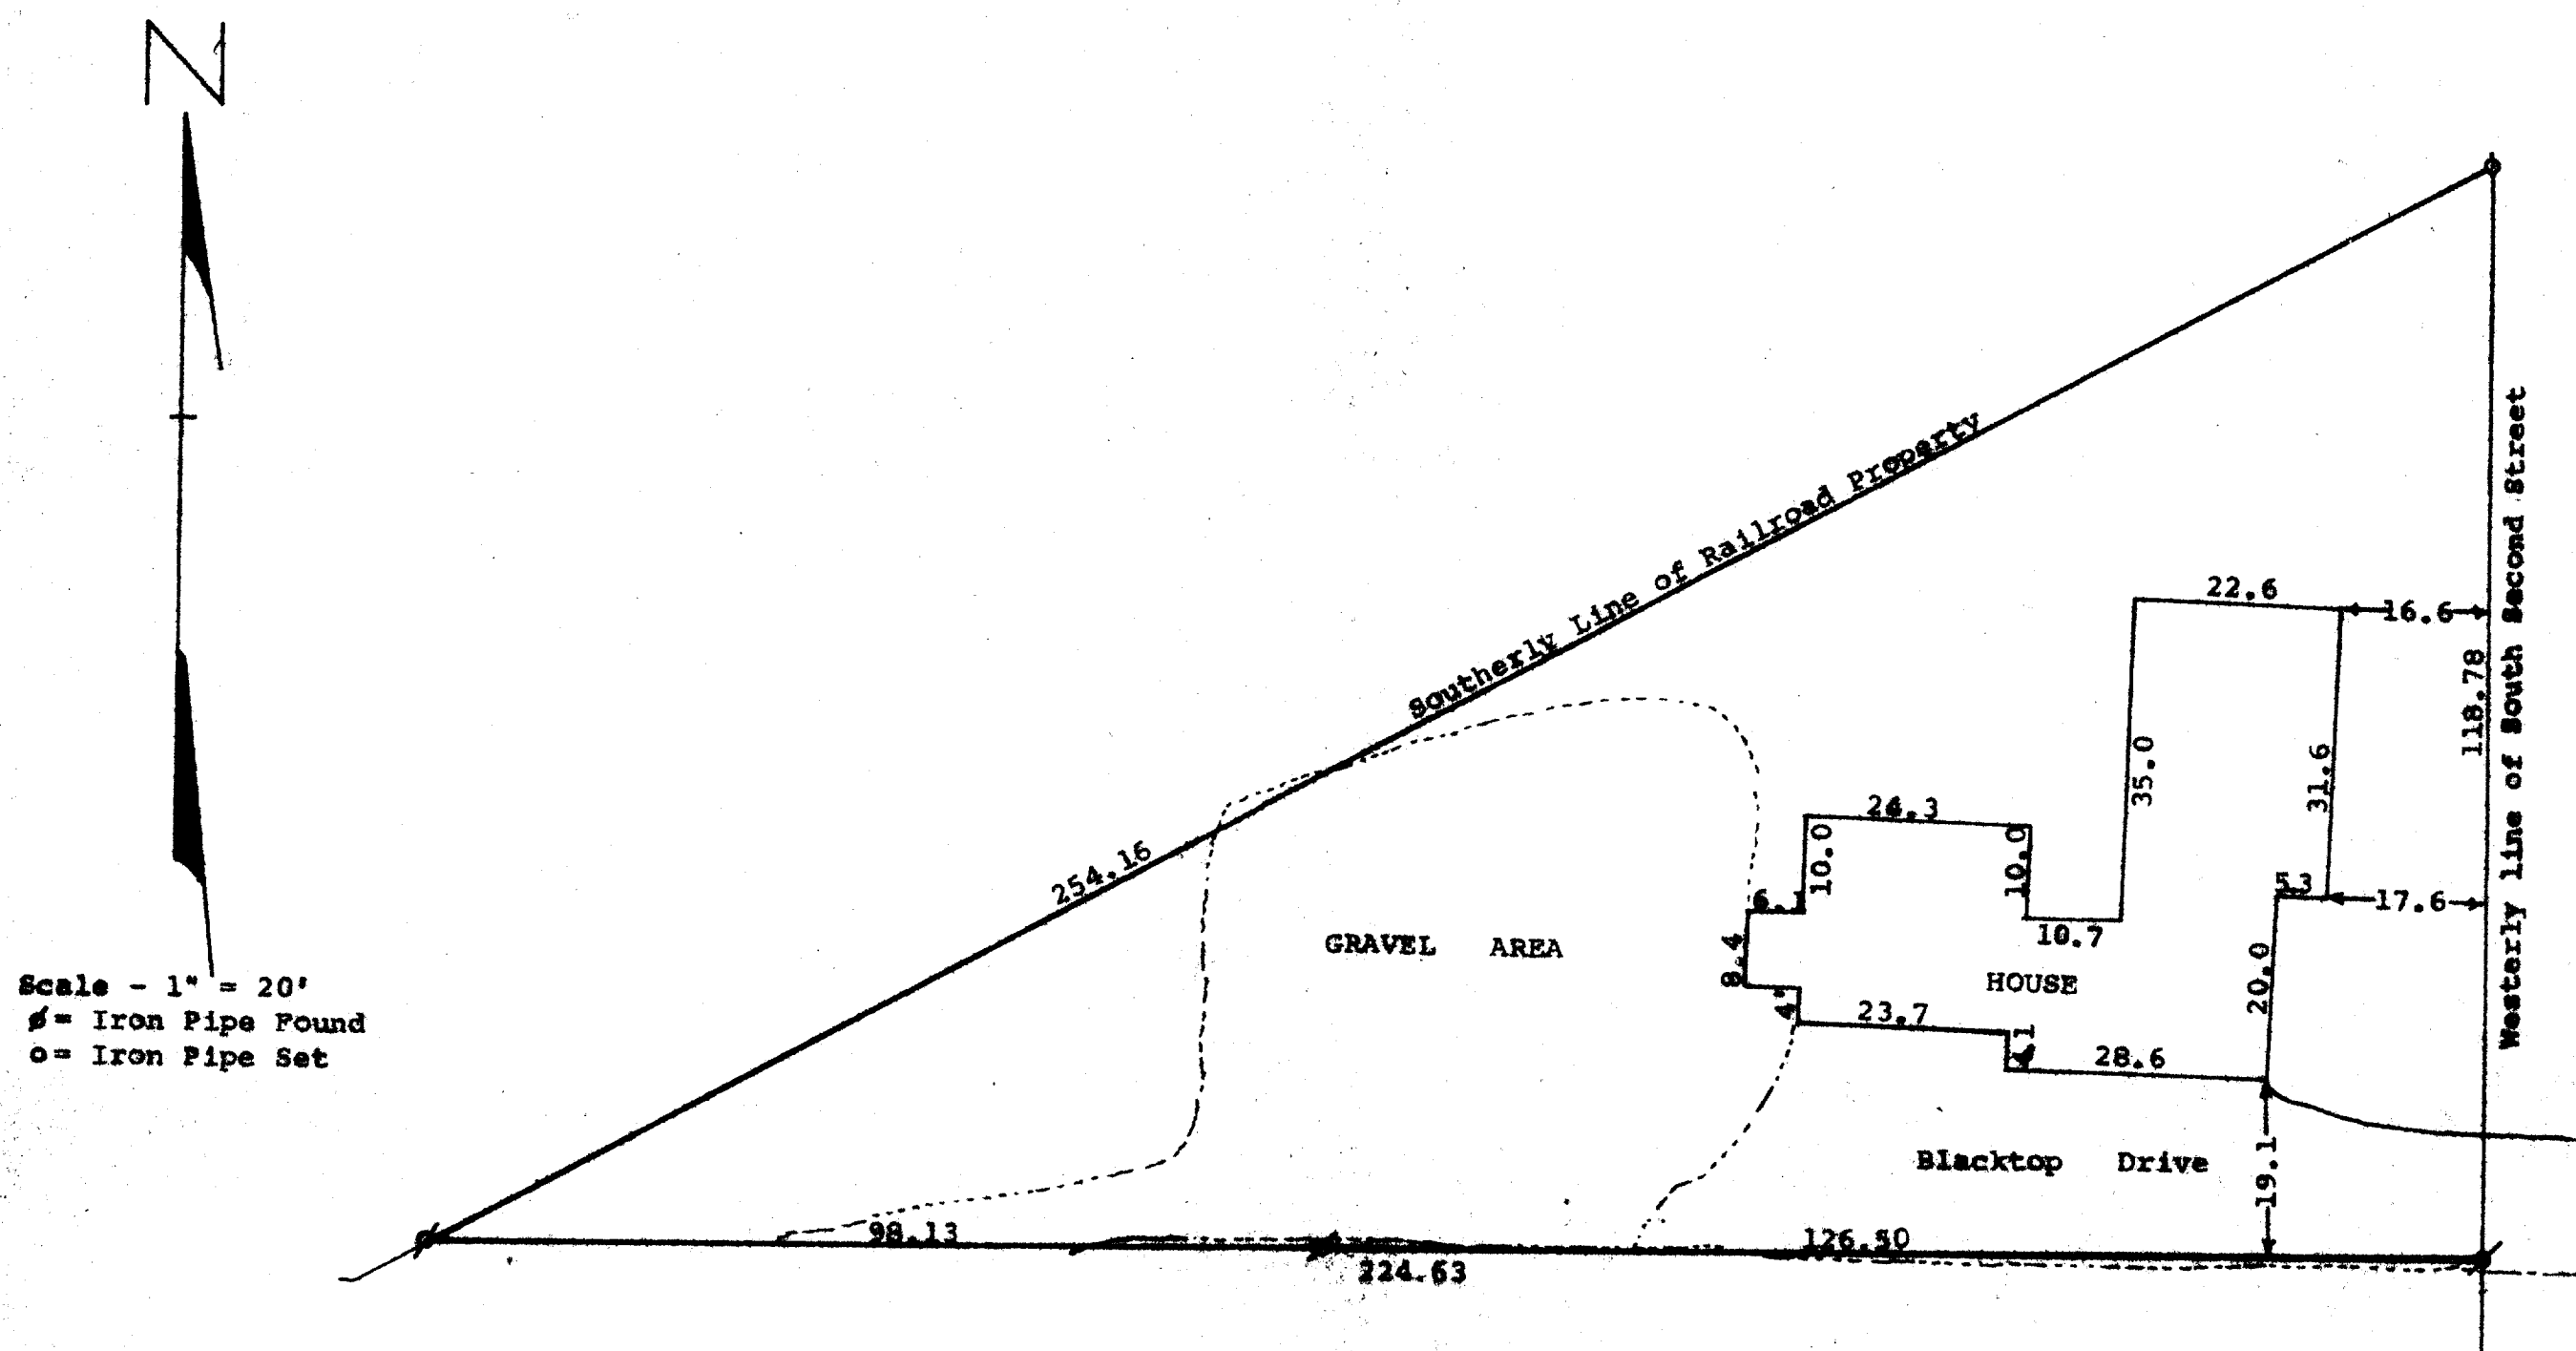

STATE OF WISCONSIN)
COUNTY OF WALWORTH) SS

I, James M. Dunham, Surveyor, certify that I have surveyed the property described as follows,

A triangular piece of real estate located on South Second Street, in the City of Delavan, said real estate being bounded on the South by land of M. D. Barnhart, on the East by Second Street aforesaid, and on the Northwest by right of way of the Chicago, Milwaukee and St. Paul Railway Company, being further described as beginning at the intersection of the west side of Second Street in said City of Delavan with the north side of the Chicago, Milwaukee and St. Paul right of way; thence South along the west side of said Second Street a distance of 118.78 feet (described as 7 rods); thence West at right angles to said Second Street 224.63 feet to said railway right of way; thence Northeastly along the south side of said railway right of way, 254.16 feet to the place of beginning, in the City of Delavan, Walworth County, Wisconsin,

and that the above map is a true representation thereof and shows the size and location of the property, its exterior boundaries, the location of all visible structures and dimensions of all principal buildings thereon, boundary fences, apparent easements, roadways and visible encroachments, if any. This survey is made for the use of the present owners of the property, and also those who purchase, mortgage, or guarantee the title thereto within one (1) year from date hereof.

June 27, 1980

James M. Dunham
James M. Dunham, Surveyor

