


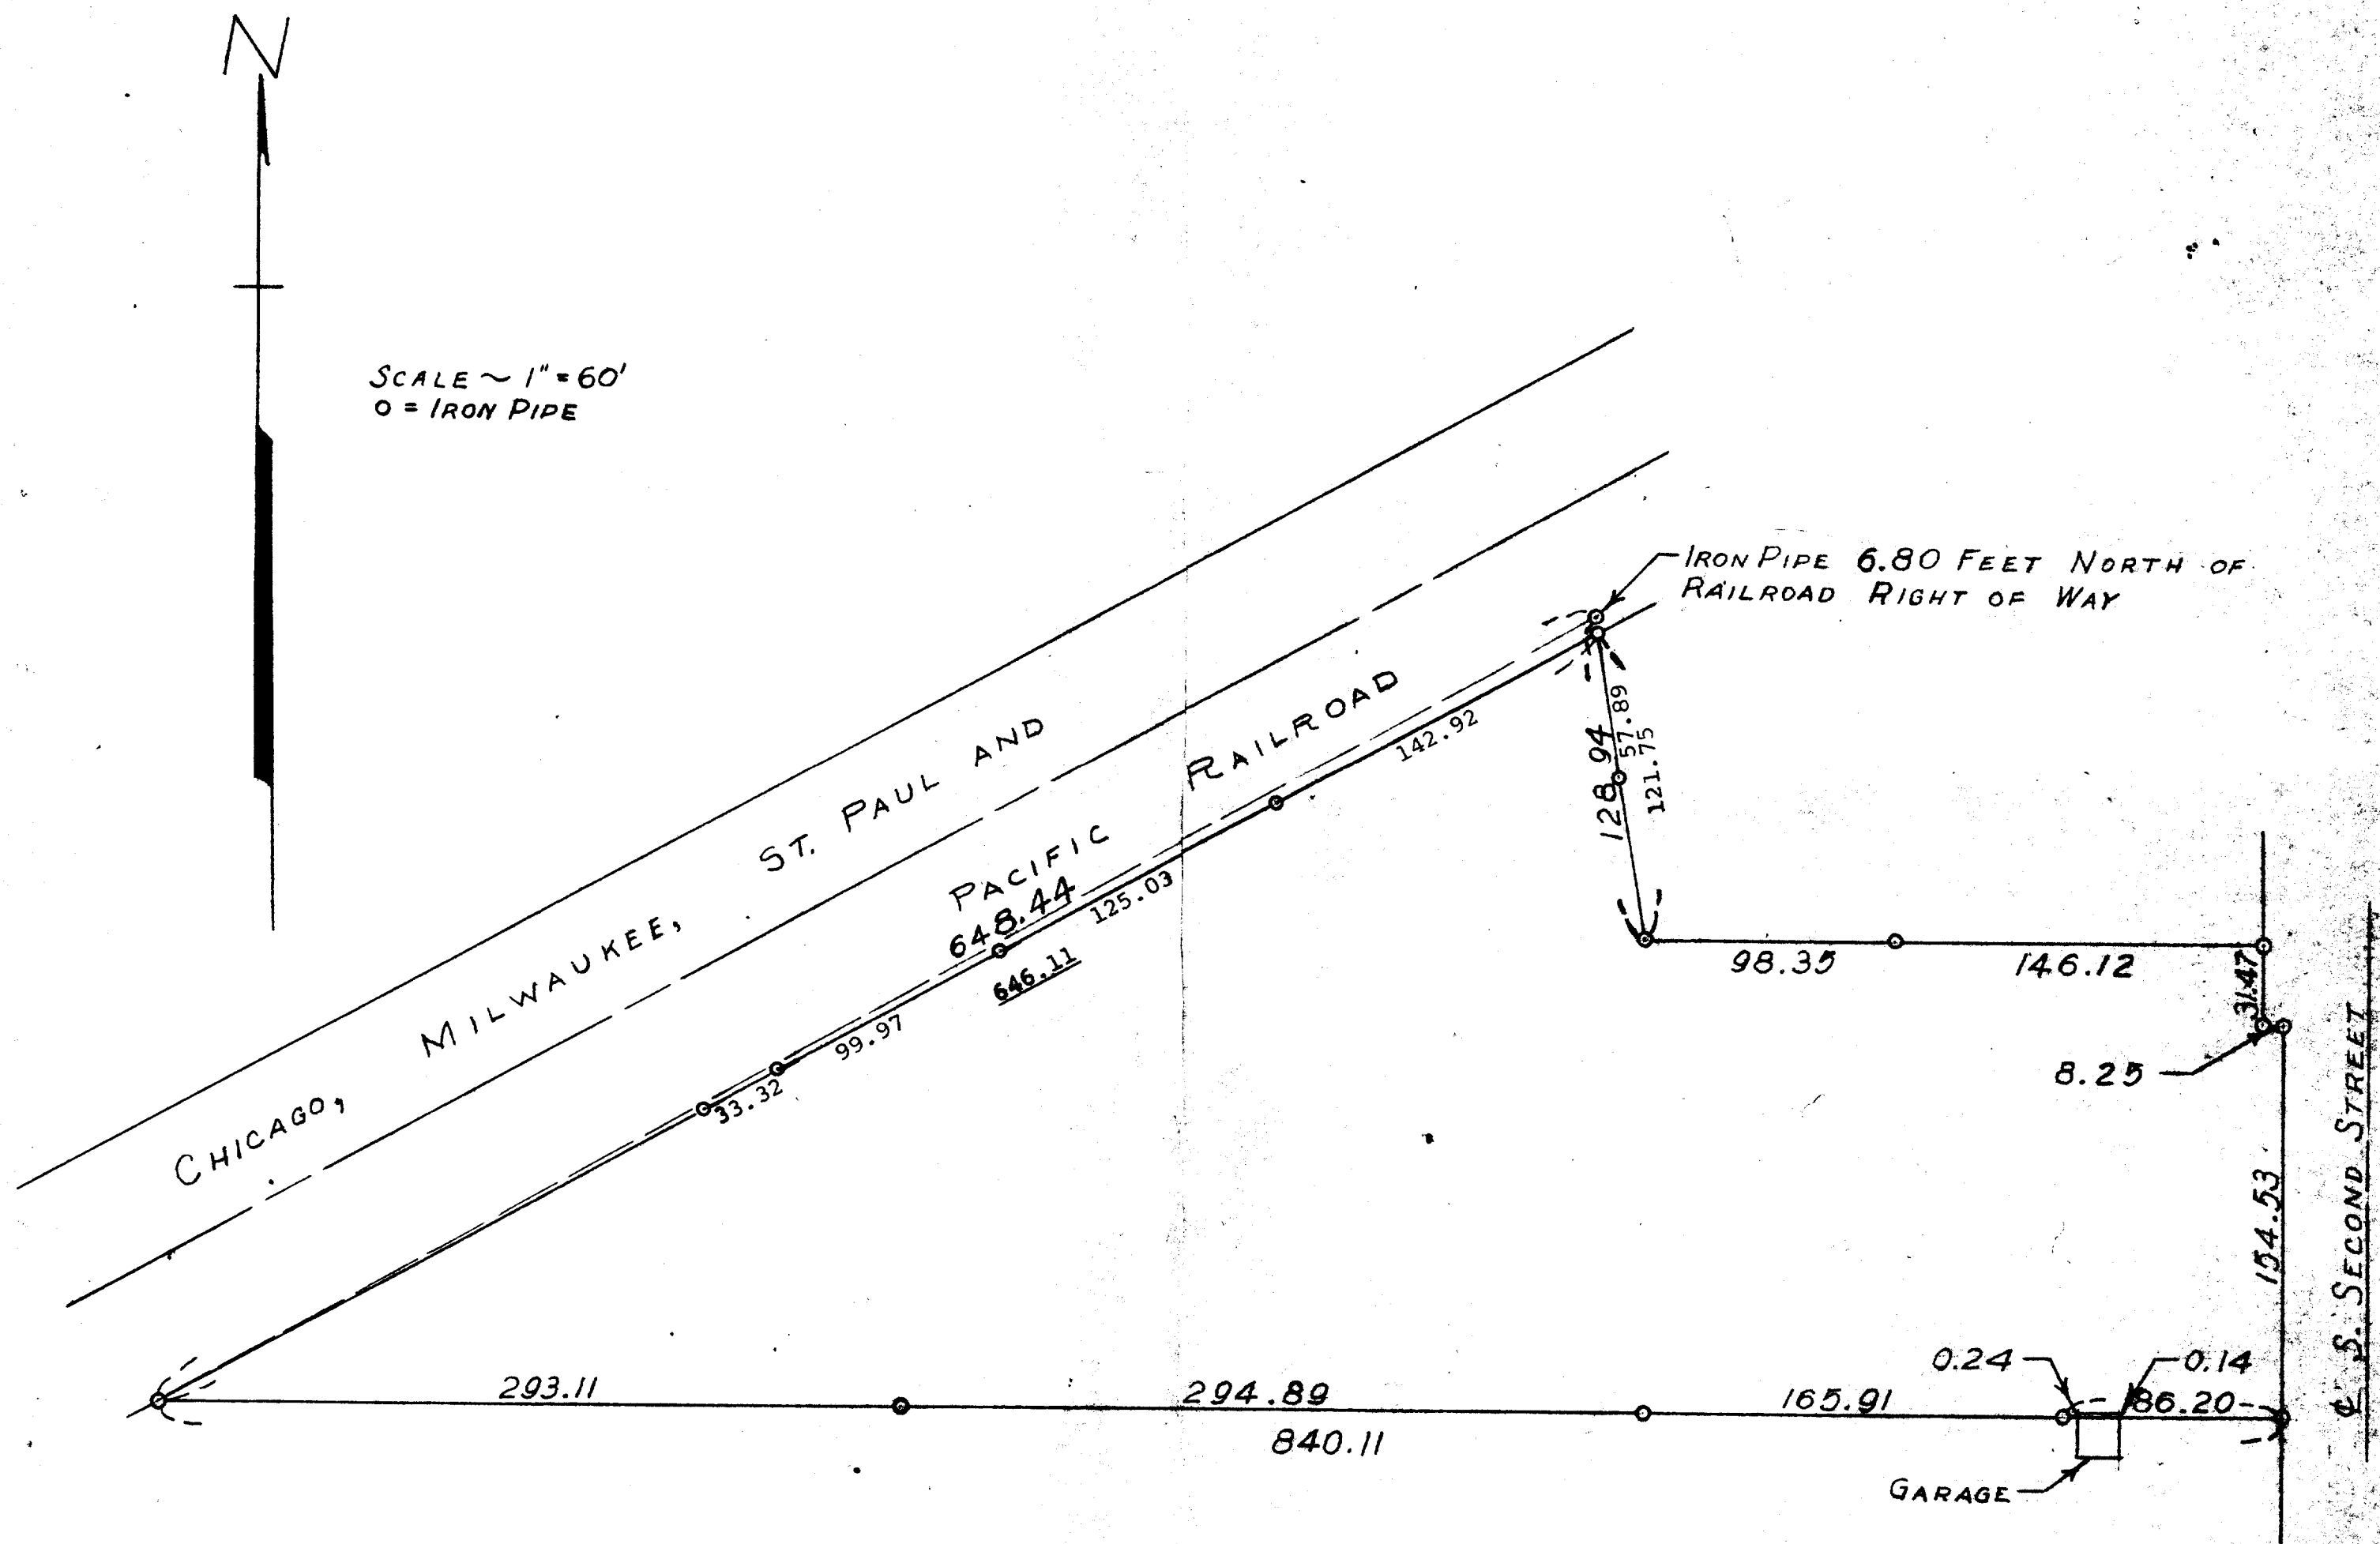

PLAT OF SURVEY OF A PARCEL OF LAND LOCATED IN THE SOUTH 1/2
 OF SECTION 18 AND IN THE NORTH 1/2 OF SECTION 19, T2N R16E, CITY OF
 DELAVAN, WALWORTH COUNTY, WISCONSIN
 JULY, 1956
 Revised June 23, 1965

George F. Dunham
 GEORGE F. DUNHAM, SURVEYOR
 DELAVAN, WISCONSIN

2-62