


PLAT OF SURVEY

OF PART OF THE NE 1/4 OF SEC. 18, T.2N., R.14E.,
CITY OF DELAWARE, WALWORTH COUNTY, WISCONSIN.

DESCRIPTION: Lots 17, 18, and 19 of Block 9 and the East 2.5 feet of Lot 19 of Block 9
of the Original Plat of the Village of Delaware.

This survey of West line of above description only.

PREPARED FOR: DELAWARE HOUSE, INC.
DELAWARE, WIS.

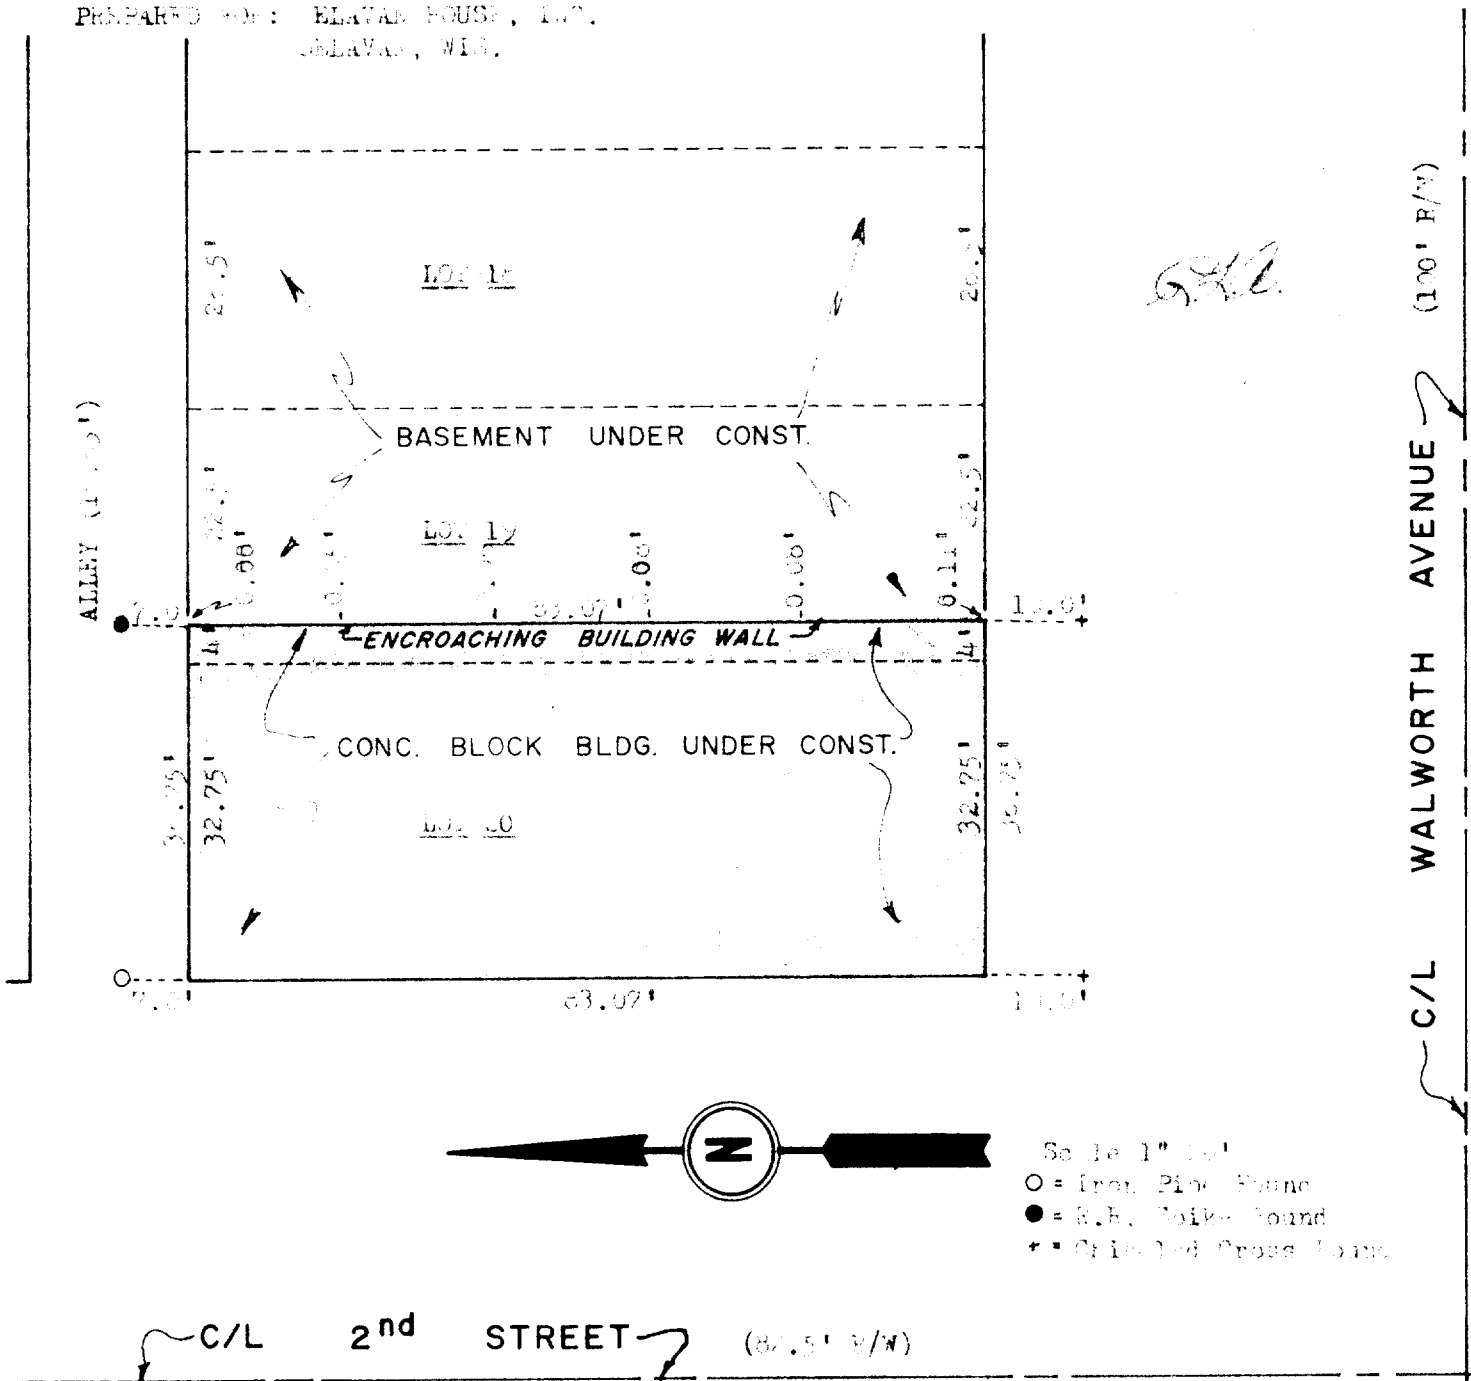

SURVEYOR'S CERTIFICATE: I, Ralph L. Anderson, hereby certify that I have surveyed the
above described property and that the above map is a true representation thereof and
shows the size and location of the property, its exterior boundaries, and the location
of all visible structures. This survey is made for the use of the present owners of the
property, and also those who purchase, mortgage, or guarantee the same thereto within
one (1) year from date hereof.

Date 1 October 1979

Ralph L. Anderson
Ralph L. Anderson R.L.S. 1827

2-629 Vol. 80, 1075