


PARISH

STREET

STREET

NORTH FIFTH

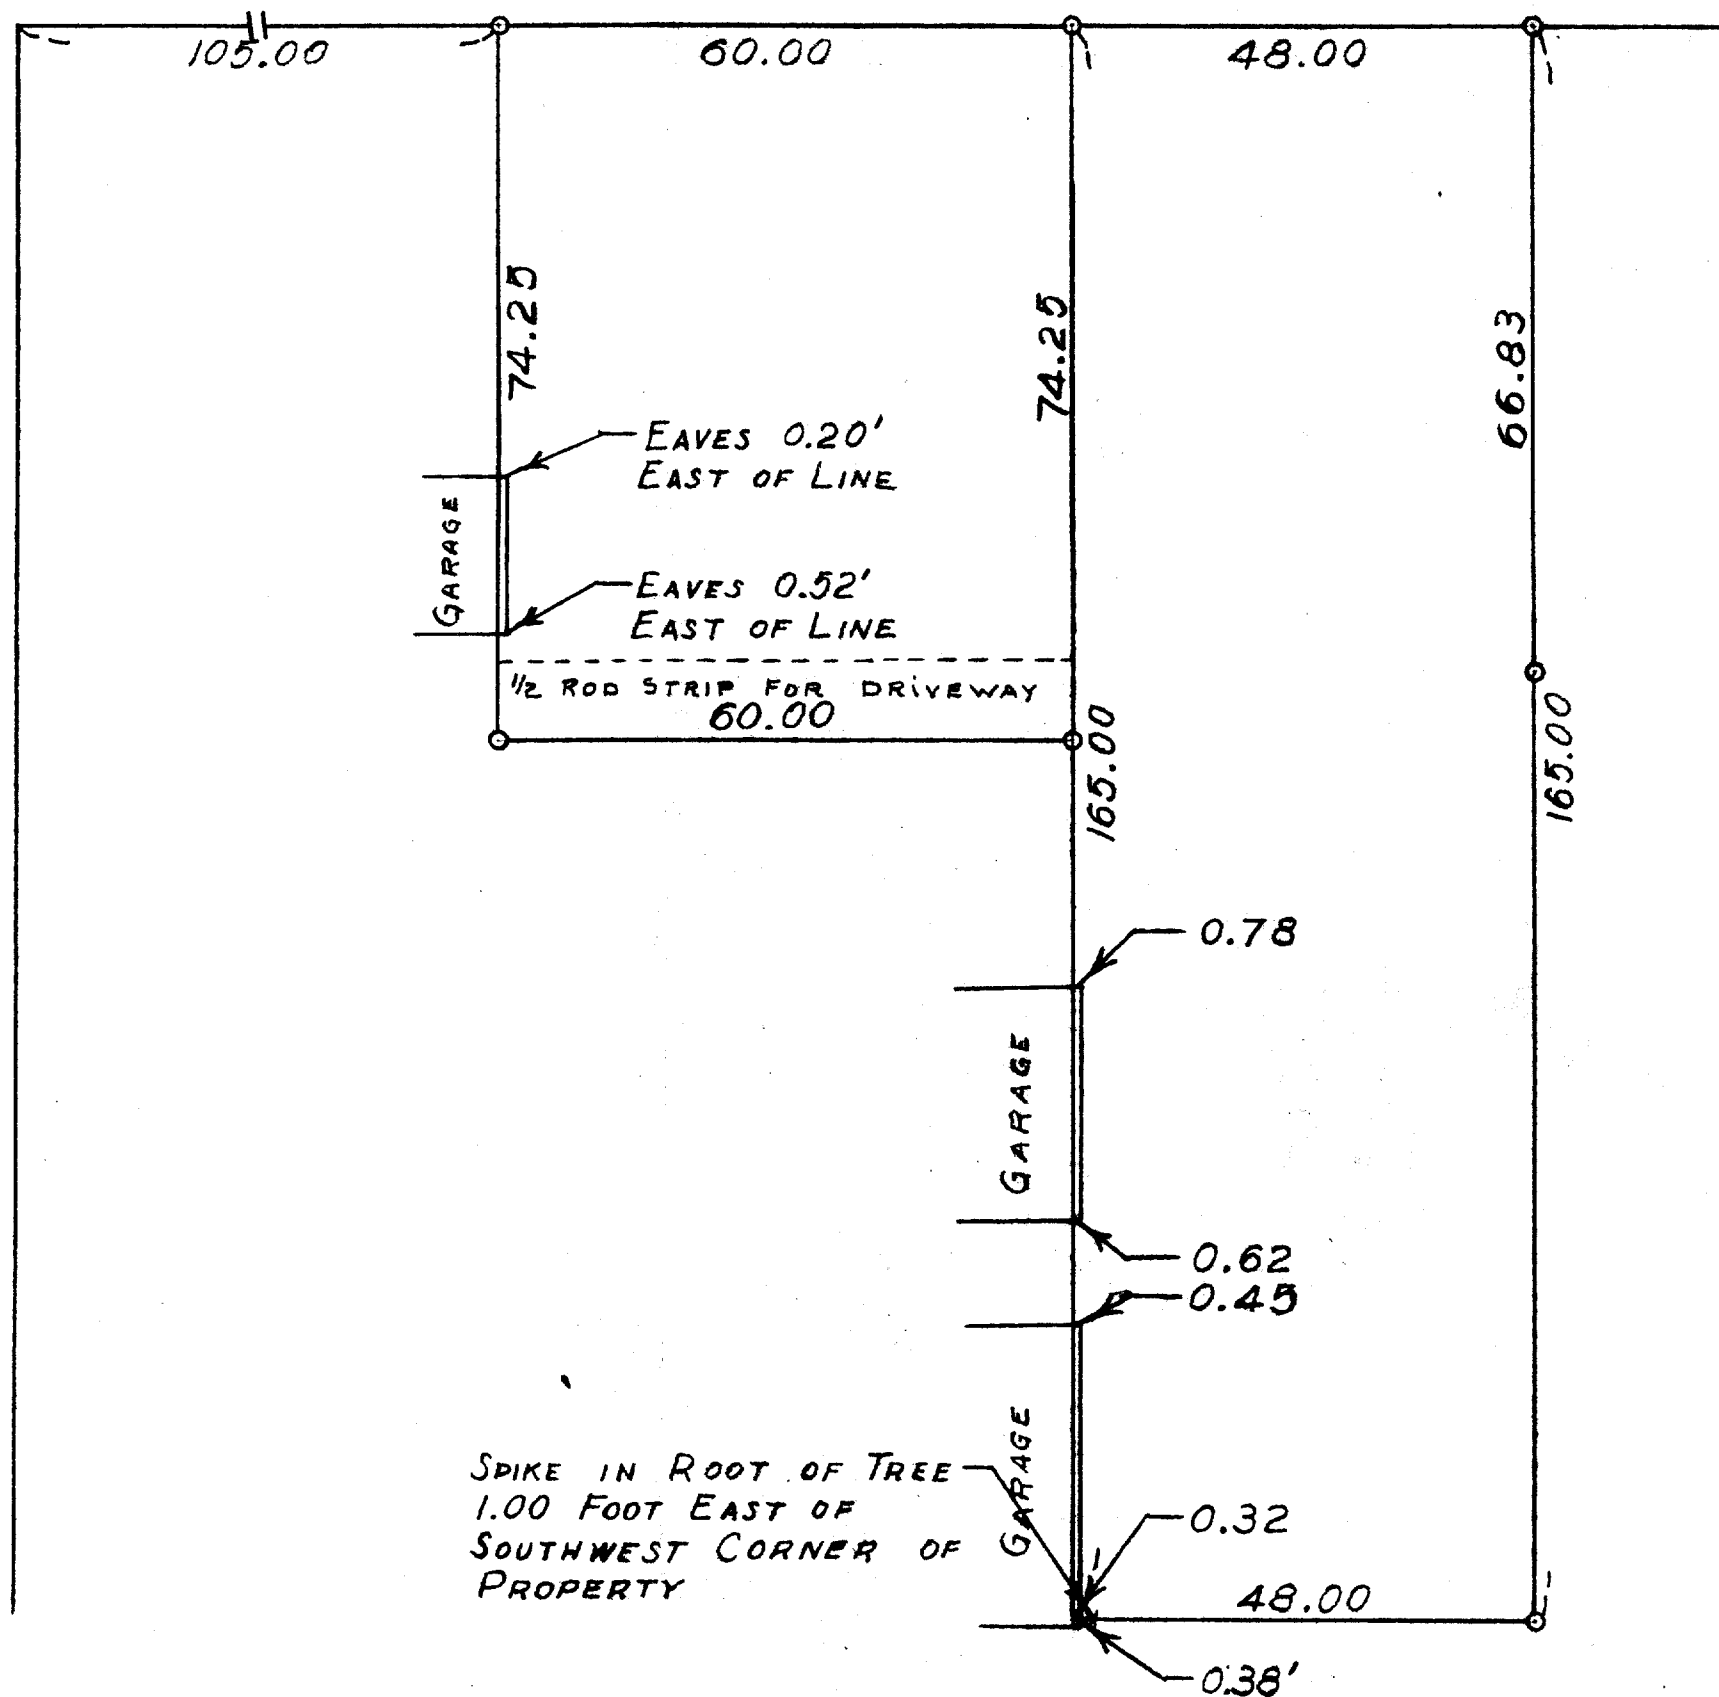

N

SCALE ~ 1" = 20'
O = IRON PIPE

PLAT OF SURVEY OF A PARCEL OF LAND LOCATED IN THE NORTHEAST
1/4 OF SECTION 18, T2N R16E, CITY OF DELAVAN, WALWORTH COUNTY,
WISCONSIN
JUNE, 1956

George F. Dunham
GEORGE F. DUNHAM, SURVEYOR
DELAVER, WISCONSIN

2-63