


DUNHAM SURVEYING, S.C.  
SURVEYING & ENGINEERING  
DELAVER, WISCONSIN 53115

Scale - 1" = 20'

- = Iron Pipe
- = Utility Pole
- - - = Fence Line
- = Tree Greater Than 8" Diameter

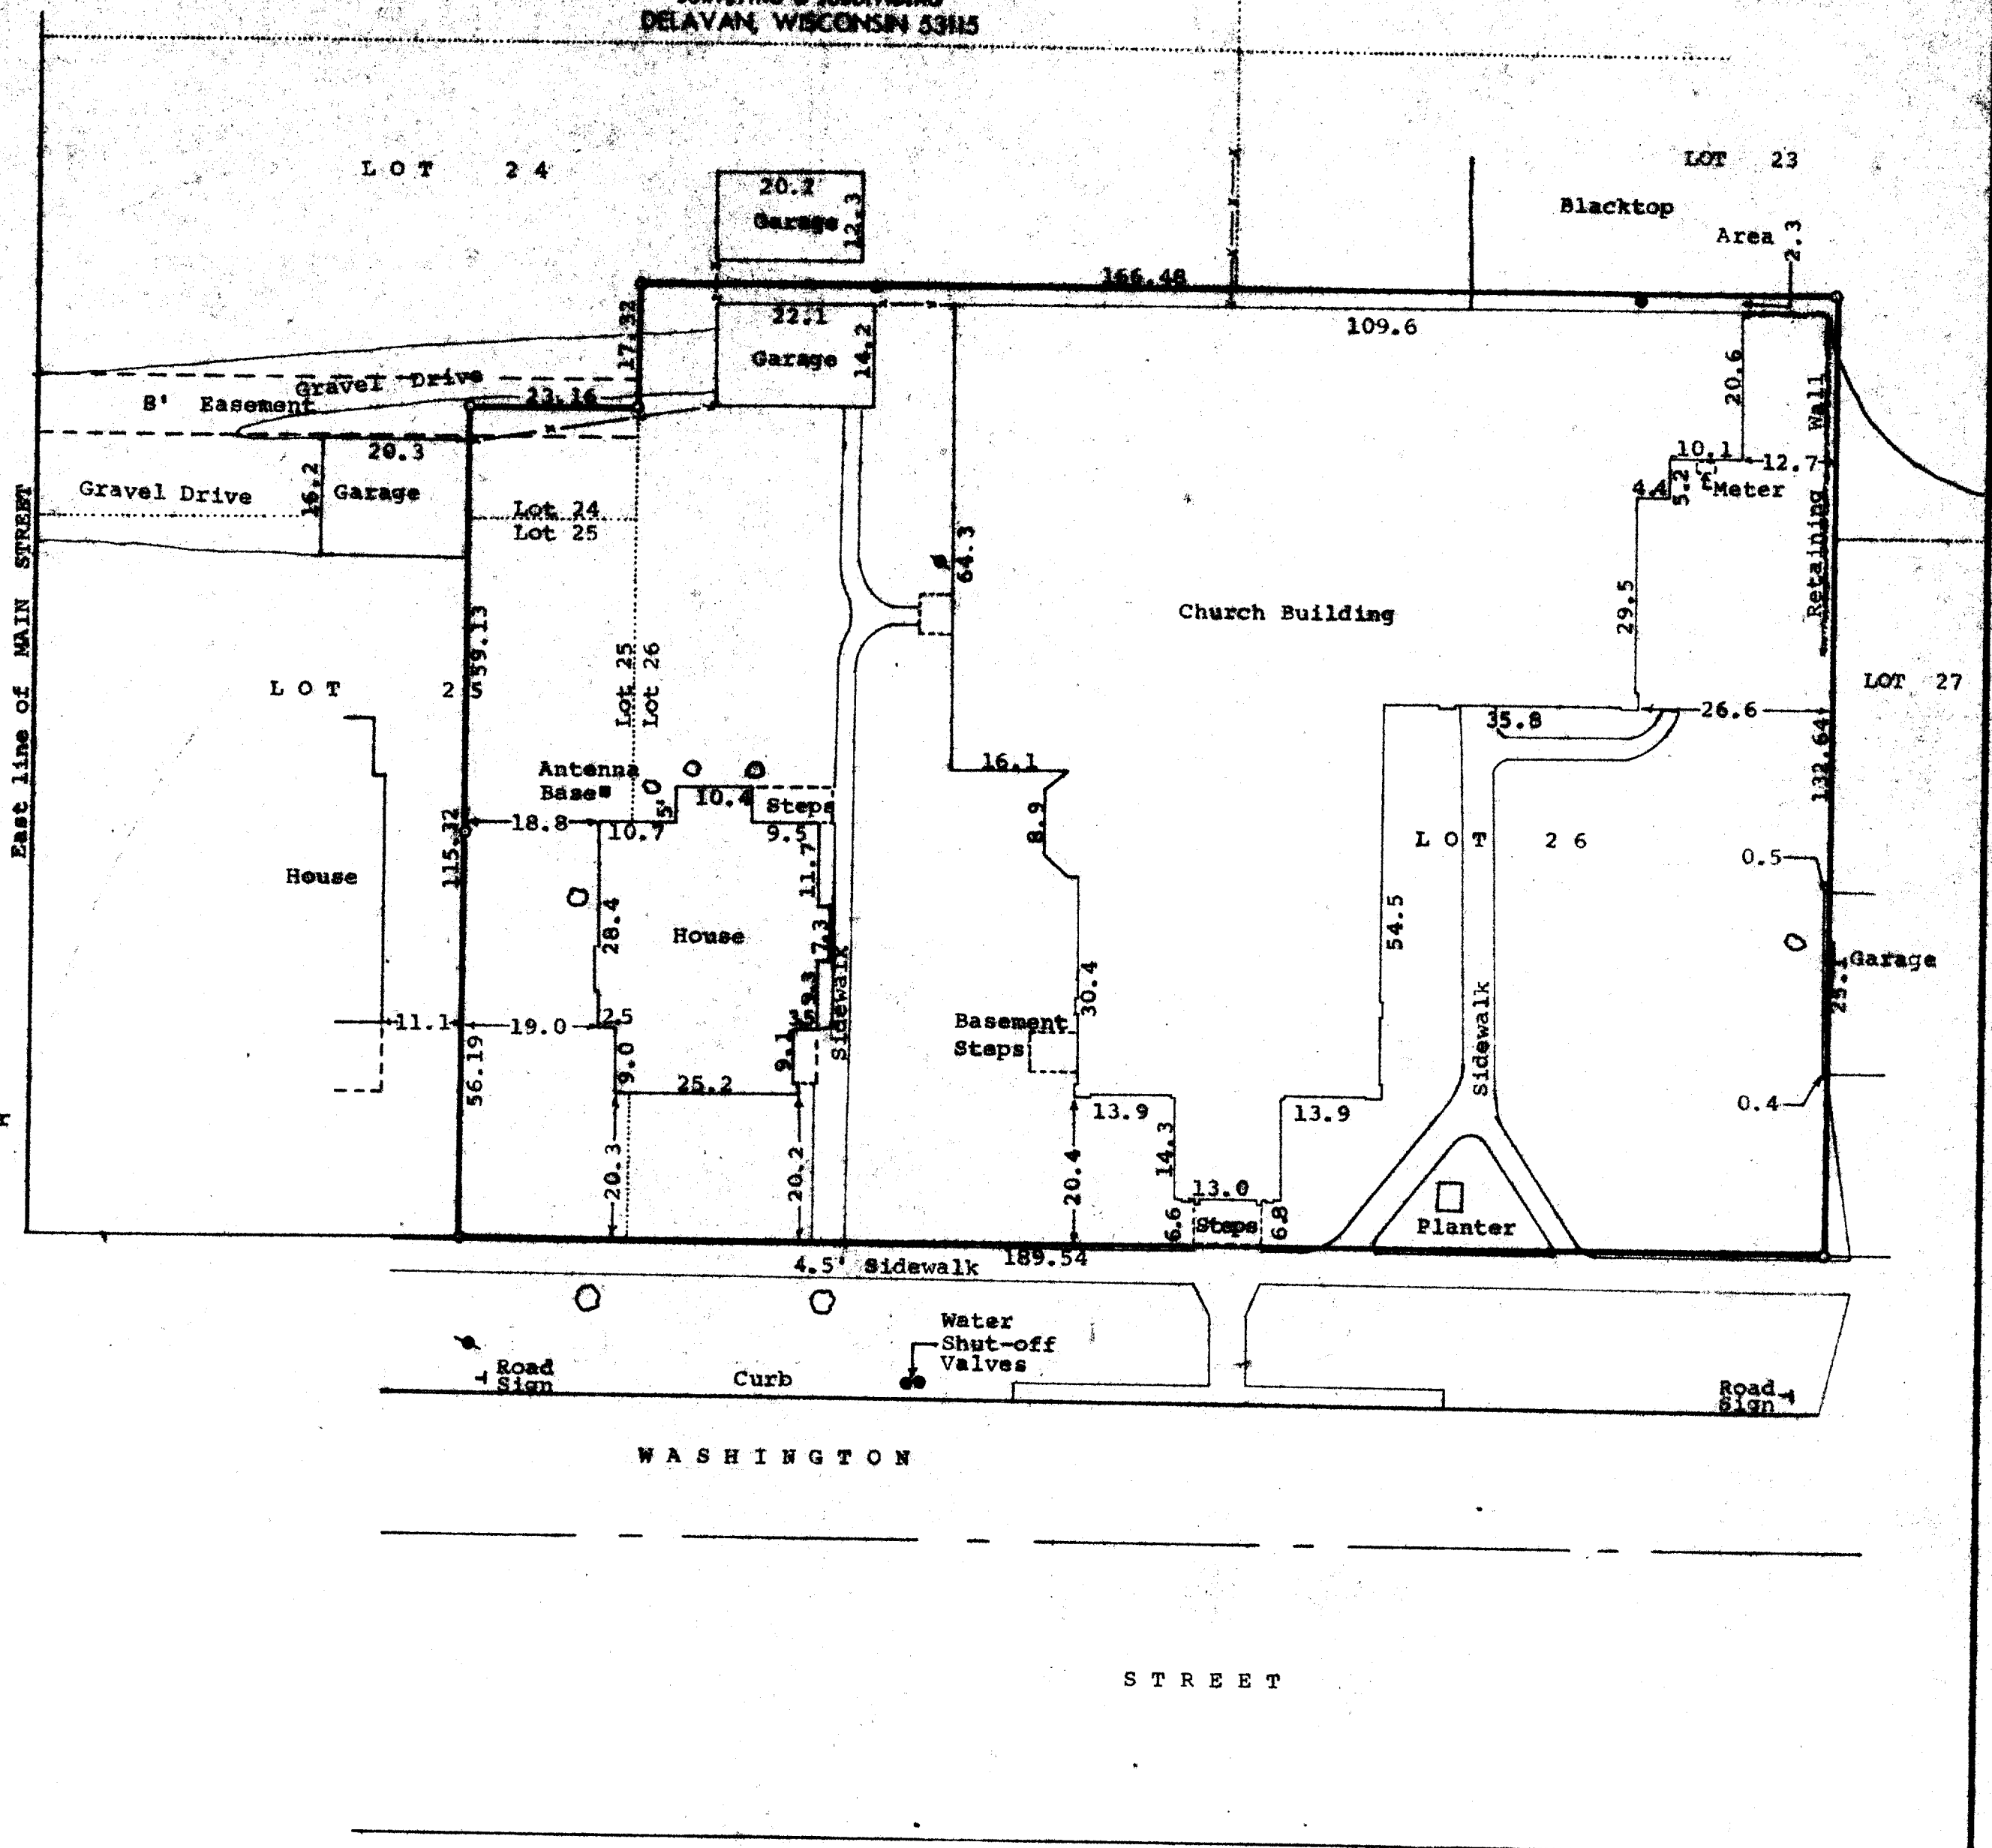

Plat of survey of property owned by the United Church of Christ-Congregational, located in Lot 26 and part of Lots 24 and 25, Block 13 of the Original Plat of the Village (now City) of Delavan, Walworth County, Wisconsin.  
August 3, 1979

*James M. Dunham*  
James M. Dunham, Surveyor

