


DUNHAM SURVEYING, S.C.
SURVEYING & SUBDIVIDING
DELAVER, WISCONSIN 53115

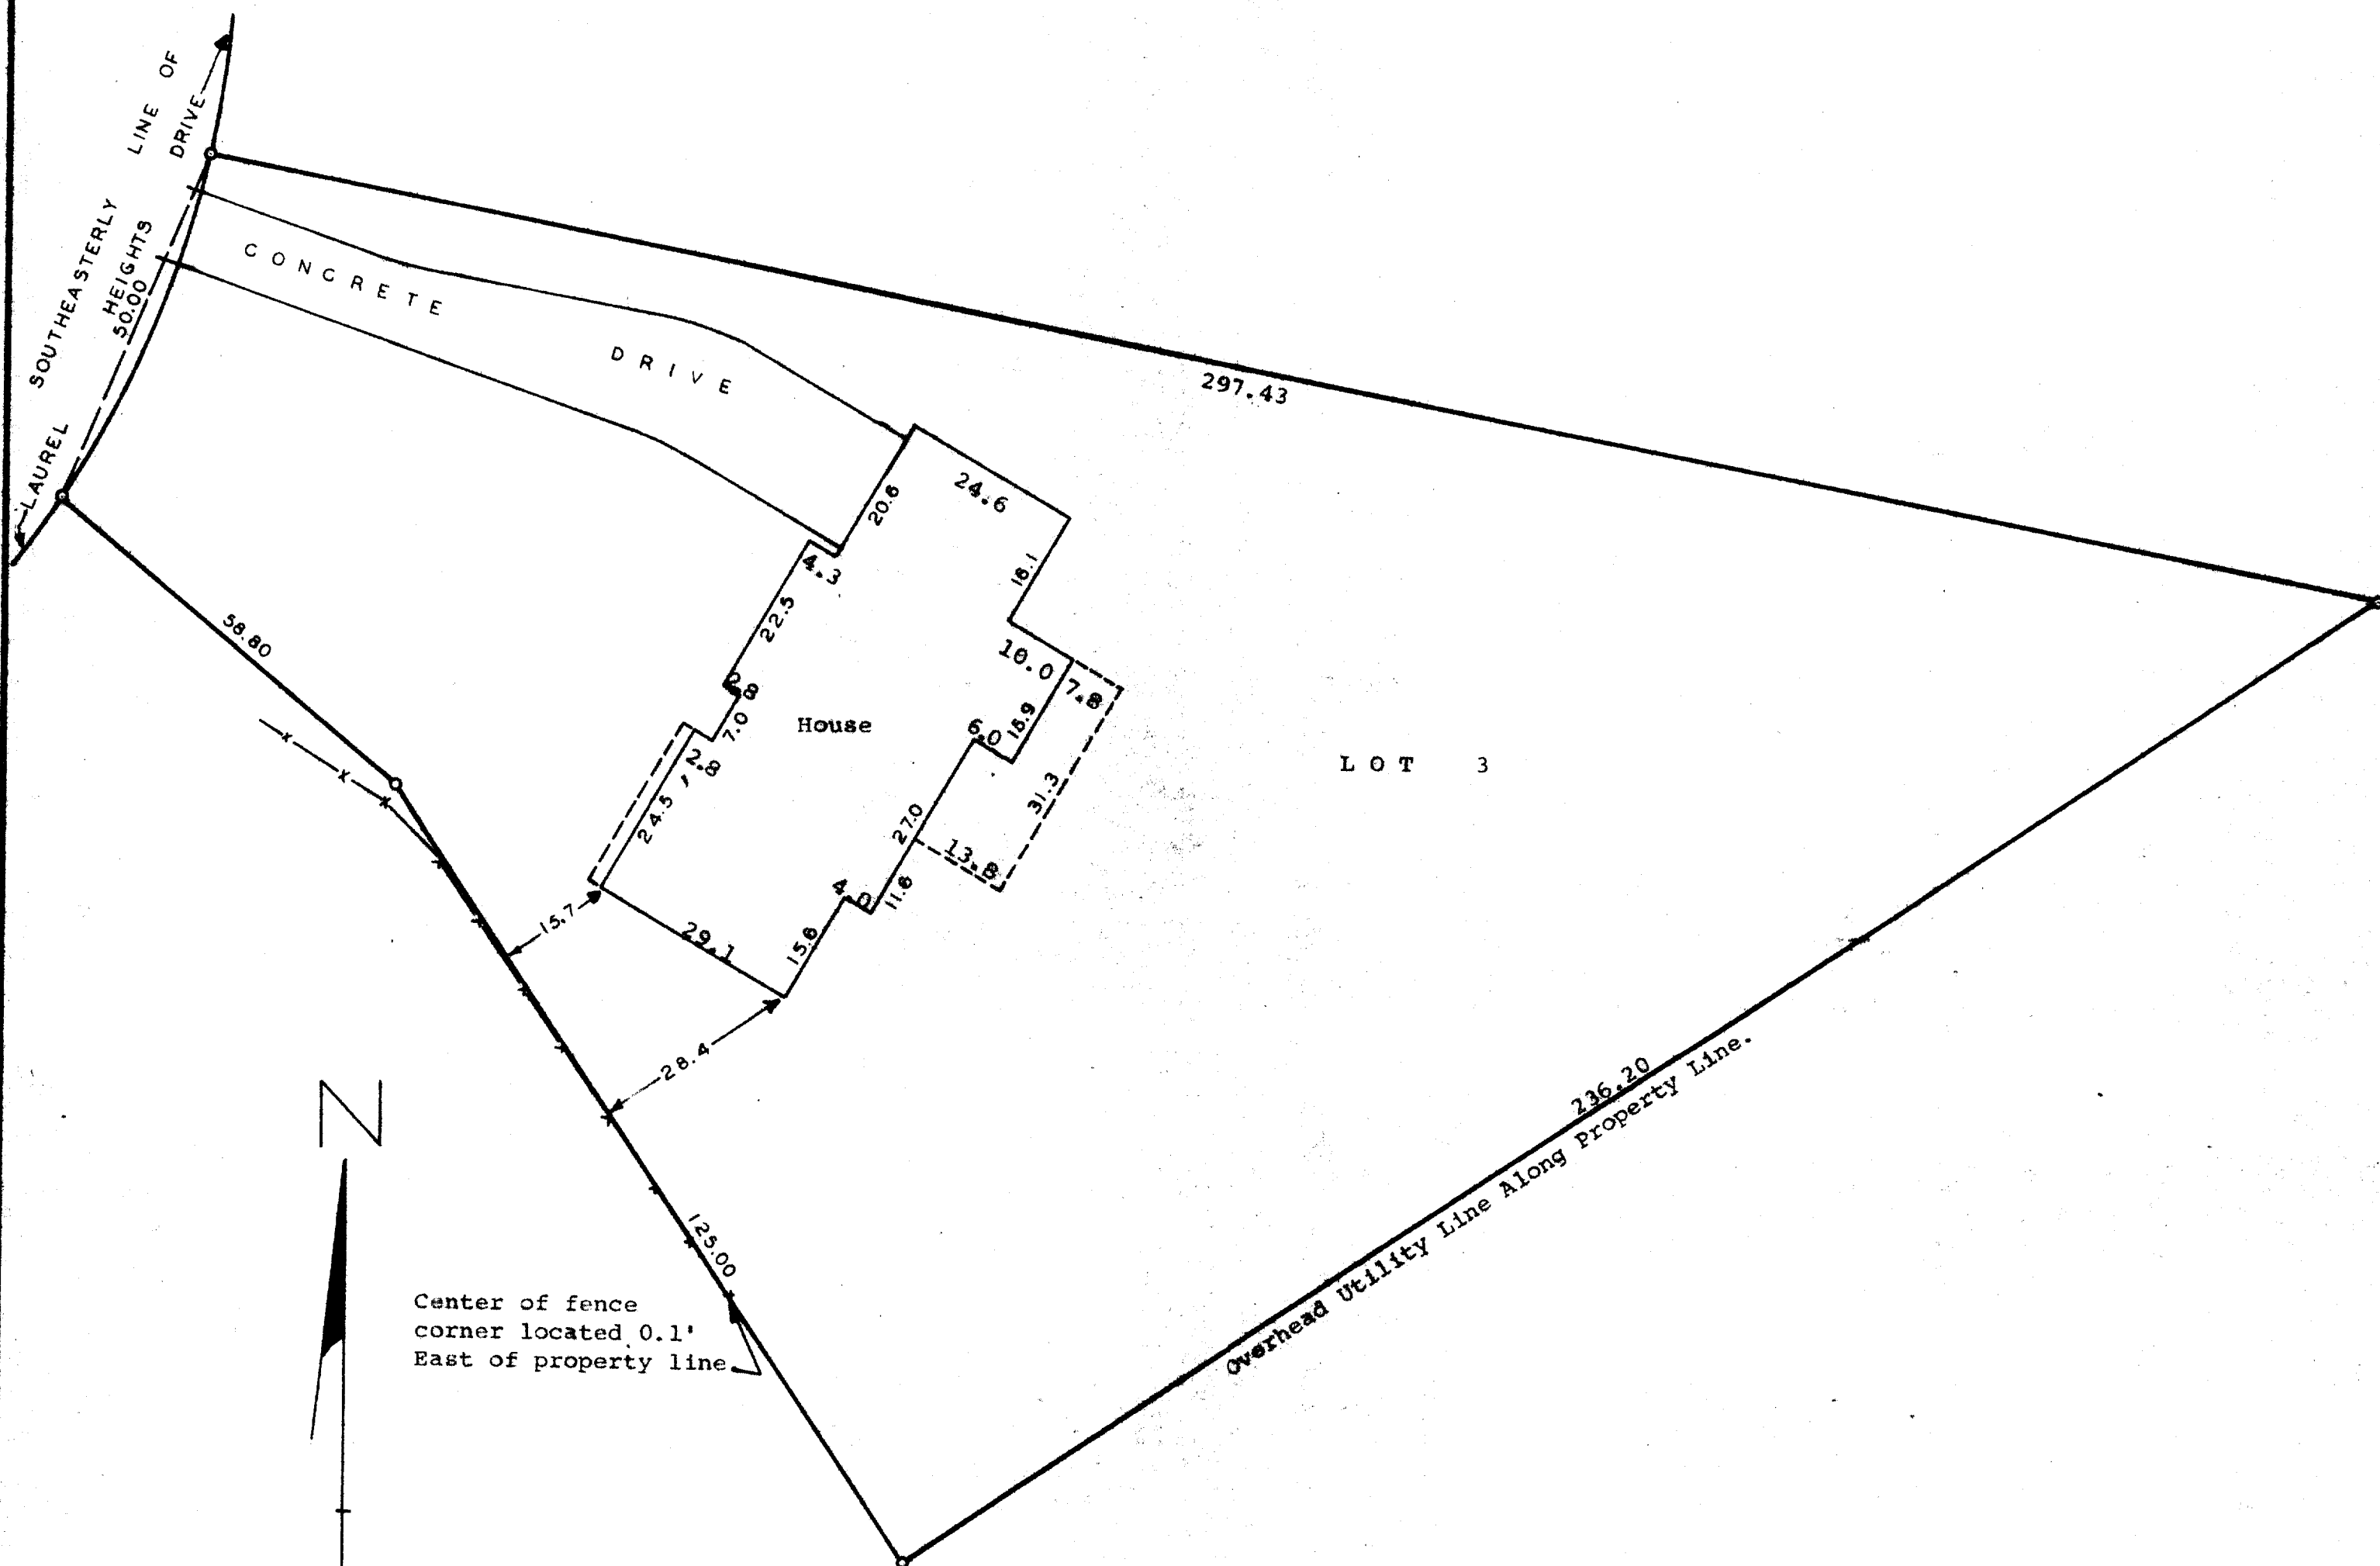

Center of fence
corner located 0.1'
East of property line

STATE OF WISCONSIN)
COUNTY OF WALWORTH) SS


I, James M. Dunham, Surveyor, certify that I have surveyed the
property described as follows,

Lot 3 of Laurel Heights, a subdivision located in the City
of Delavan, Walworth County, Wisconsin,

and that the above map is a true representation thereof and shows the
size and location of the property, its exterior boundaries, the location
of all visible structures and dimensions of all principal buildings thereon,
boundary fences, apparent easements, roadways and visible encroachments,
if any.

This survey is made for the use of the present owners of the property,
and also those who purchase, mortgage, or guarantee the title thereto
within one (1) year from date hereof.
November 2, 1979

James M. Dunham
James M. Dunham, Surveyor

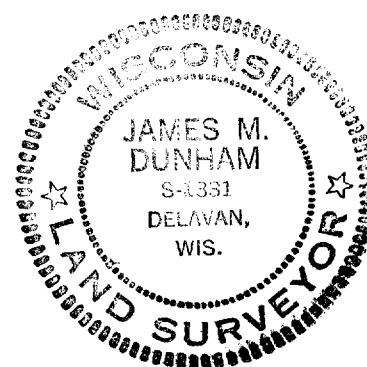

Scale - 1" = 20'
O = Iron Pipe
x-x-x = Fence Line