


DUNHAM SURVEYING, S.C.
SURVEYING & SUBDIVISION
DELAVER, WISCONSIN 53115

THIRD

STREET

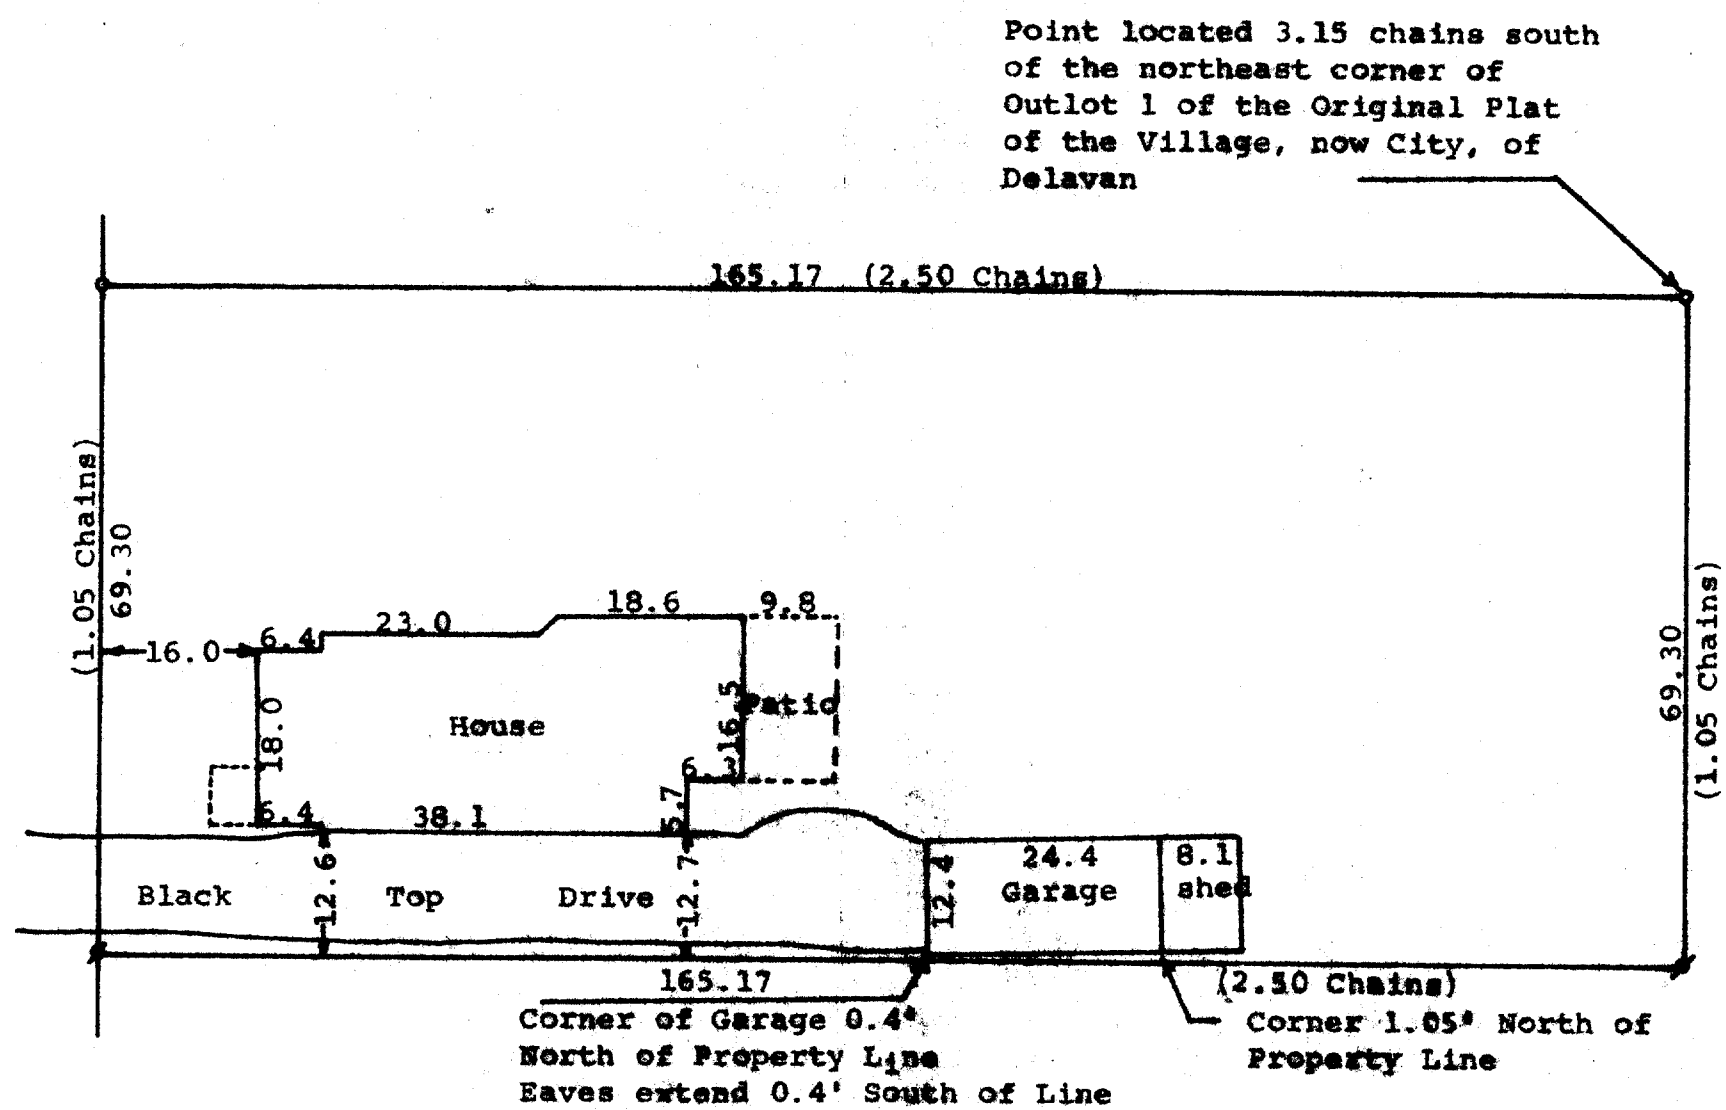

Scale - 1" = 20'
= Iron Pipe Found
• = Iron Pipe Set
(0.00) = Recorded Distance

STATE OF WISCONSIN)
COUNTY OF WALWORTH) SS

I, George T. Dunham, Surveyor, certify that I have surveyed the property described as follows:

A parcel of land located in Outlot 1 of the Original Plat of the Village, now City, of Delavan, Walworth County, Wisconsin, described as follows: Commencing on the east line of Outlot 1 of the Original Plat of the Village, now City, of Delavan, at a point 3.15 chains south of the northeast corner of said Outlot, thence south on said east line 1.05 chains, thence west 2.50 chains to the east line of 3rd Street in said City of Delavan, thence north along the east line of said 3rd Street 1.05 chains, thence east to the place of beginning.

and that the above map is a true representation thereof and shows the size and location of the property, its exterior boundaries, the location of all visible structures and dimensions of all principal buildings thereon, boundary fences, apparent easements, roadways and visible encroachments, if any.

This survey is made for the use of the present owners of the property, and also those who purchase, mortgage, or guarantee the title thereto within one (1) year from date hereof.
May 18, 1981

George T. Dunham
George T. Dunham, Surveyor

