


DUNHAM SURVEYING, S. C.
 SURVEYING & SUBDIVIDING
 DELAVAN, WISCONSIN 53115

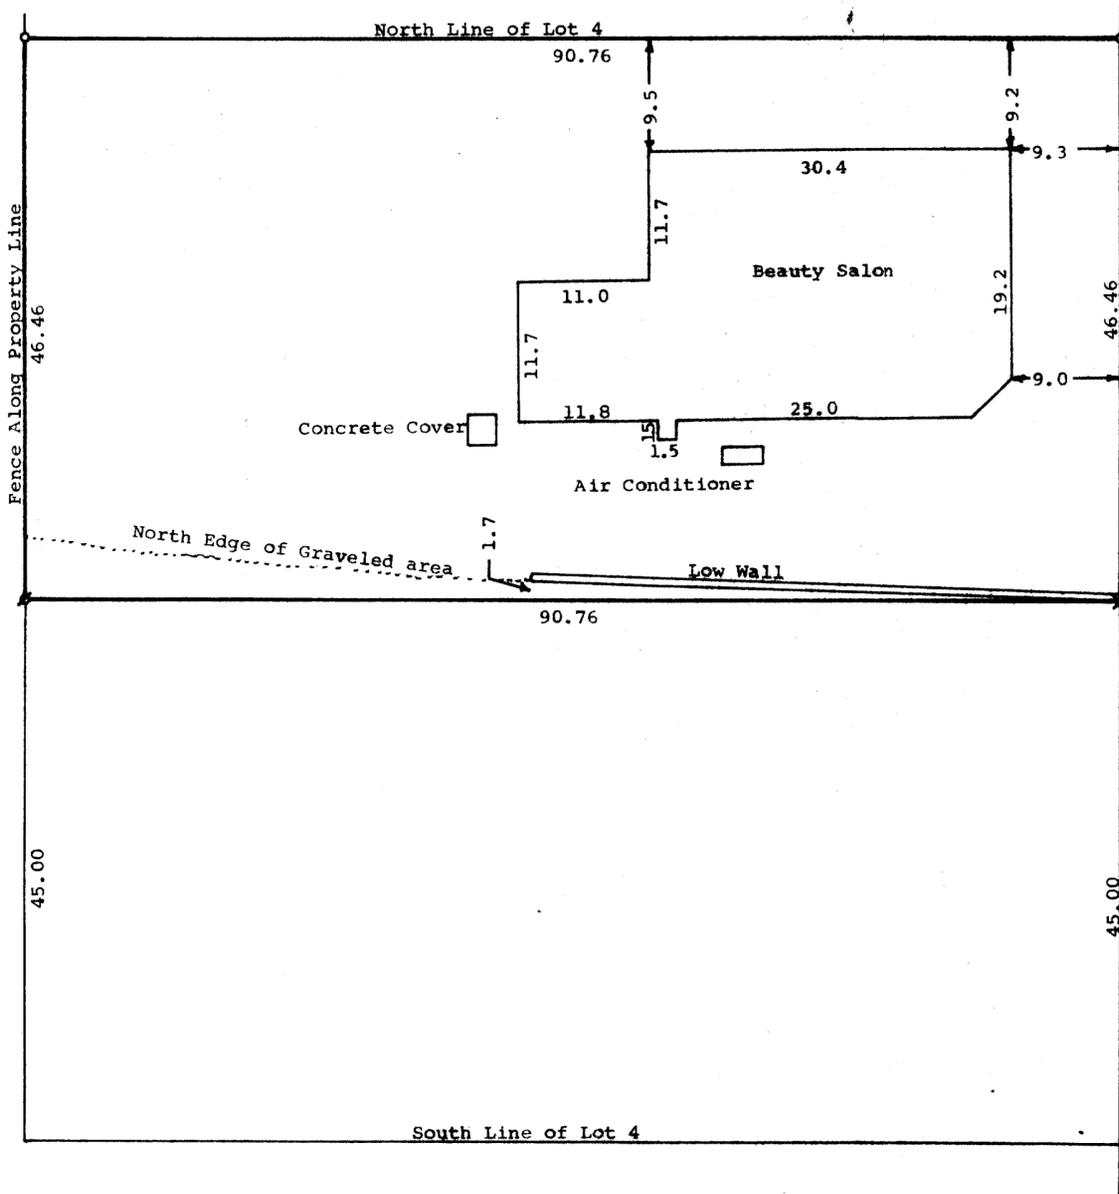

Street
 Second
 North
 of
 C.

STATE OF WISCONSIN) SS
 COUNTY OF WALWORTH)

I, James M. Dunham, Surveyor, certify that I have surveyed the property described as follows,
 Lot 4, Block 8, EXCEPT the South 45.00 feet thereof, in the Original Plat of the City of Delavan, Walworth County, Wisconsin,
 and that the above map is a true representation thereof and shows the size and location of the property, its exterior boundaries, the location of all visible structures and dimensions of all principal buildings thereon, boundary fences, apparent easements, roadways and visible encroachments, if any.
 This survey is made for the use of the present owners of the property, and also those who purchase, mortgage, or guarantee the title thereto within one (1) year from date hereof.
 November 2, 1979

James M. Dunham
 James M. Dunham, Surveyor



Scale - 1" = 10'
 ■ = Iron Pipe Found
 ○ = Iron Pipe Set
 X = Cross in Concrete