


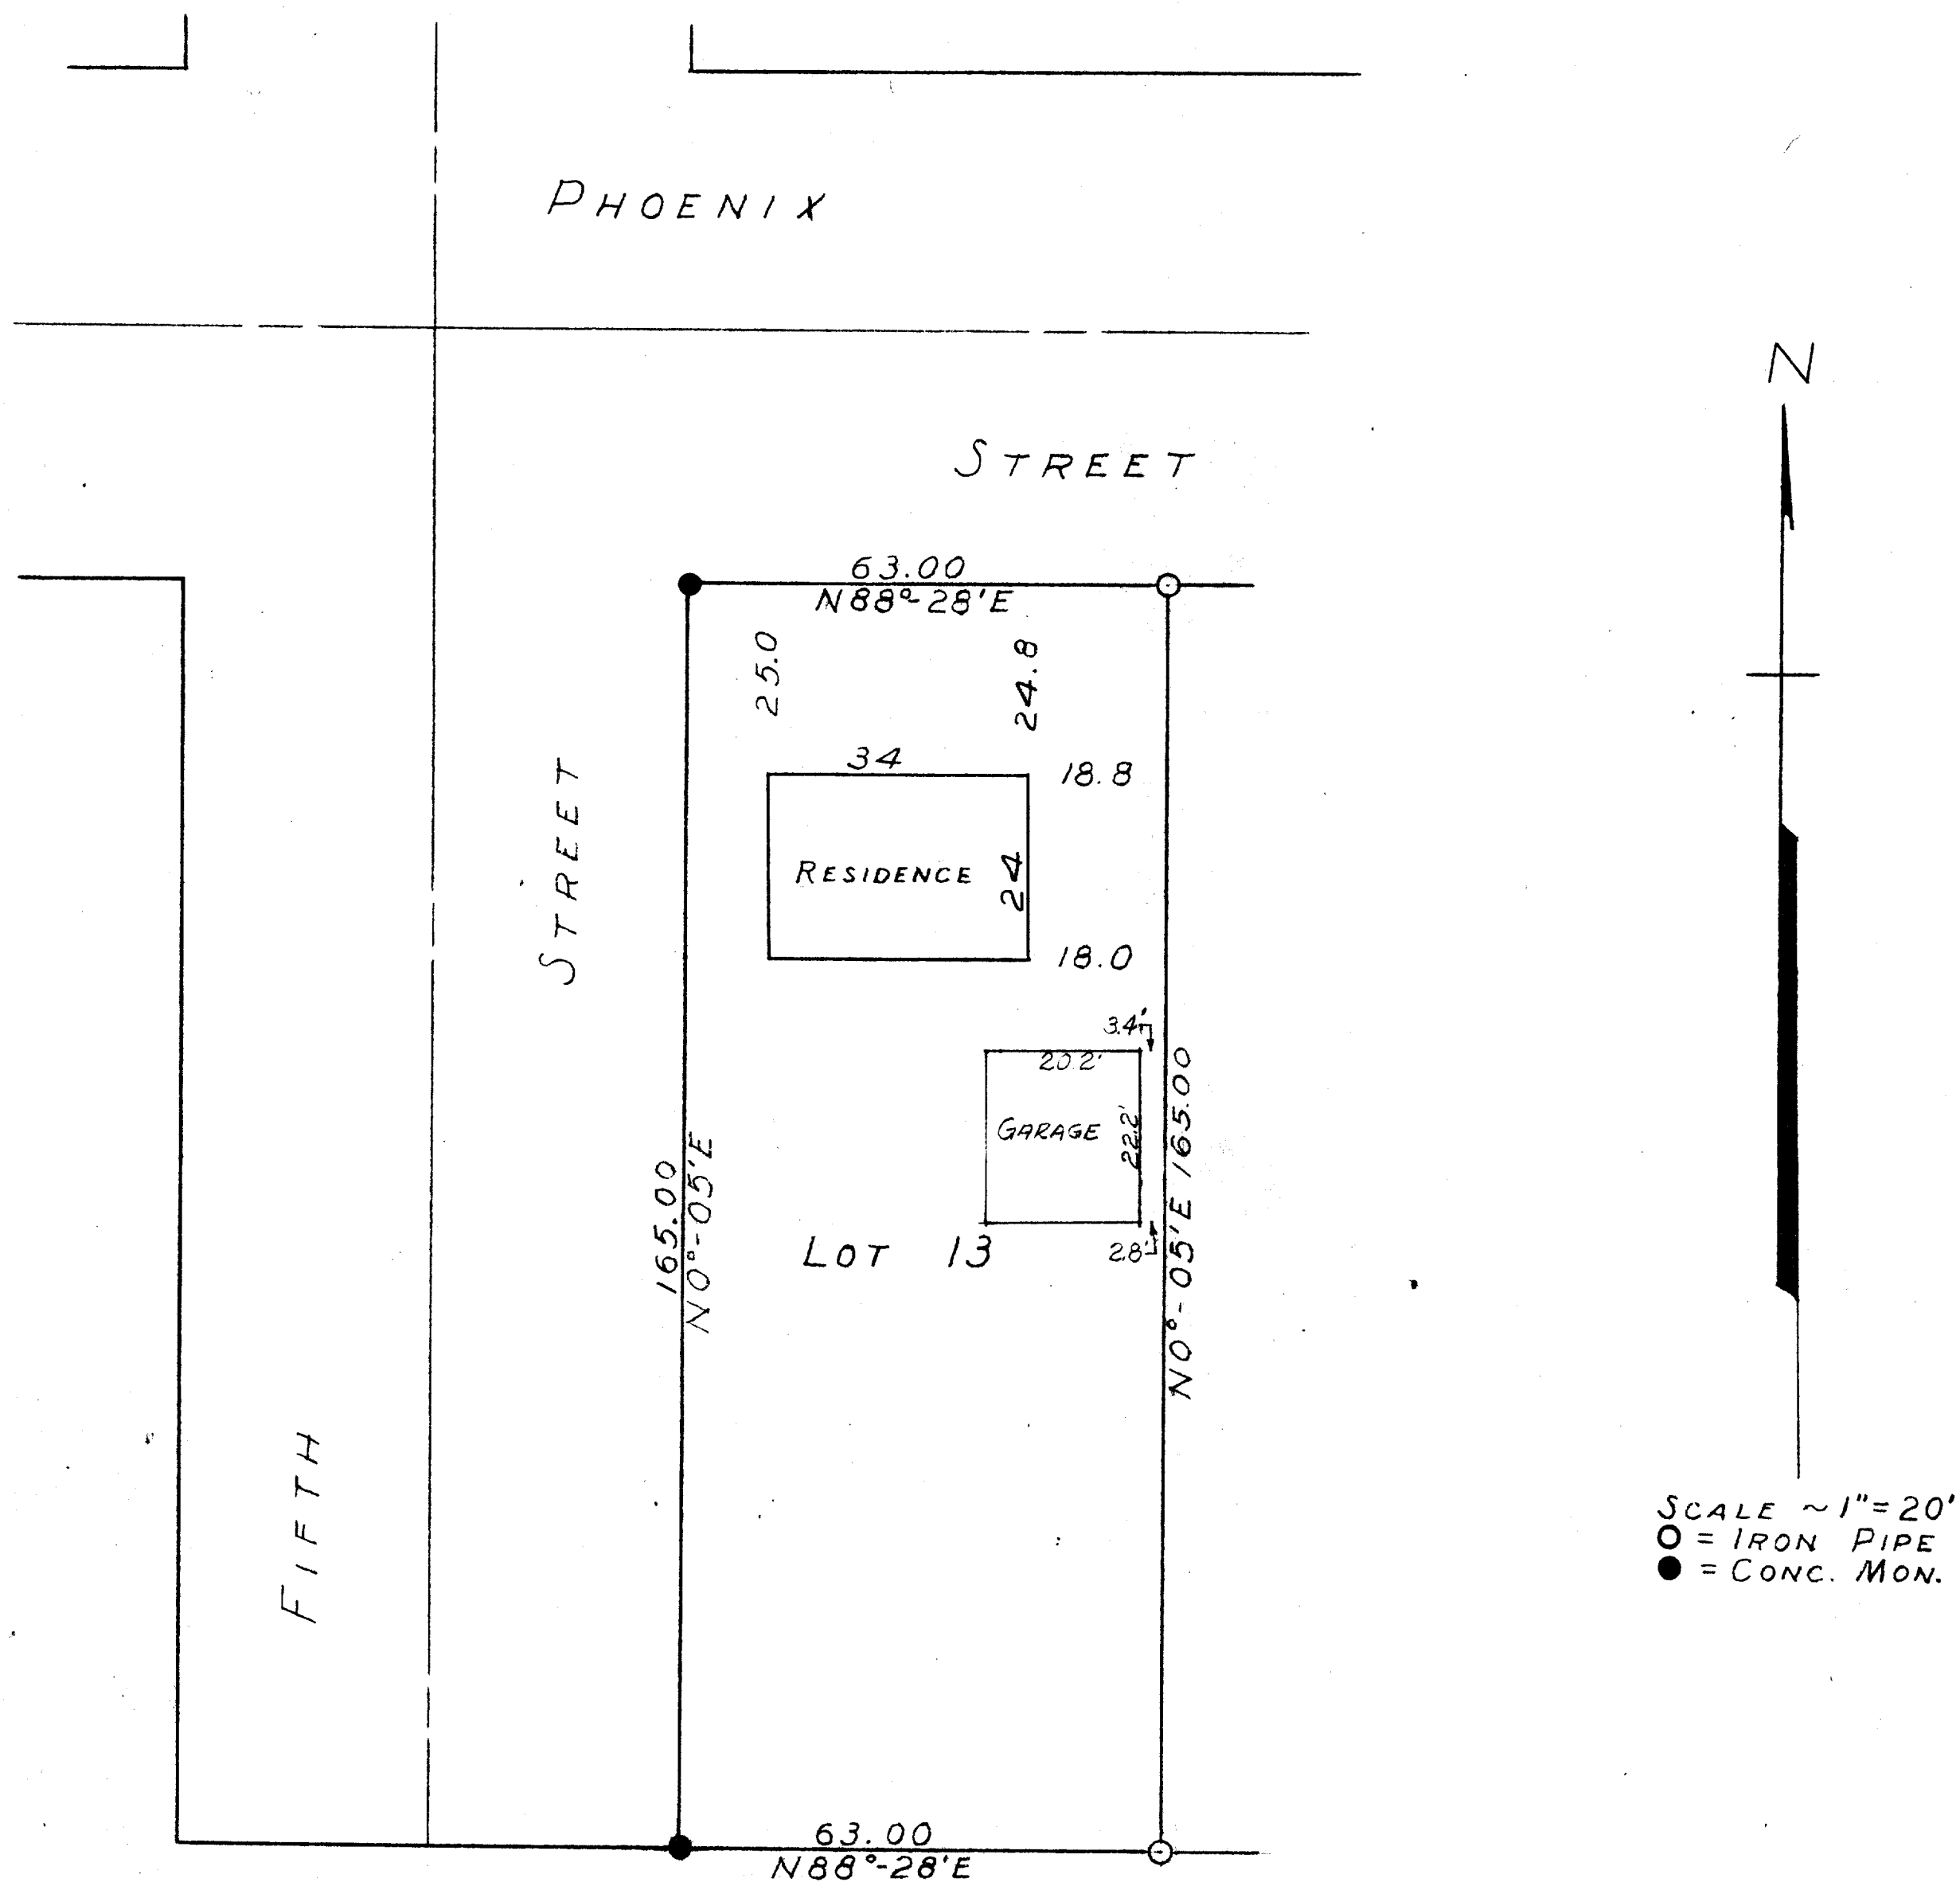

STATE OF WISCONSIN) SS
COUNTY OF WALWORTH)

I, GEORGE T. DUNHAM, DO HEREBY CERTIFY THAT I HAVE SURVEYED THE
PROPERTY DESCRIBED AS FOLLOWS:

LOT 13 OF KNAPP'S SUBDIVISION LOCATED IN THE CITY OF
DELAN, WALWORTH COUNTY, WISCONSIN
AND THAT THE PLAT SHOWN ABOVE IS A CORRECT REPRESENTATION OF
THE PROPERTY LINES AND THE LOCATION OF THE RESIDENCE.

AUGUST 11, 1956

REV APRIL 24, 1961

George T. Dunham
GEORGE T. DUNHAM, SURVEYOR
DELAN, WISCONSIN

2-69