

-PLAT OF SURVEY OF-



Lot 31, Turtle Creek Subdivision, a recorded subdivision located in the SW 1/4 of the SW 1/4 of Section 15, T 2 N, R. 15 E., City of Delavan, Walworth County, Wisconsin.

Survey For: Lomas & Nettleton Co.

BEARINGS:

Bearings hereon refer to the bearings of the recorded plat.

- Denotes iron pipe 1"Ø found
- Denotes Ry/Bar found
- Denotes Ry/Bar found 0.1' South of a.t. property corner

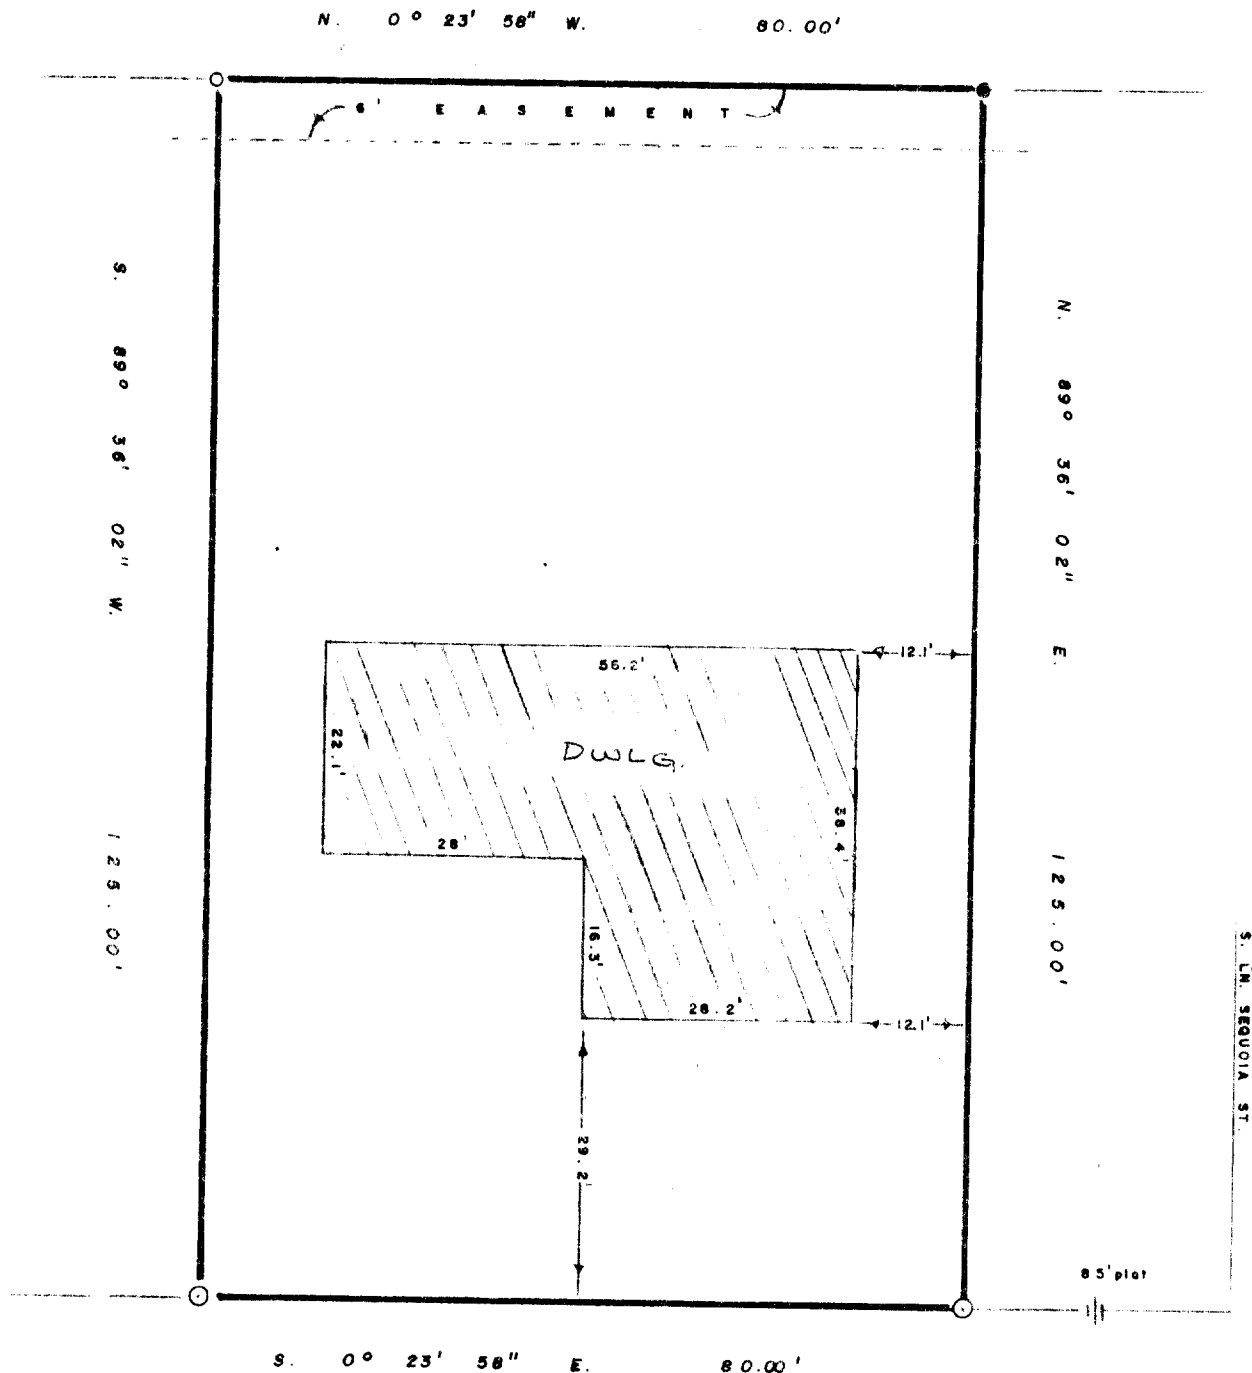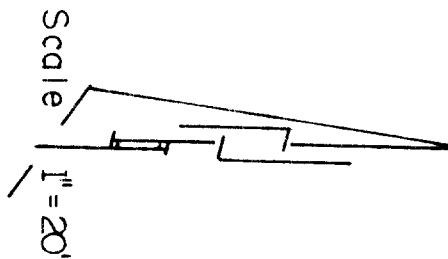

Turtle Creek Drive — 66' Wide

I Certify that I have surveyed the described property and the above map is a true representation thereof and shows the size and location of the property, its exterior boundaries, the location and dimensions of all visible structures thereon, fences, apparent easements and roadways and visible encroachments, if any.

This survey is made for the exclusive use of present owners of property, and also those who purchase, mortgage or guaranty the title thereto within one (1) year from date hereof.

Robert L. Sternberg
Registered Land Surveyor

8/27/80
Date

80267 W.D.L.
Job No.

2-641

