


PLAT OF SURVEY


LOTS 3, 4 & 5 BLOCK 2, OF THE ORIGINAL PLAT OF THE VILLAGE (NOW CITY) OF DELAVAN WISCONSIN LOCATED IN THE NORTHEAST 1/4 OF SECTION 18, CITY OF DELAVAN T.2N., R.16E., WALWORTH COUNTY, WISCONSIN

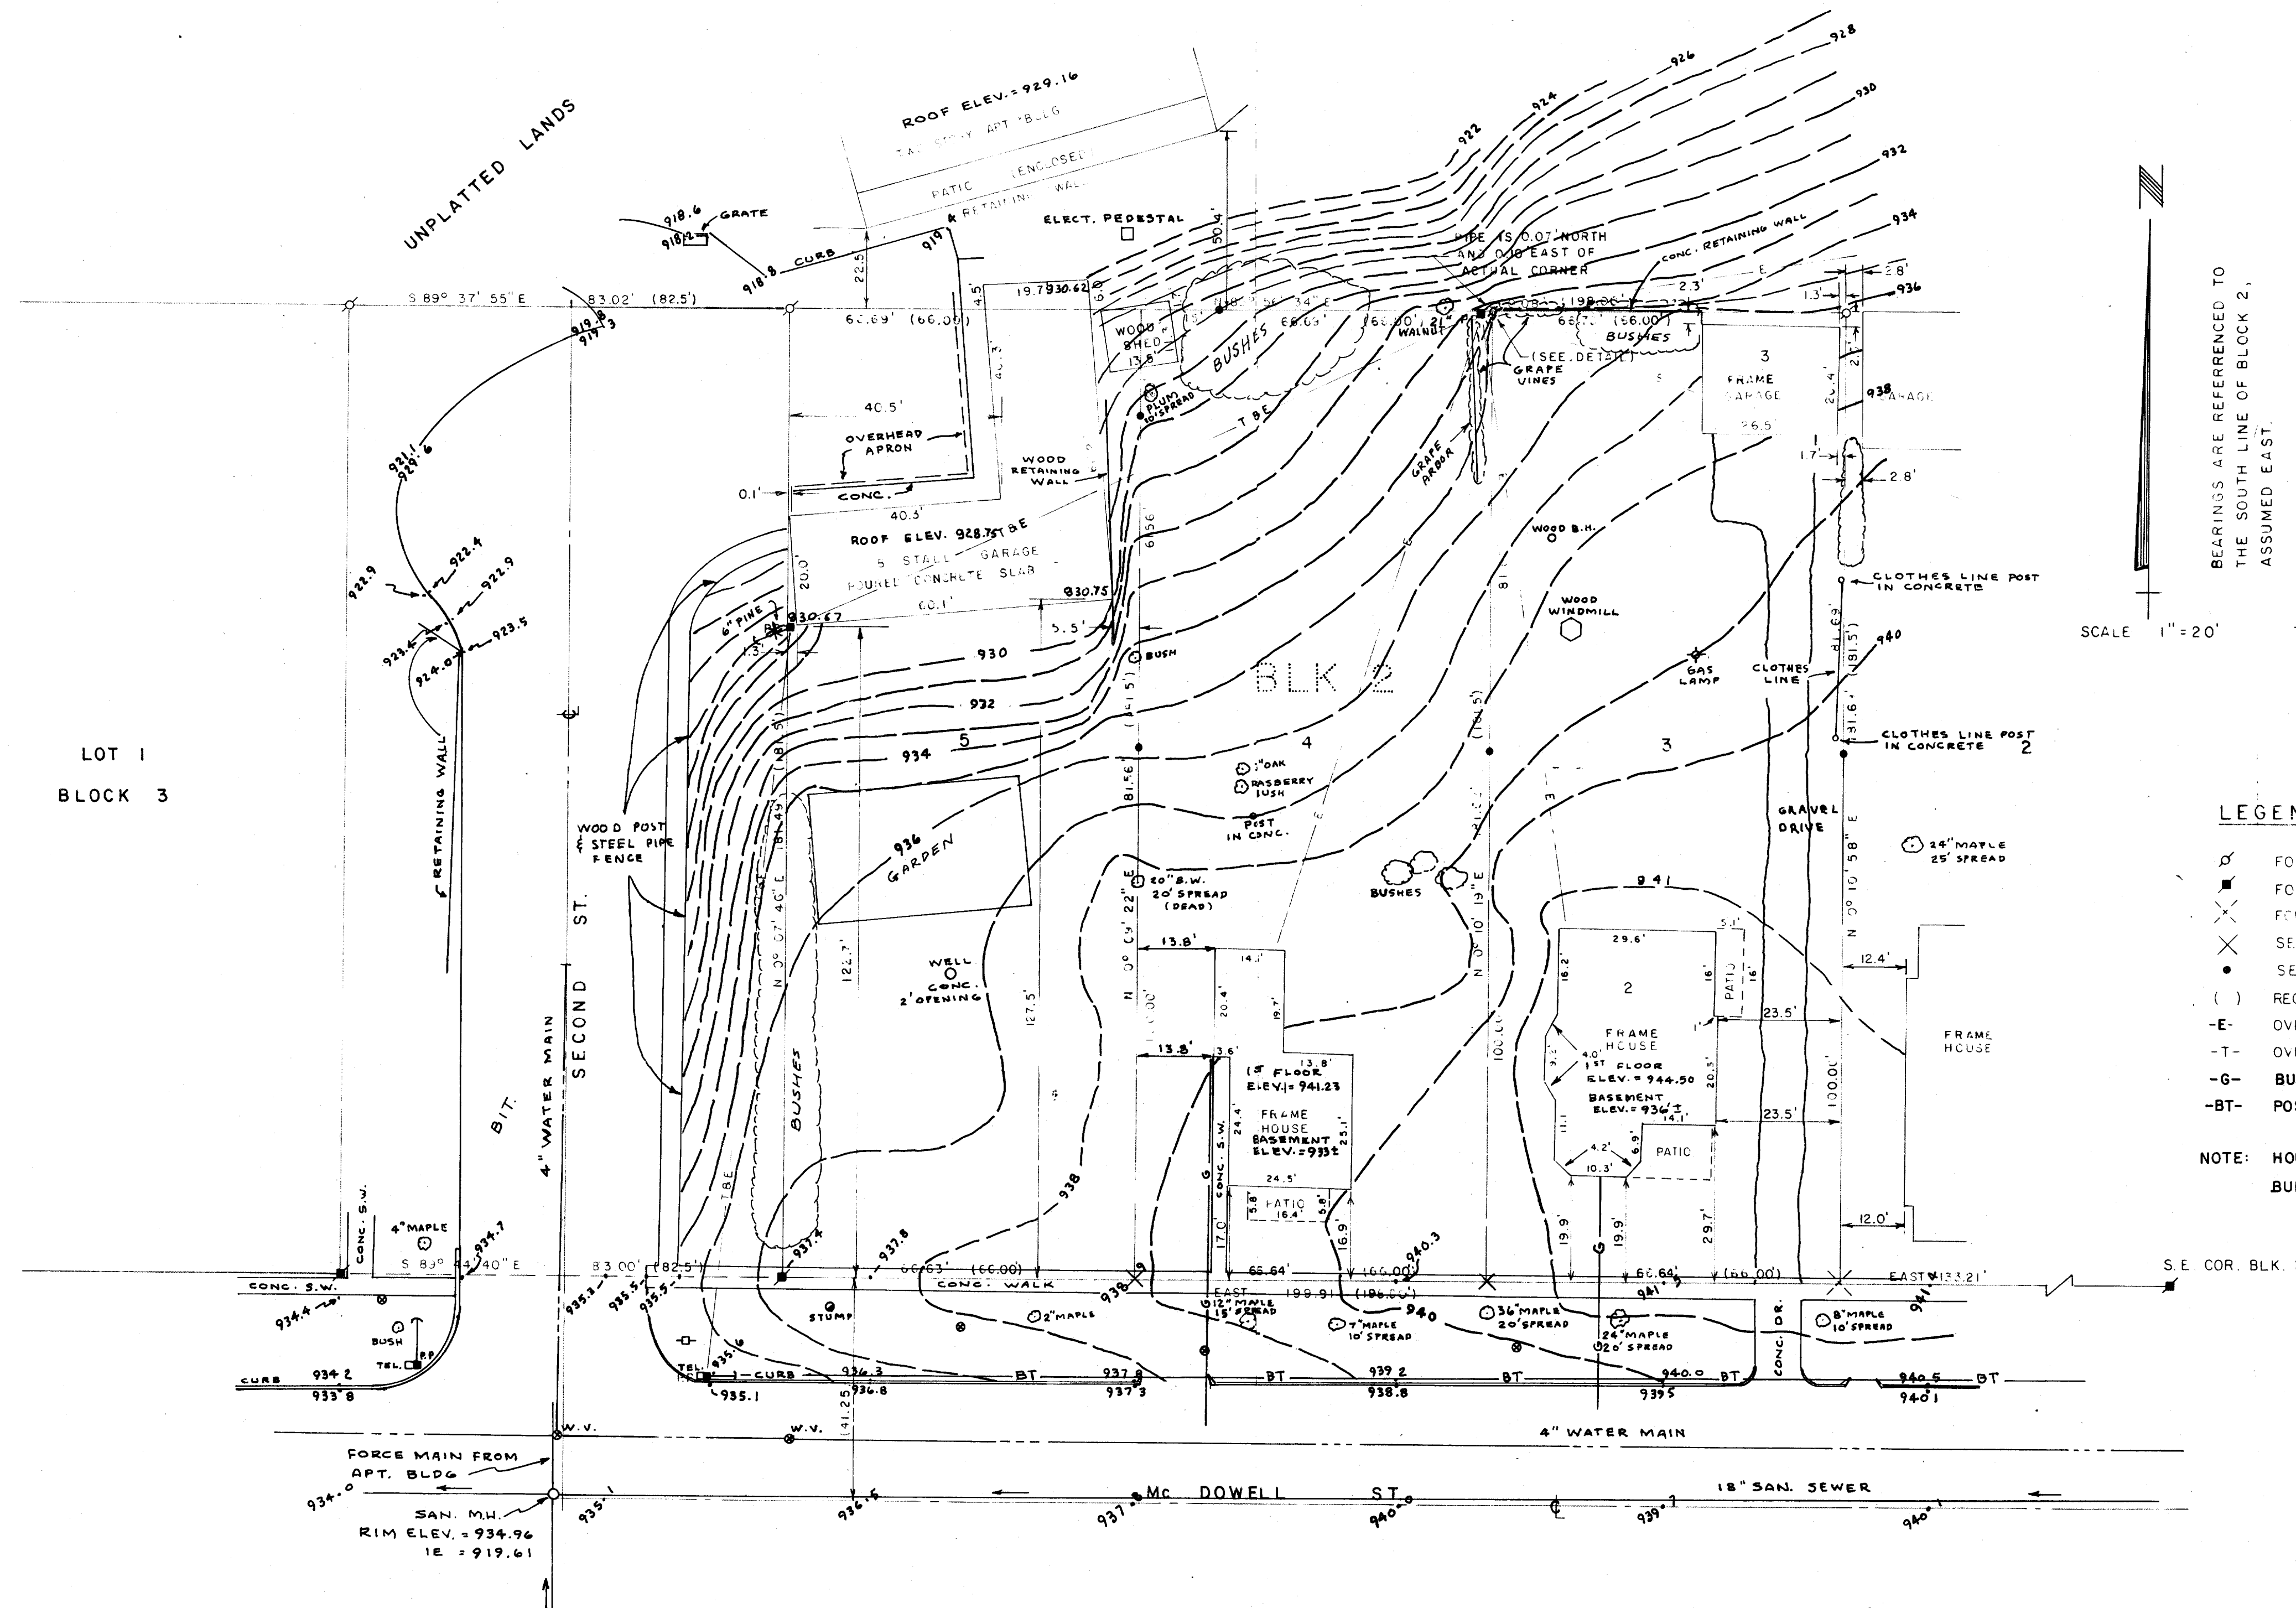

BEARINGS ARE REFERENCED TO THE SOUTH LINE OF BLOCK 2, ASSUMED EAST.

SCALE 1" = 20'

DETAIL
(NOT TO SCALE)

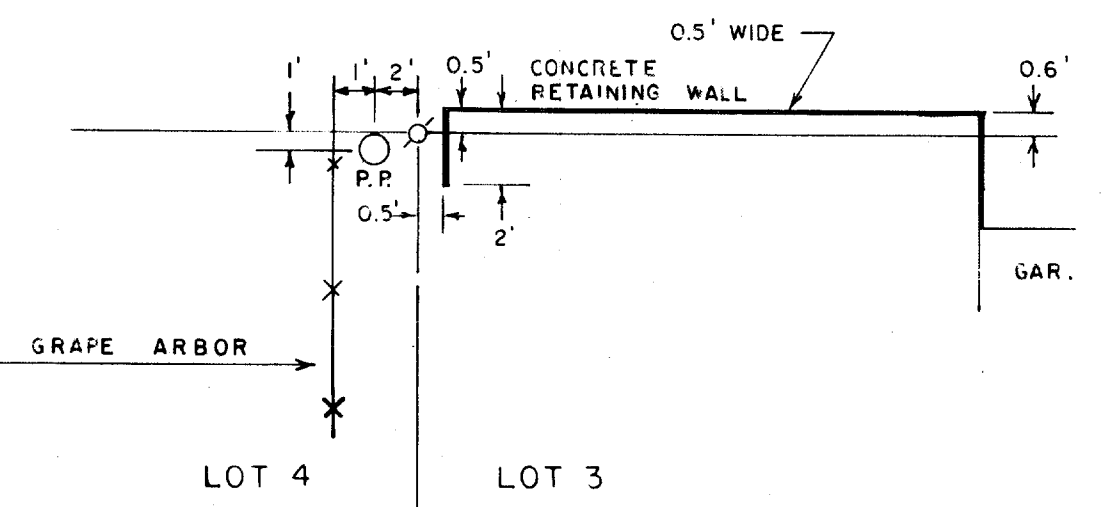


LEGEND

- FOUND PIPE
- ✱ FOUND AXLE IN CONC.
- ✱ FOUND CUT CROSS
- ✱ SET 1" X 36" CROSS
- SET 1 1/2" X 36" IRON PIPE
- () RECORDED BEARINGS OR DISTANCES
- E- OVERHEAD ELECTRIC
- T- OVERHEAD TELEPHONE
- G- BURIED GAS MAIN
- BT- POSSIBLE BURIED TELEPHONE

NOTE: HOUSES ON LOTS 3 & 4 ARE SERVICED BY BURIED TELEPHONE FROM THE SOUTH

SURVEYORS CERTIFICATE
I HAVE SURVEYED THE ABOVE DESCRIBED PROPERTY AND THE ABOVE MAP IS A TRUE REPRESENTATION THEREOF AND SHOW THE SIZE AND LOCATION OF THE PROPERTY, ITS EXTERIOR BOUNDARIES, THE LOCATION AND DIMENSIONS OF ALL STRUCTURES THEREON, FENCES, APPARENT EASEMENTS AND ROADWAYS AND VISIBLE ENCROACHMENTS, IF ANY.
THIS SURVEY IS MADE FOR THE EXCLUSIVE USE OF THE PRESENT OWNERS OF THE PROPERTY, AND ALSO THOSE WHO PURCHASE, MORTGAGE, OR GUARANTEE THE TITLE THEREIN WITHIN ONE (1) YEAR FROM DATE HEREOF AND AS TO THEM I WARRANT THE ACCURACY OF SAID SURVEY AND MAP.
DATED THIS 13 DAY OF OCTOBER, 1950 Robert Scott Johnson

donohue & associates inc.
CONSULTING ENGINEERS
ELKHORN, WISCONSIN

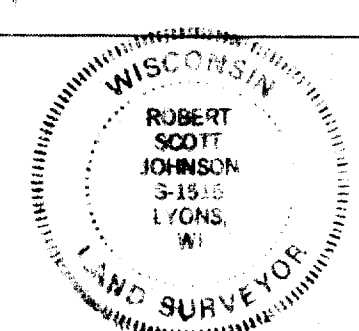

DATE	OCTOBER 13, 1950	SCALE	1" = 20'
DRAWN BY	D. GEYE	SURVEY FOR	MUND INVESTMENT REAL ESTATE, INC.
CHECKED BY	D. ZENZ	PROJECT NO.	11164.000

X0P5

2-642