


PLAT OF SURVEY

OF
 LOTS 1 THRU 6 INCLUSIVE OF BLK 10 OF PASSAGE ARAM AND DOWNIE ADDITION
 WEST OF 8TH ST. LOCATED IN THE CITY OF DELAVAN, WALWORTH COUNTY, WIS.
 AND OF LEASES # 57818 AND # 74171: LESSOR CHICAGO, MILWAUKEE, ST. PAUL
 AND
 PACIFIC RAILROAD COMPANY
 LESSEE JACK FAGAN CO. INC.
 ALSO LOCATED IN THE CITY OF DELAVAN, WALWORTH COUNTY, WIS.



I HEREBY CERTIFY THAT THE ABOVE DESCRIBED PROPERTY HAS BEEN SURVEYED UNDER
 MY DIRECTION AND THAT THE PLAT HEREON DRAWN IS A CORRECT REPRESENTATION OF SURVEY
 AND CORRECTLY SHOWS THE EXTERIOR BOUNDARIES, DIVISIONS AND IMPROVEMENTS OF SAID
 PROPERTY DATED JULY 28, 1980

Thomas P. Jensen
 THOMAS P. JENSEN WRLS # 1084

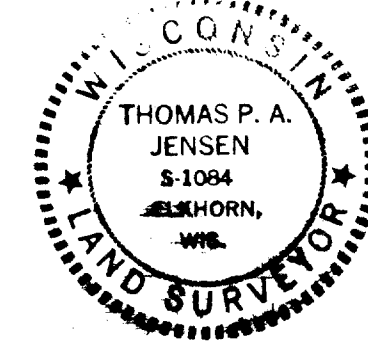

SURVEYED FOR - JACK FAGAN CO. INC.

JENSEN SURVEYING & MAPPING
 P.O. BOX 322
 ELKHORN, WIS 53121

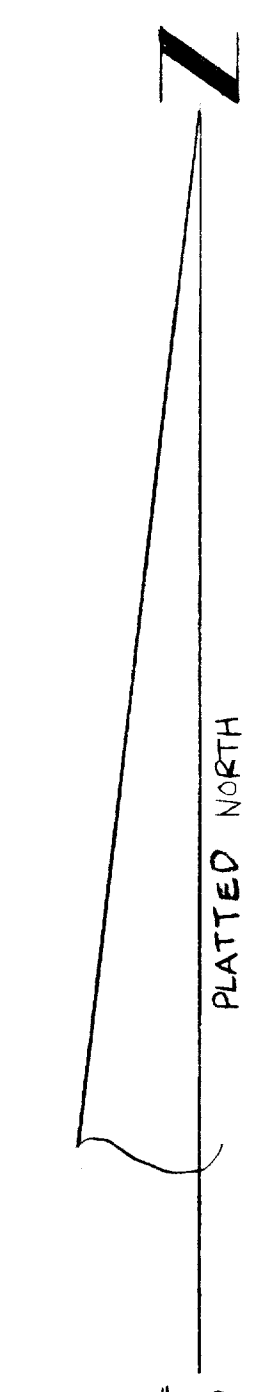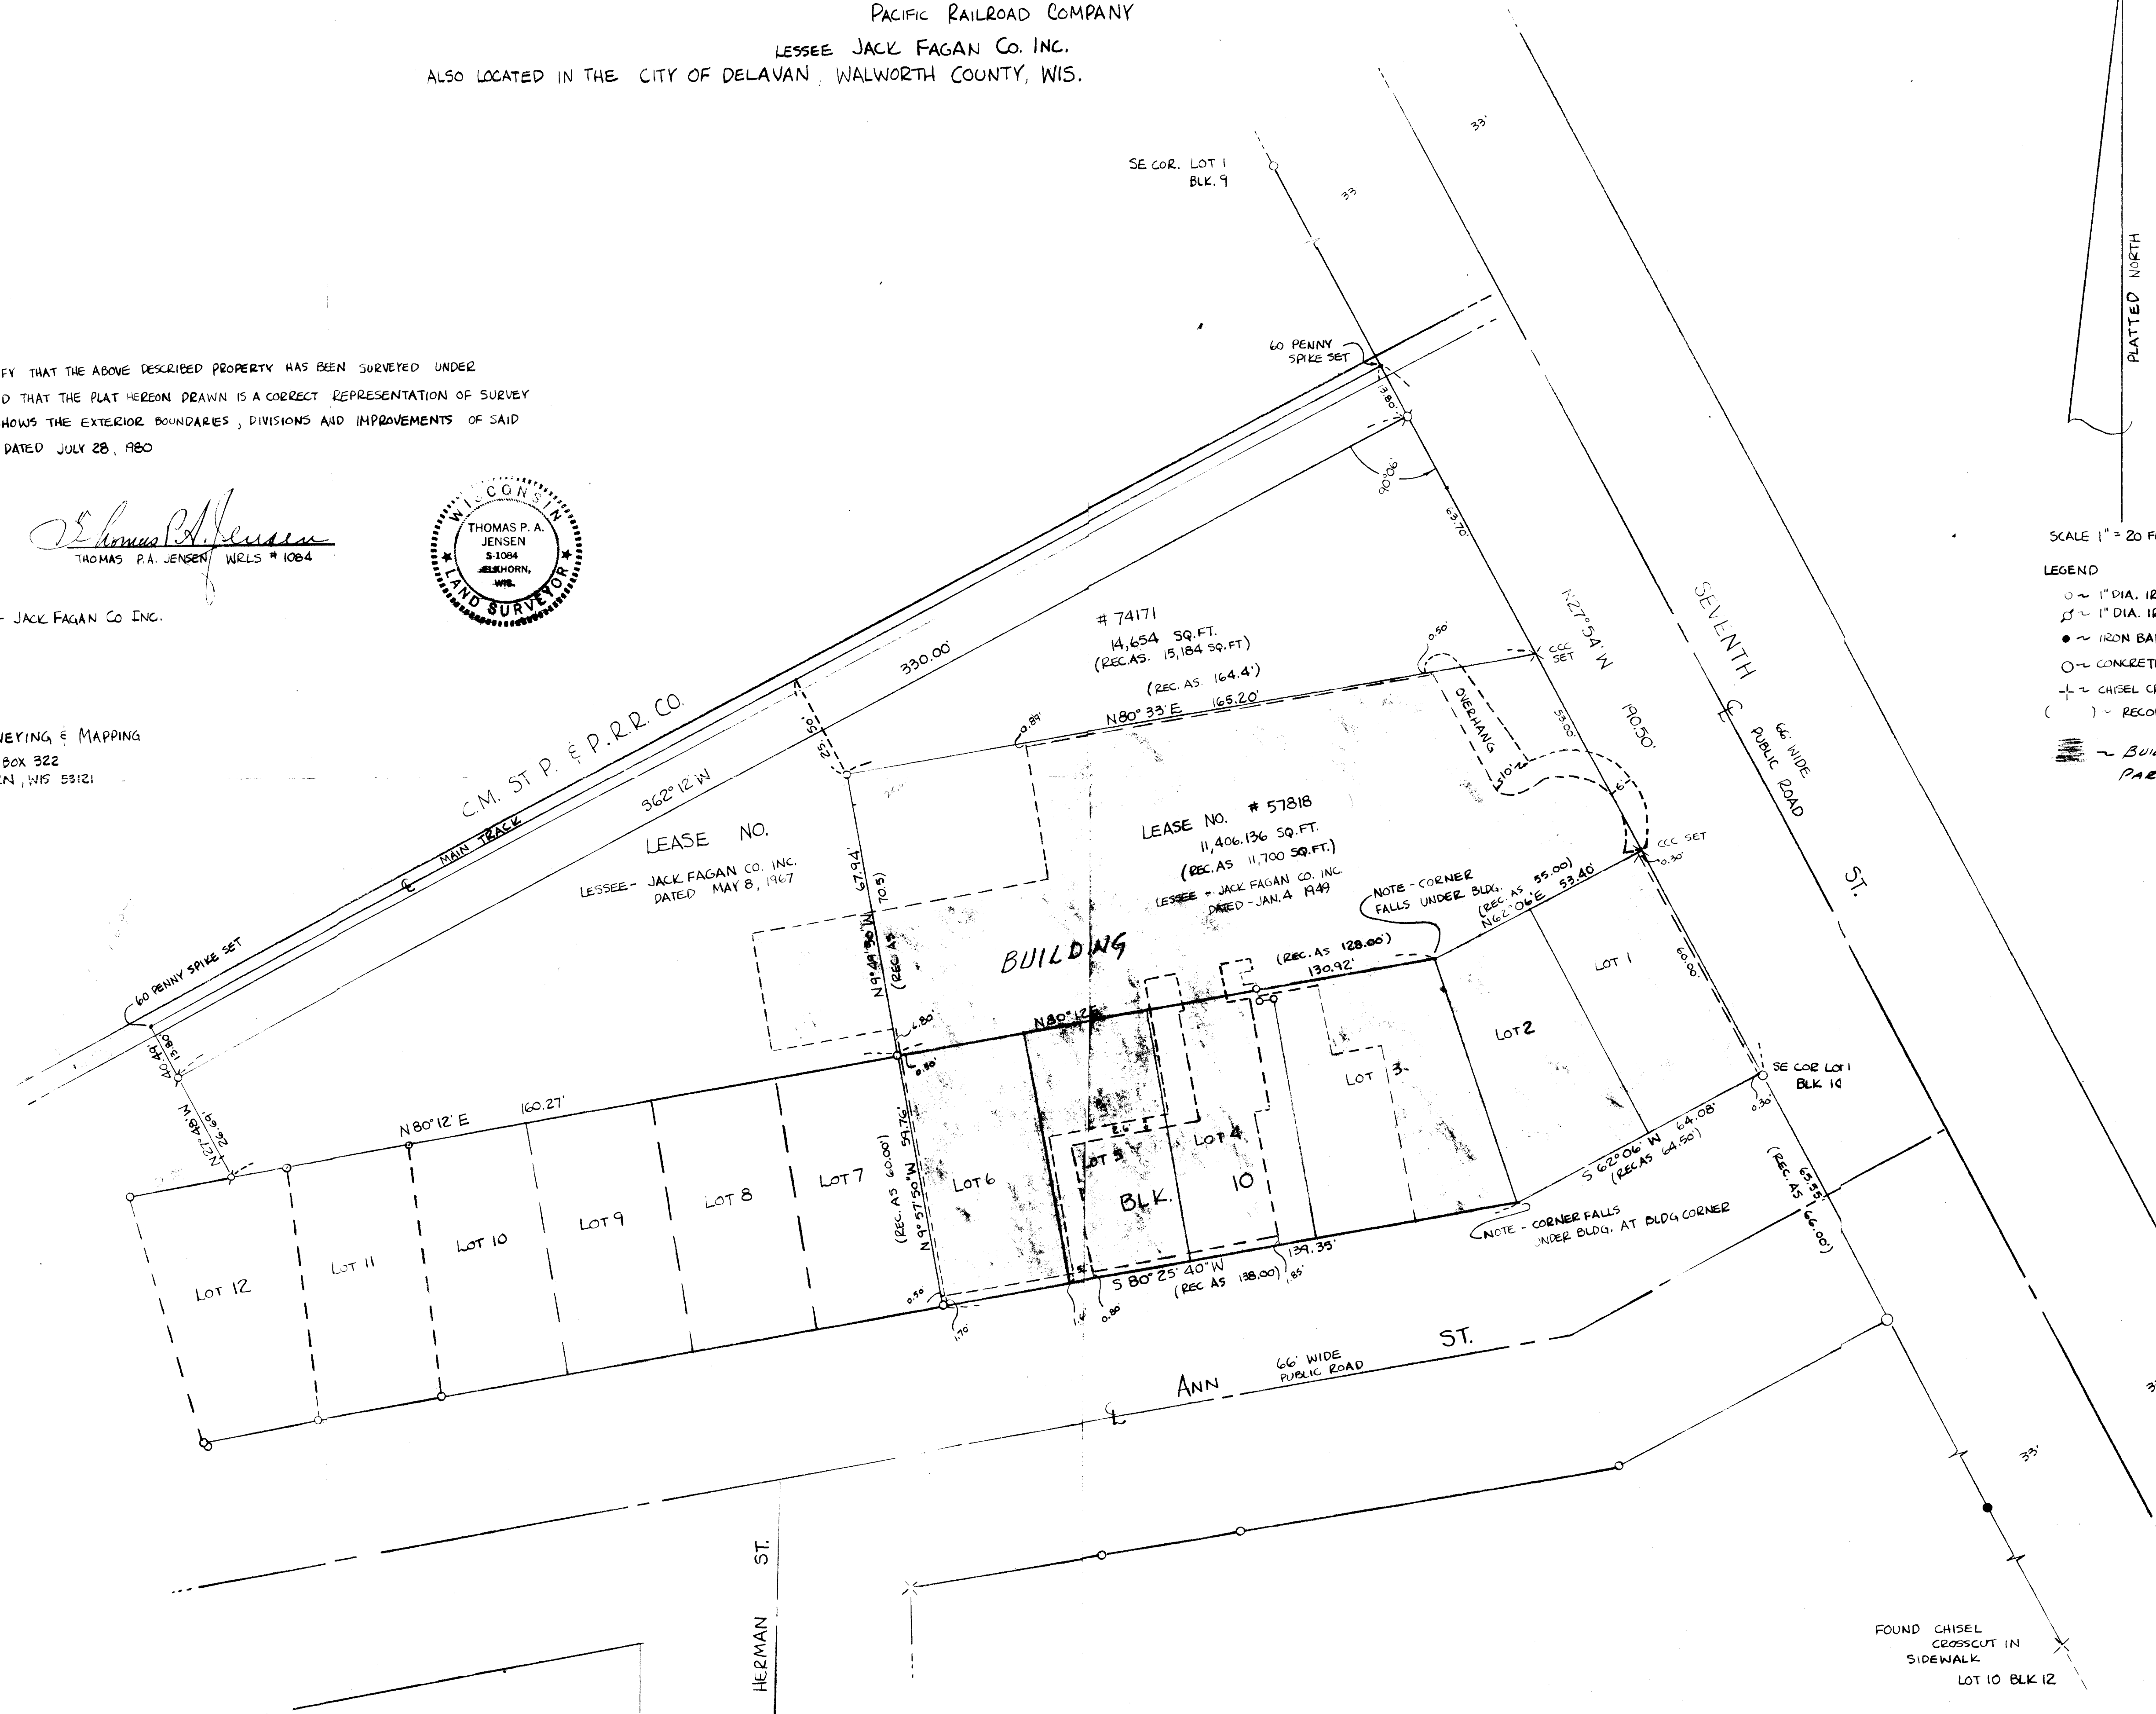

SCALE 1" = 20 FEET

LEGEND

- ~ 1" DIA. IRON PIPE FOUND
- ⊕ ~ 1" DIA. IRON PIPE SET
- ~ IRON BAR FOUND
- ~ CONCRETE MONUMENT FOUND
- + ~ CHISEL CROSSCUT FOUND
- () ~ RECORDED AS
- ▬ ~ BUILDING ON PARCEL