


- ◊ = IRON PIPE SURVEY STAKE FOUND
- = IRON ROD SURVEY STAKE FOUND
- ⊕ = CROSS CUT IN CONCRETE FOUND
- = IRON PIPE SURVEY STAKE SET
- (XXXX) = RECORD DIMENSION

FARRIS, HANSEN & COOPER, INC.
 ENGINEERING, SURVEYING AND LAND PLANNING
 715 W. WALWORTH ST. - P.O. BOX 487 - ELKHORN, WI 53121
 OFFICE: 414/723-2098

PLAT OF SURVEY
 LOT 10, BLOCK 1
 CONVERSE'S SUB. 5
 DELAVAN, WIS.

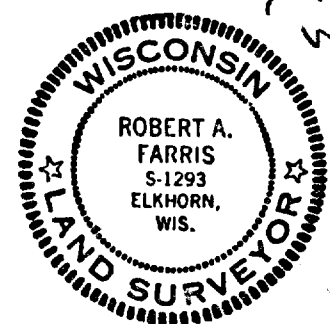

I HEREBY CERTIFY THAT I HAVE SURVEYED LOT 10 OF BLOCK 1 OF CONVERSE'S SUBDIVISION LOCATED IN THE CITY OF DELAVAN, WISCONSIN, AND THAT THIS PLAT OF SURVEY IS A TRUE AND ACCURATE REPRESENTATION OF THE LOT LINES AND BUILDING LOCATION TO THE BEST OF MY PROFESSIONAL KNOWLEDGE AND BELIEF

1 APRIL 1982

Robert A. Farris

DRAWING NUMBER 1946

