


BUILDING LAYOUT AS STAKED AT SITE

TURTLE CREEK APARTMENTS -FAMILY HOUSING
 DELAVAN, WISCONSIN
 HSR NO. 800119
 LOT 1 OF C.S.M. # 1111 Vol. 5 P. 127

BIRCHWOOD STREET
 66' WIDE PUBLIC ROAD

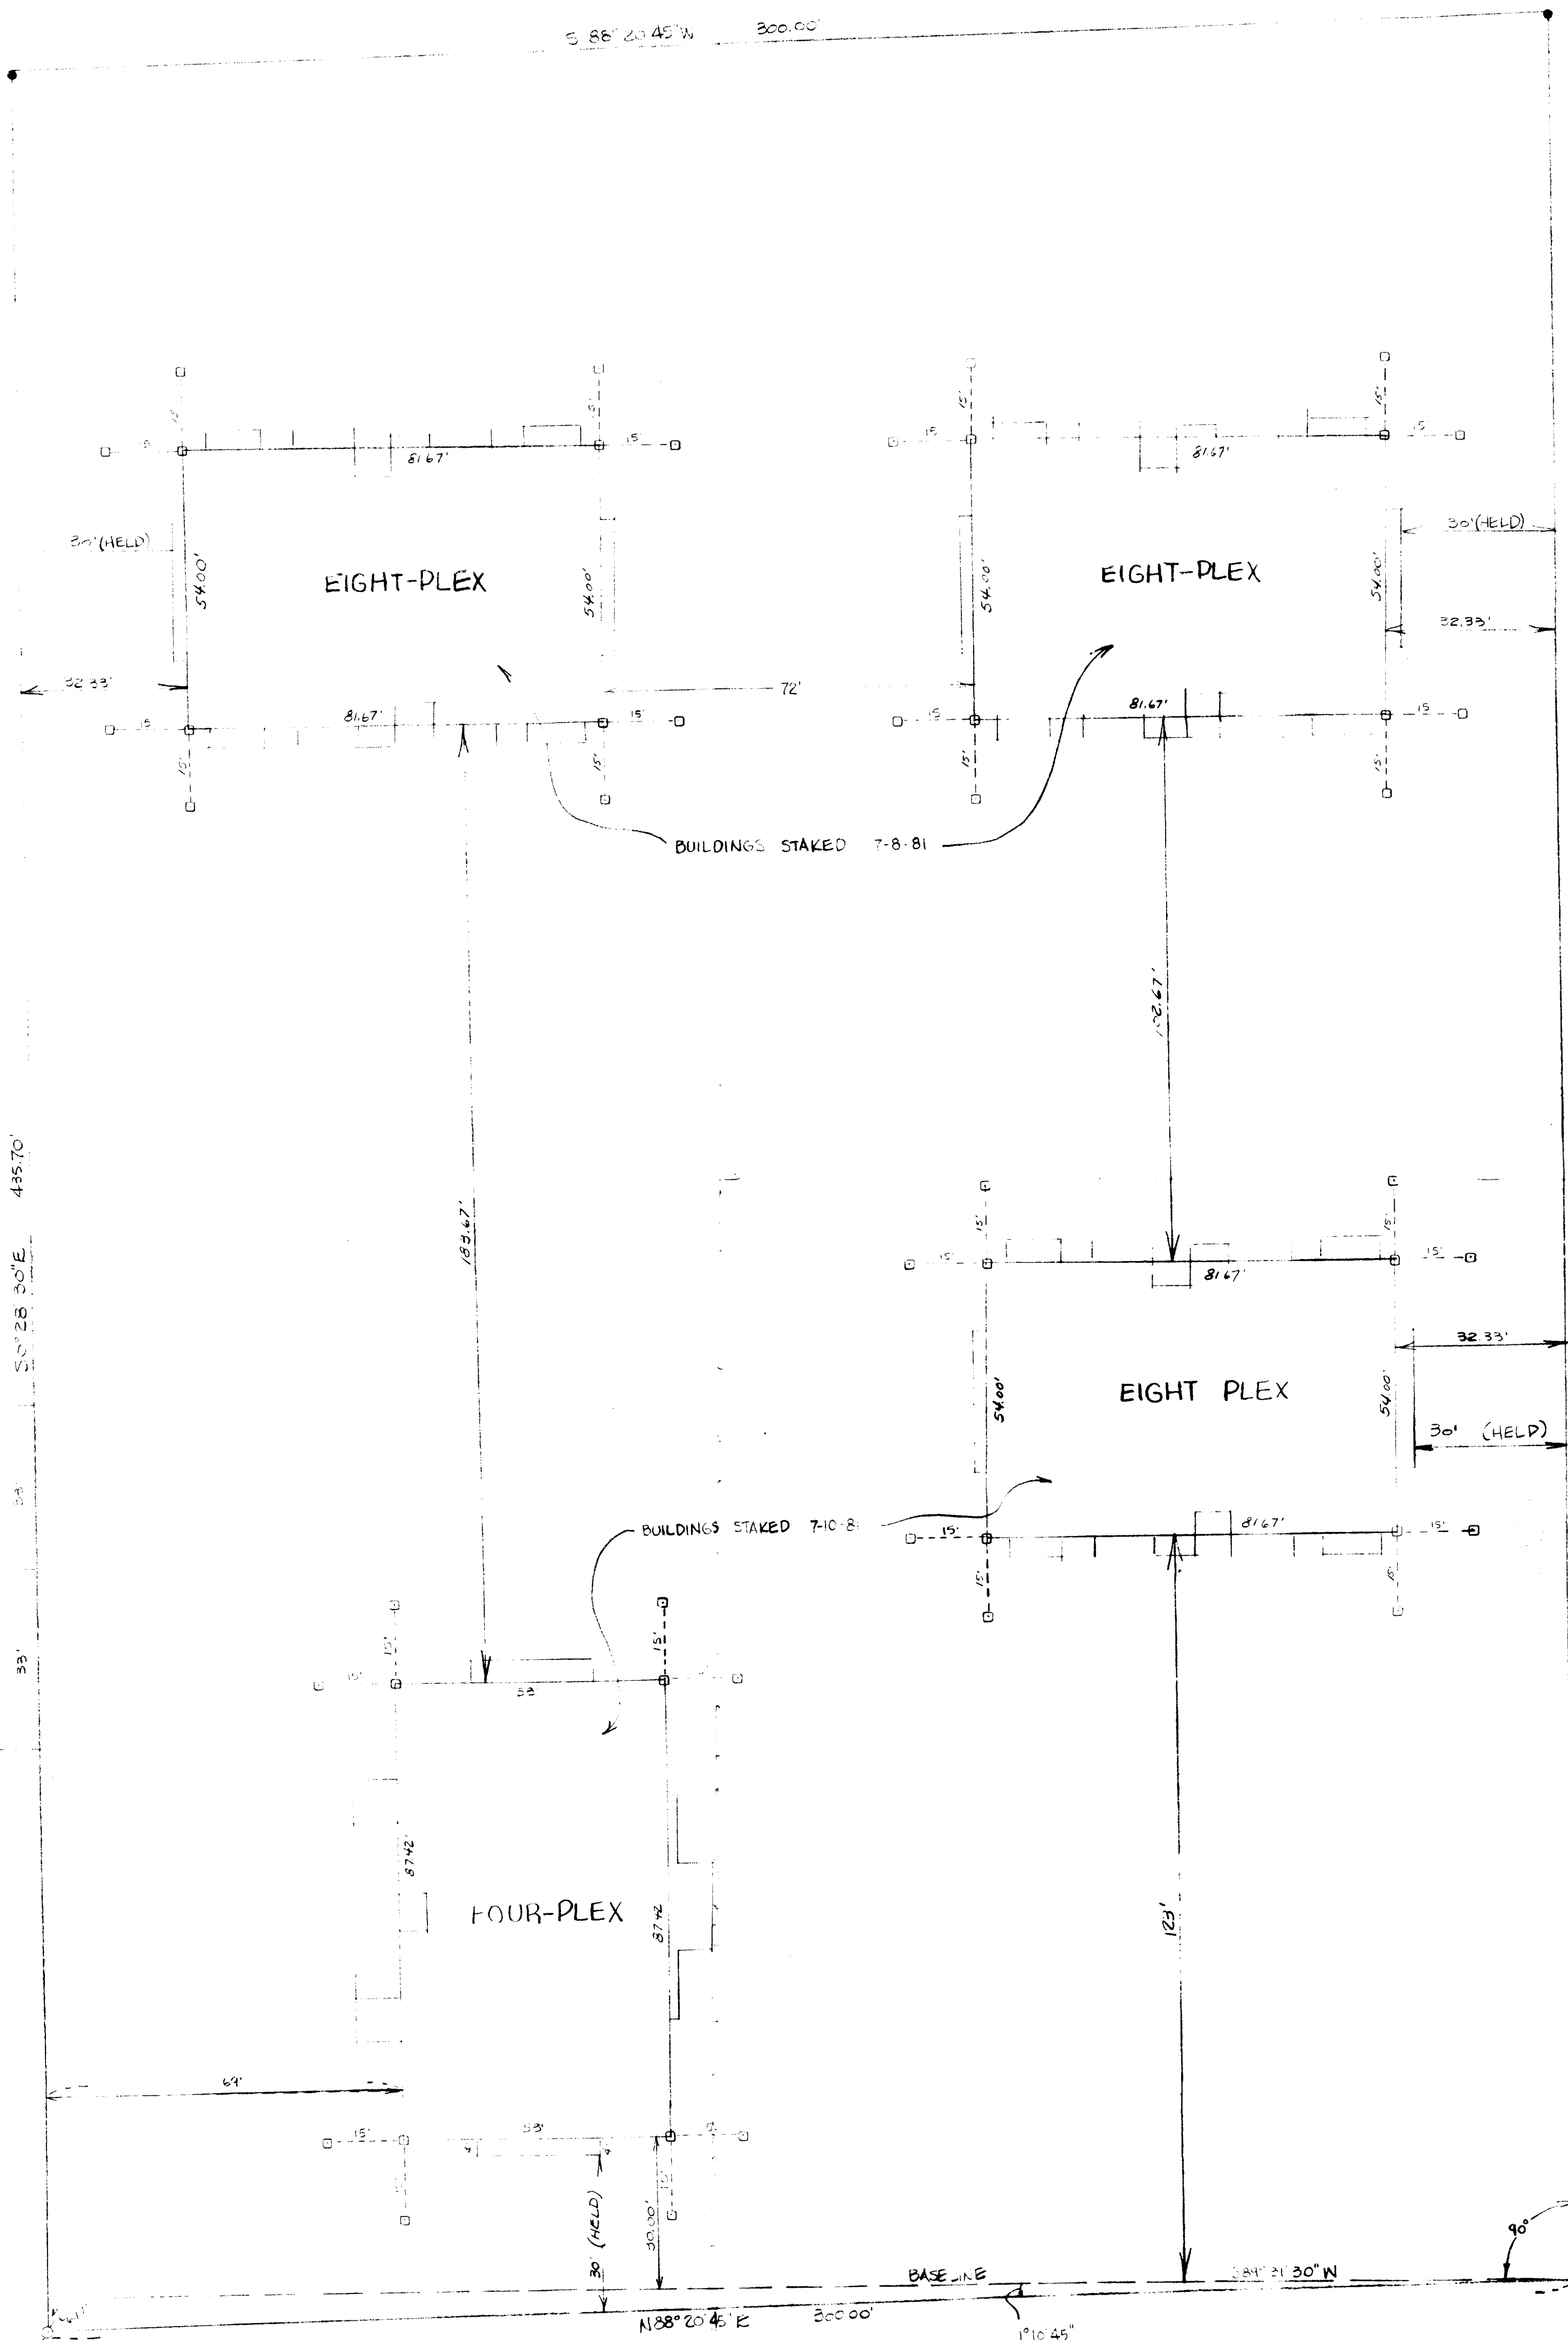


SCALE 1" = 20'

LEGEND

- WOOD STAKE SET @ BUILDING CORNER
- ROUND IRON ROD 3/4" DIA.
- IRON PIPE FOUND
- WOOD STAKE SET @ 15' OFFSET ~ ALL OFFSET ~ 2E 15'

NOTE: BUILDINGS WERE STAKED FROM FOUNDATION PLAN
 DIMENSIONS WHICH ADD 2" FOR FOUNDATION WALL CHAMFER
 SEE DETAIL #2 OF SHEET A-4

JENSEN SURVEYING & MAPPING, S.C.
 P.O. BOX 322
 ELKHORN, WIS. 53121
 DATED 7-10-81

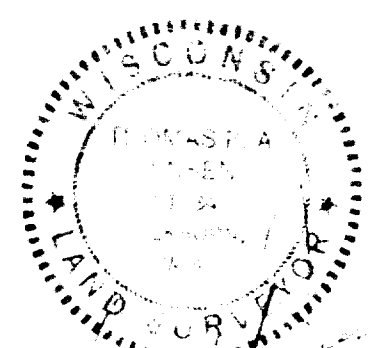

DIMENSION STARTING
 POINT FOR LAYING OUT
 BUILDING IN NORTH ~
 SOUTH DIRECTION