

BUILDINGS & IMPROVEMENTS AS BUILT WITH DIMENSIONS TO EXTERIOR BOUNDARY LINES

TURTLE CREEK APARTMENTS - FAMILY DEHAVAN, WISCONSIN HOUSING HSR NO. 800119

LOT 1 OF C.S.M. #1111 VOL. 5 P. 127
LOCATED IN THE SE 1/4 OF SECTION 13, T. 1 N. R. 1 E. CITY OF DELAVAN, WALWORTH COUNTY,
WISCONSIN



SCALE 1" = 20'

LEGEND

- FOUND IRON ROD 3/4" DIA.
- FOUND IRON PIPE 2" DIA.

NOTE - PHOTOGRAPHS TAKEN 8-21-81
" " " " 10-6-81

--- INDICATES CONCRETE

SURVEYED FOR: MUNZ INVEST REAL ESTATE INC.
340 W. WASHINGTON AVE.
MADISON WIS. 53703

JENSEN SURVEYING & MAPPING S.C.

P.O. BOX 322


ELKHORN, WIS.

53121 (414)-725-3434

DATED 8-23-81 1ST INSPECTION


REVISED 10-1-81 2ND INSPECTION

REVISED 1-17-82 3RD FINAL INSPECTION

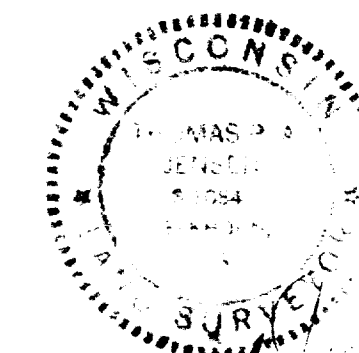

I HEREBY CERTIFY THAT THE ABOVE DESCRIBED PROPERTY HAS
BEEN RESURVEYED UNDER MY DIRECTION AND THAT THE PLAT
HEREON DRAWN IS AN ACCURATE SURVEY AND A TRUE REPRESENTATION
THEREOF AND CORRECTLY SHOWS THE BOUNDARY LINES AND THE VISIBLE
IMPROVEMENTS OF SAID PROPERTY

Thomas P.A. Jensen
THOMAS P.A. JENSEN S-1084
9-3-82

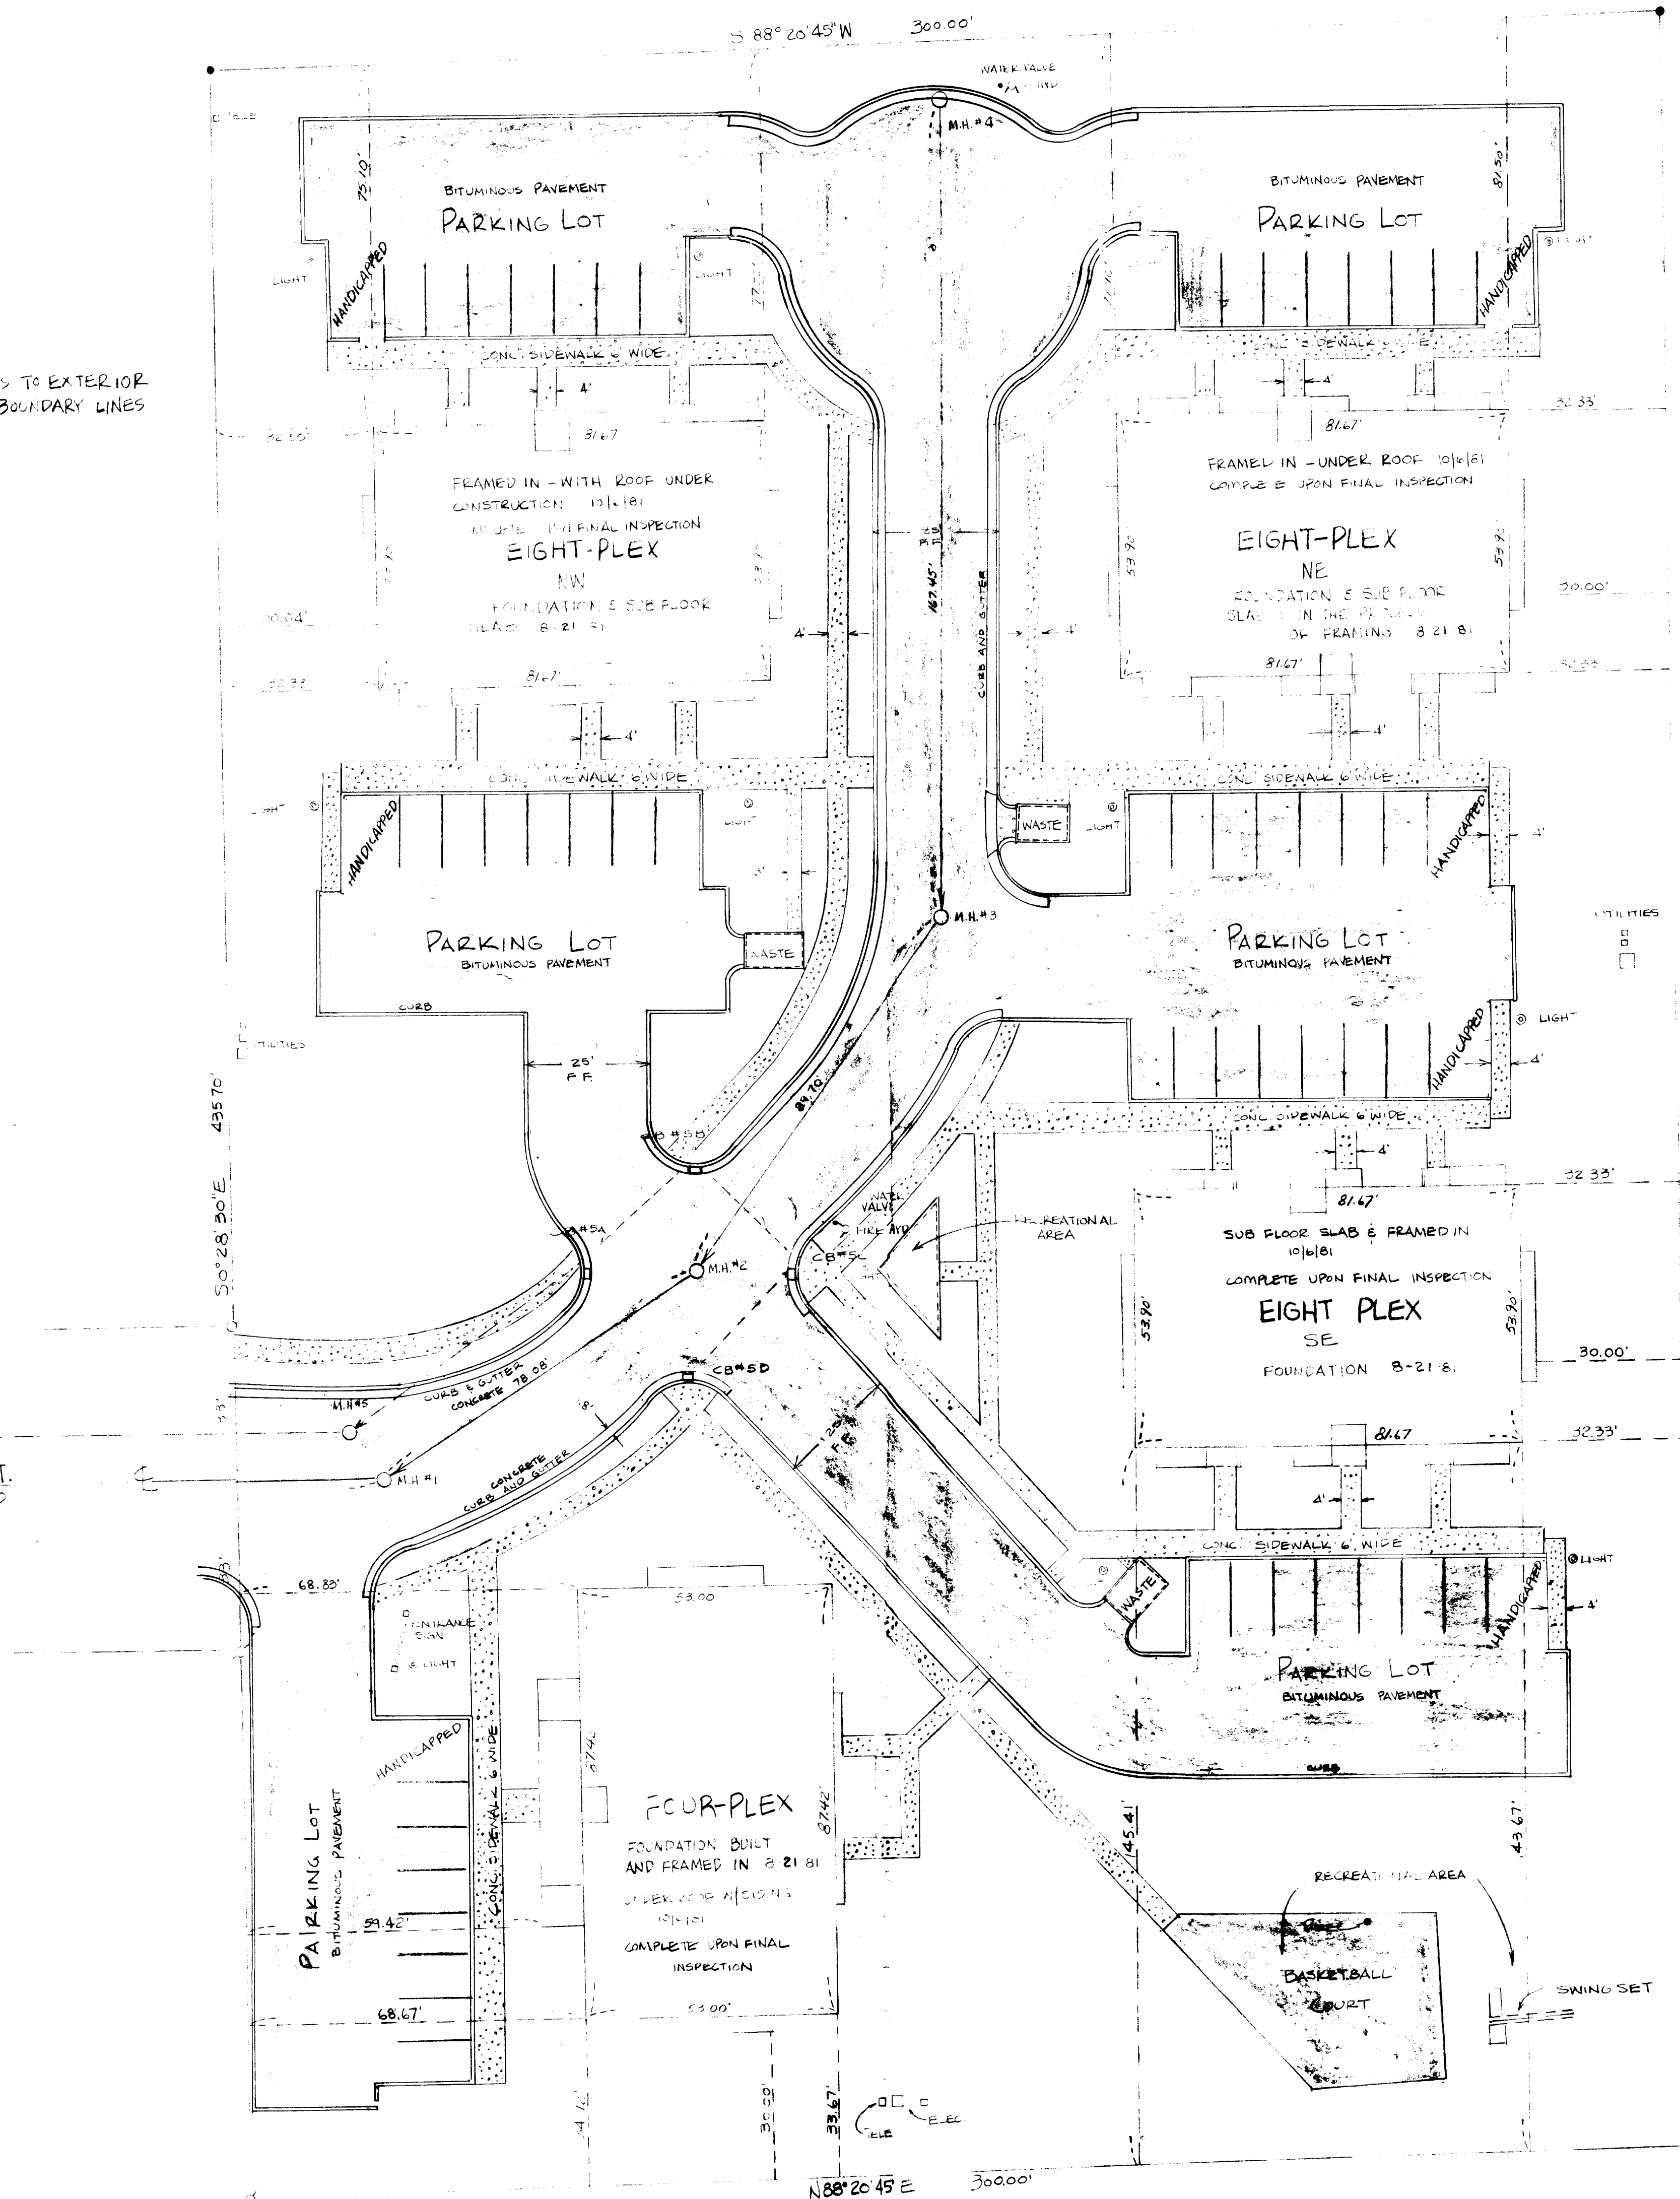

EXISTING STORM SEWER
EXISTING SANITARY M.H.
BIRCHWOOD ST.
20' WIDE PUBLIC ROAD
200' W

built on Lot 1111 in SE 1/4 Sec 13-2-15 - Davian Twp. in City limits

2-651-J