


DUNHAM SURVEYING, S.C.
SURVEYING & SUBDIVIDING
DELAVAN, WISCONSIN 53115

N

WASHINGTON

Scale - 1" = 20'
● = Concrete Monument
⊙ = Iron Pipe Found
○ = Iron Pipe Set
(0.00) = Recorded Distance

STREET

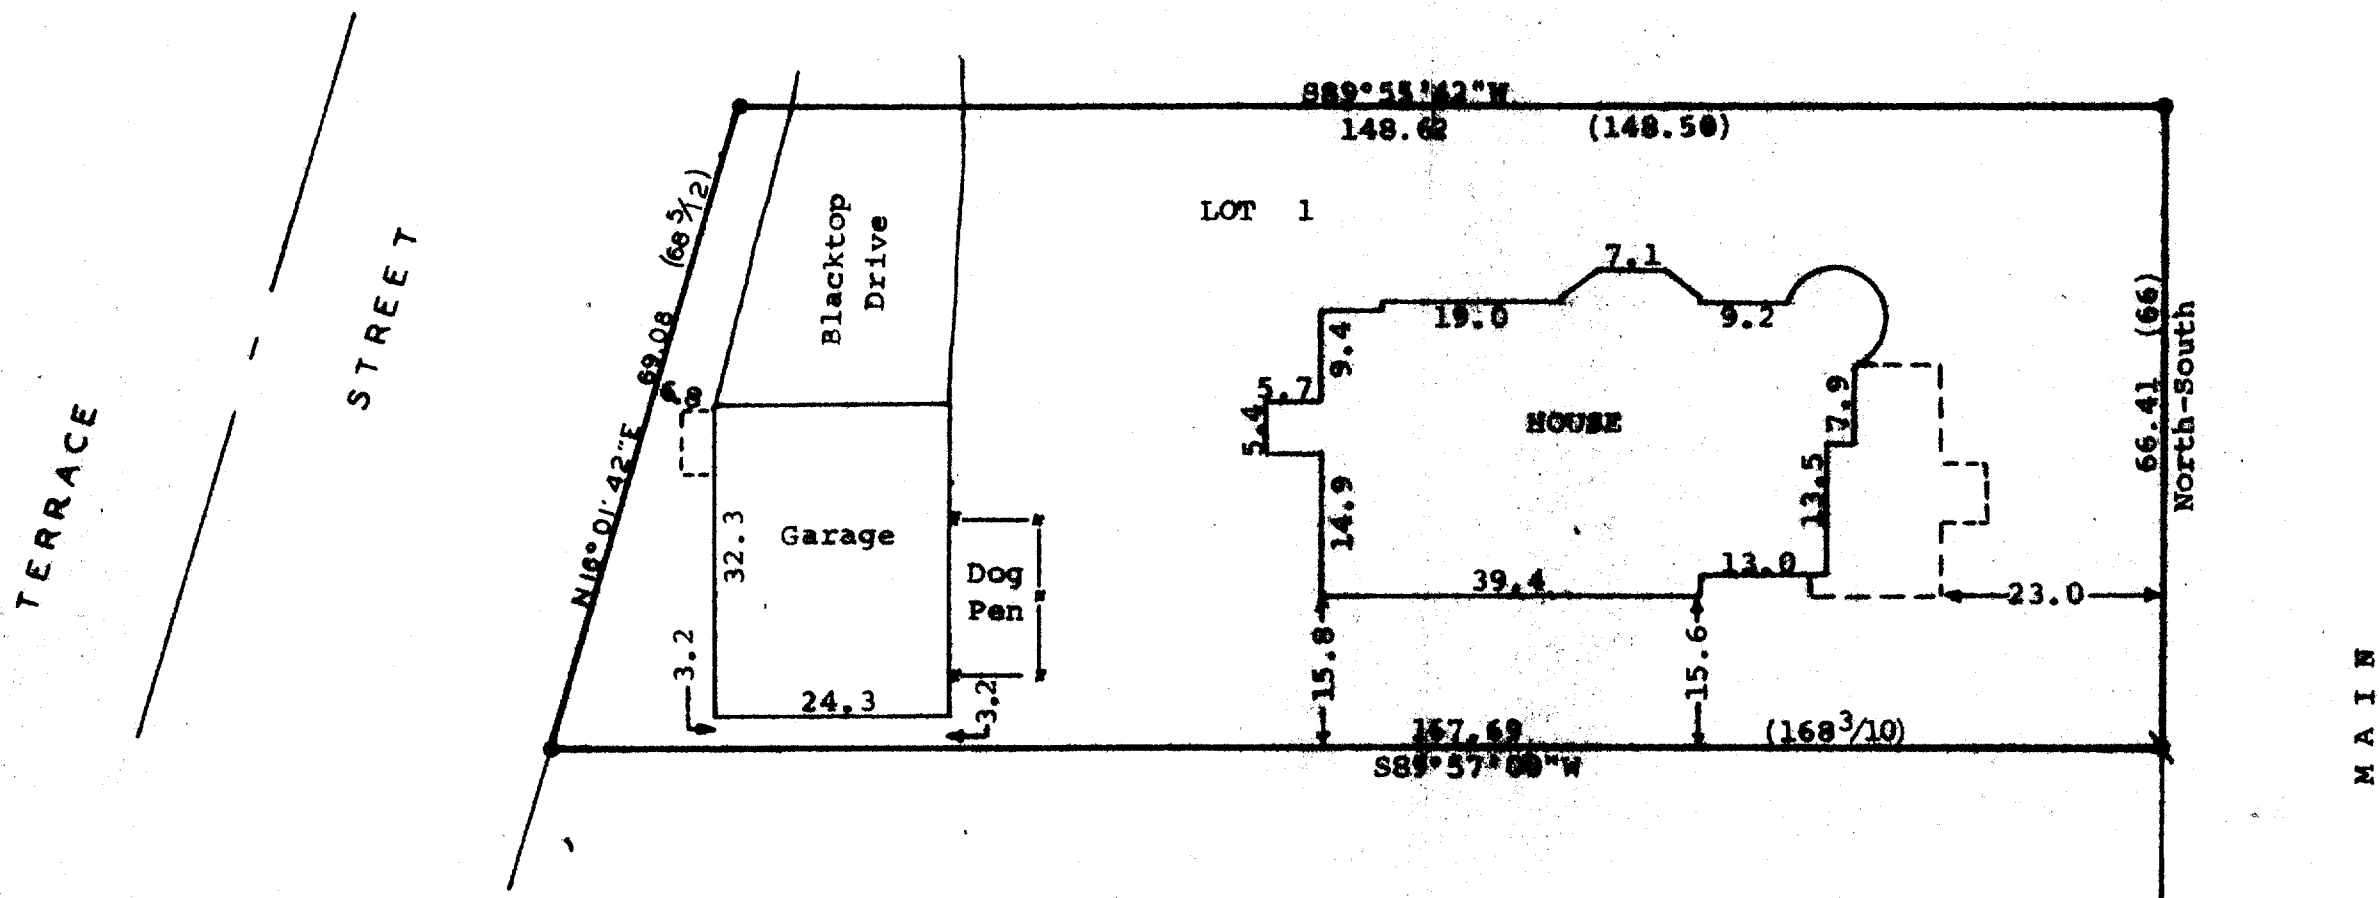

Owner: Nora Tifft
505 Alder Avenue
Delavan, Wisconsin 53115
Note: Bearings are based on the
West line of Main Street,
assumed bearing is North.

STATE OF WISCONSIN)
COUNTY OF WALWORTH) ss

I, James M. Dunham, Surveyor, certify that I have surveyed
the property described as follows,

Lot 1 of Block 15 of the Original Plat of the Village (now
City) of Delavan, Walworth County, Wisconsin,
and that the above map is a true representation thereof and shows the
size and location of the property, its exterior boundaries, the location
of all visible structures and dimensions of all principal buildings
thereon, boundary lines, apparent easements, roadways and visible
encroachments, if any.

This survey is made for the use of the present owners of the property,
and also those who purchase, mortgage, or guarantee the title thereto
within one (1) year from date hereof.

May 4, 1982

James M. Dunham
James M. Dunham, Surveyor

