


DUNHAM SURVEYING, S.C.
SURVEYING & SUBDIVIDING
DELAVER, WISCONSIN 53115

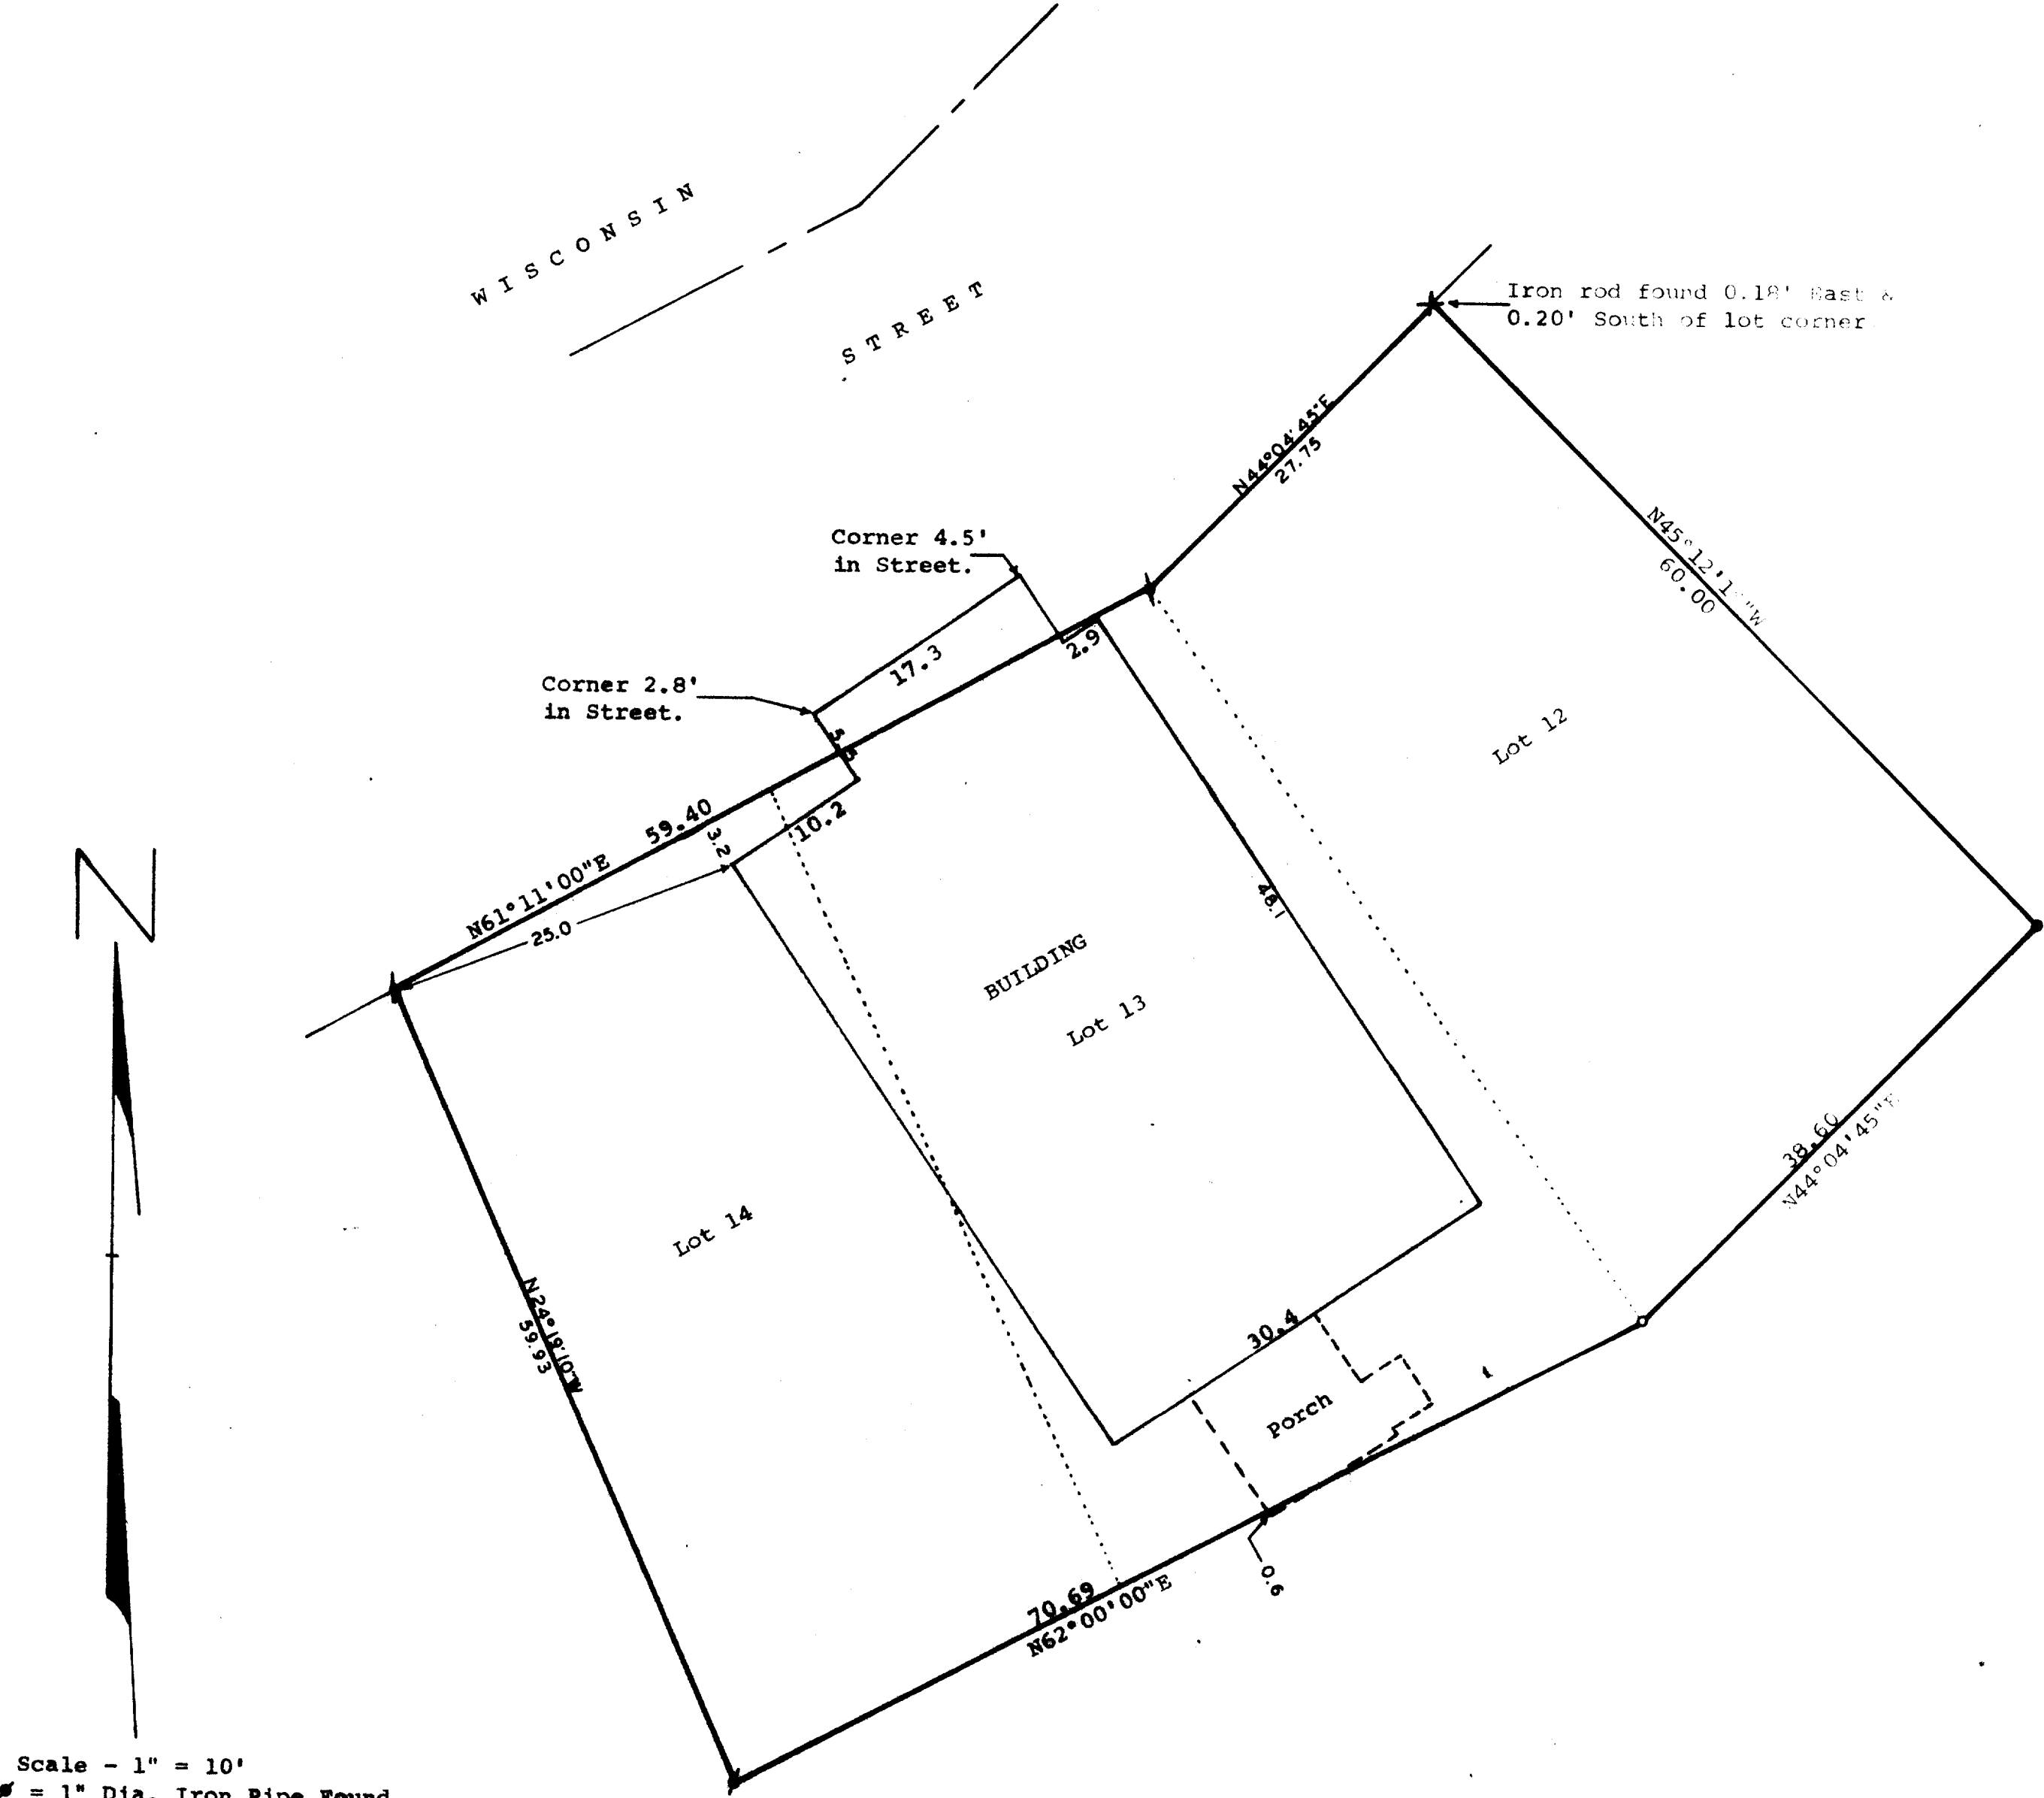

STATE OF WISCONSIN
COUNTY OF WALWORTH ss

I, James M. Dunham, Surveyor, certify that I have surveyed the property described as follows,

Lots 12, 13 and 14 of Block 9 of Passage, Aram, and Downie Addition to the City of Delavan, Walworth County, Wisconsin, and that the above map is a true representation thereof and shows the size and location of the property, its exterior boundaries, the location of all visible structures and dimensions of all principal buildings thereon, boundary fences, apparent easements, roadways and visible encroachments, if any.

This survey is made for the use of the present owners of the property, and also those who purchase, mortgage, or guarantee the title thereto within one (1) year from date hereof.

August 12, 1983

James M. Dunham
James M. Dunham, Surveyor

