




ROBERS & BOYD, INC.
CONSULTING ENGINEERS
LAND SURVEYORS

109 SOUTH SPRING STREET
BURLINGTON, WISCONSIN 53108
PHONE: 414-763-7834

PLAT OF SURVEY AND HOUSE LOCATION
FOR
FIRST STATE SAVINGS ASSOCIATION
OF

Commencing at a point 5 rods North of the Northeast corner of L.E. Downie's Addition to the Village, now City, of Delavan, Walworth County, Wisconsin, and running thence West 10 rods; thence North 11 rods; thence East to Terrace Street; thence Southerly along the Westerly line of Terrace Street to the place of beginning; excepting therefrom a parcel of land located in the Southwest 1/4 of Section 18, Town 2 North, Range 16 East, City of Delavan, Walworth County, Wisconsin, described as follows, to-wit: Beginning at a point on the Westerly line of Terrace Street where said line is intersected by a line drawn parallel with and 174.00 feet North of the North line of L. E. Downie's Addition to the City of Delavan; thence Westerly parallel with the North line of said L.E. Downie's Addition, 191.44 feet; thence North at right angles to said line 90.00 feet; thence Easterly parallel with said North line of L.E. Downie's Addition 217.44 feet to the Westerly line of Terrace Street; thence Southwesterly along said Westerly line 93.68 feet to the place of beginning.


Buyer: Robert J. and Rennee M. Sorensen, 230 South Terrace, Delavan, WI

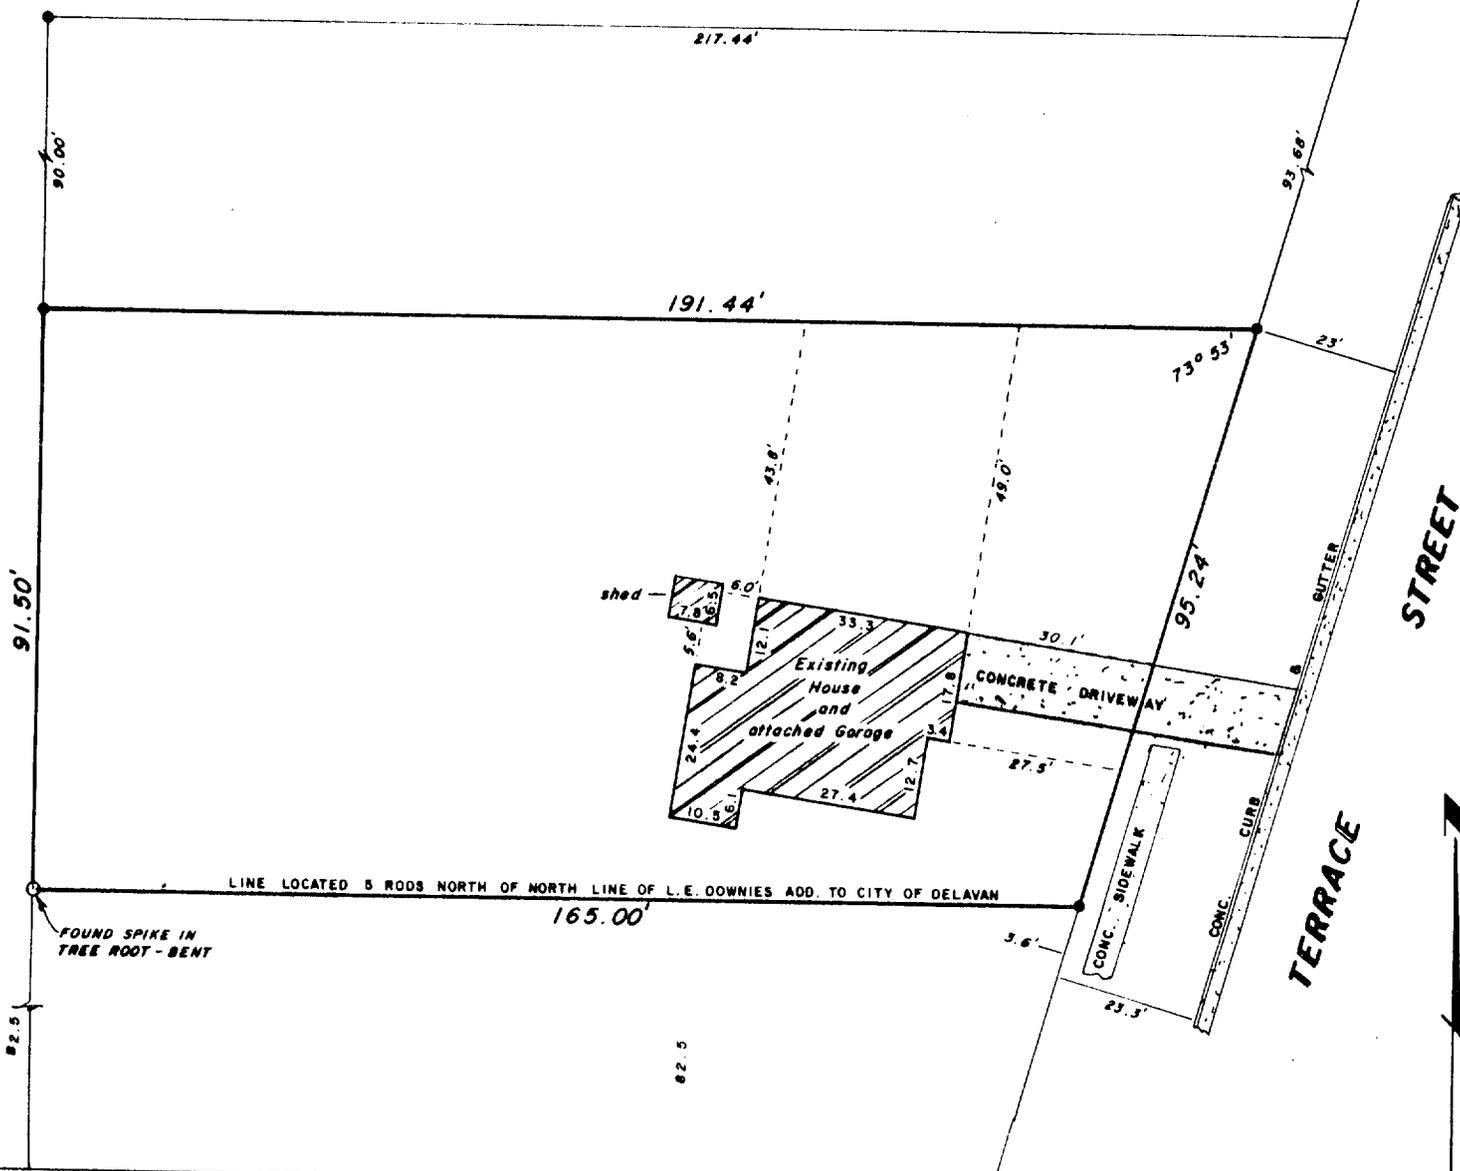

"I hereby certify that I have surveyed the above described property and that the above map is a true representation thereof and shows the size and location of the property, its exterior boundaries, the location of all visible structures and dimensions of all principal buildings thereon, boundary fences, apparent easements, roadways and visible encroachments, if any.

"This survey is made for the use of the present owners of the property, and also those who purchase, mortgage, or guarantee the title thereto within one year from date hereof."

NO MONUMENTATION HAS BEEN WAIVED IN ACCORDANCE WITH A-E 5.01(b) OF THE WISCONSIN ADMINISTRATIVE CODE.

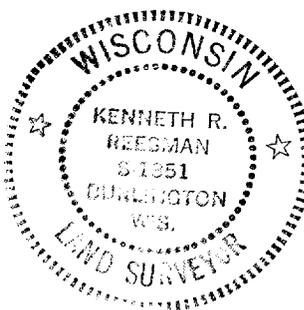

- LEGEND**
- + CHISEL CUT IN CONCRETE
 - o PK NAIL
 - FOUND IRON PIPE - 1-1/4"
 - FOUND IRON PIPE - 1-1/2"
 - SET IRON PIPE - 1-1/2"
 - FOUND BRASS CAPPED MONUMENT
 - ⊕ FOUND CONCRETE MONUMENT
 - FENCE
 - () RECORDED AS
 - EXISTING GROUND ELEVATION

SCALE - 1" = 30'

Kenneth R. Reesman
WISCONSIN REGISTERED LAND SURVEYOR

1-4-83
DATE

FIELD WORK BY KRR & GJA

DRAWN BY GJA

83002

JOB NUMBER

K&E WBP-125

2-658-R