

DUNHAM SURVEYING, S.C.
SURVEYING & SUBDIVISION
DELAVER, WISCONSIN 53115




Scale - 1" = 20'
o = 3/4" Dia. Iron Pipe

Owner: Ralph Gluesing
121 Elm Street
Delavan, WI 53115

Bearings referenced to the east line
of Elm Street. Assumed bearing is
North-South.

STREET

ELM

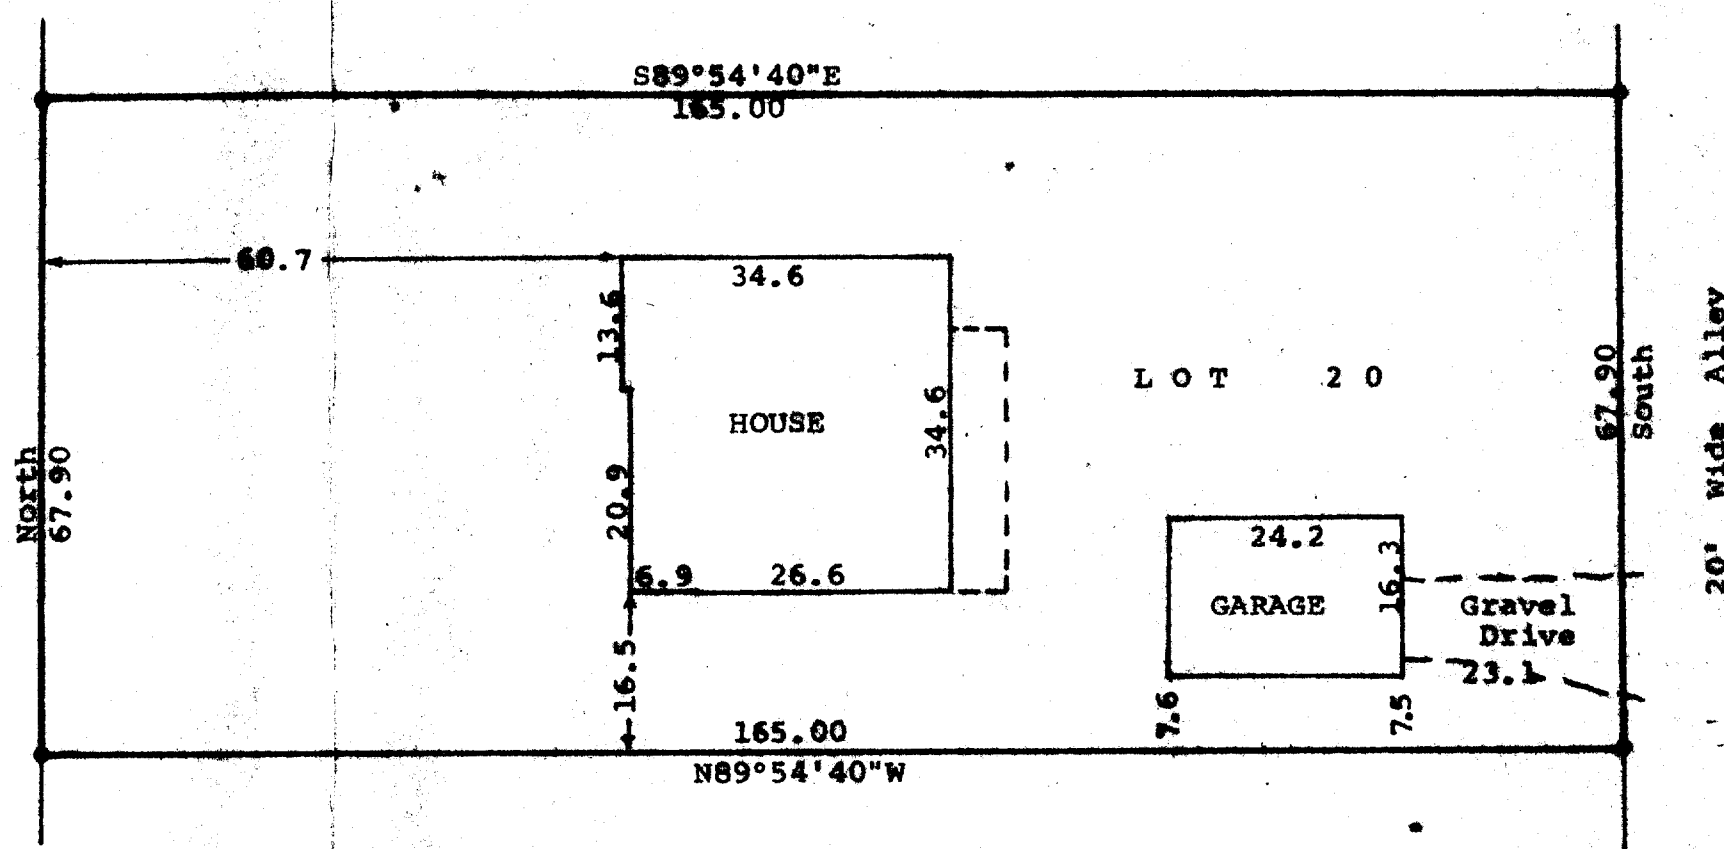

STATE OF WISCONSIN)
COUNTY OF WALWORTH) SS

I, James M. Dunham, Surveyor, certify that I have surveyed the
property described as follows,

Lot 20, Block 4 of F. K. Phoenix West Addition to the City of
Delavan, Walworth County, Wisconsin,

and that the above map is a true representation thereof and shows the size
and location of the property, its exterior boundaries, the location of all
visible structures and dimensions of all principal buildings thereon,
boundary fences, apparent easements, roadways and visible encroachments,
if any.

This survey is made for the use of the present owners of the property,
and also those who purchase, mortgage, or guarantee the title thereto
within one (1) year from date hereof.

September 21, 1982

James M. Dunham
James M. Dunham, Surveyor

