


DUNHAM SURVEYING, S. C.
SURVEYING & SUBDIVIDING
DELAVER, WISCONSIN 53115

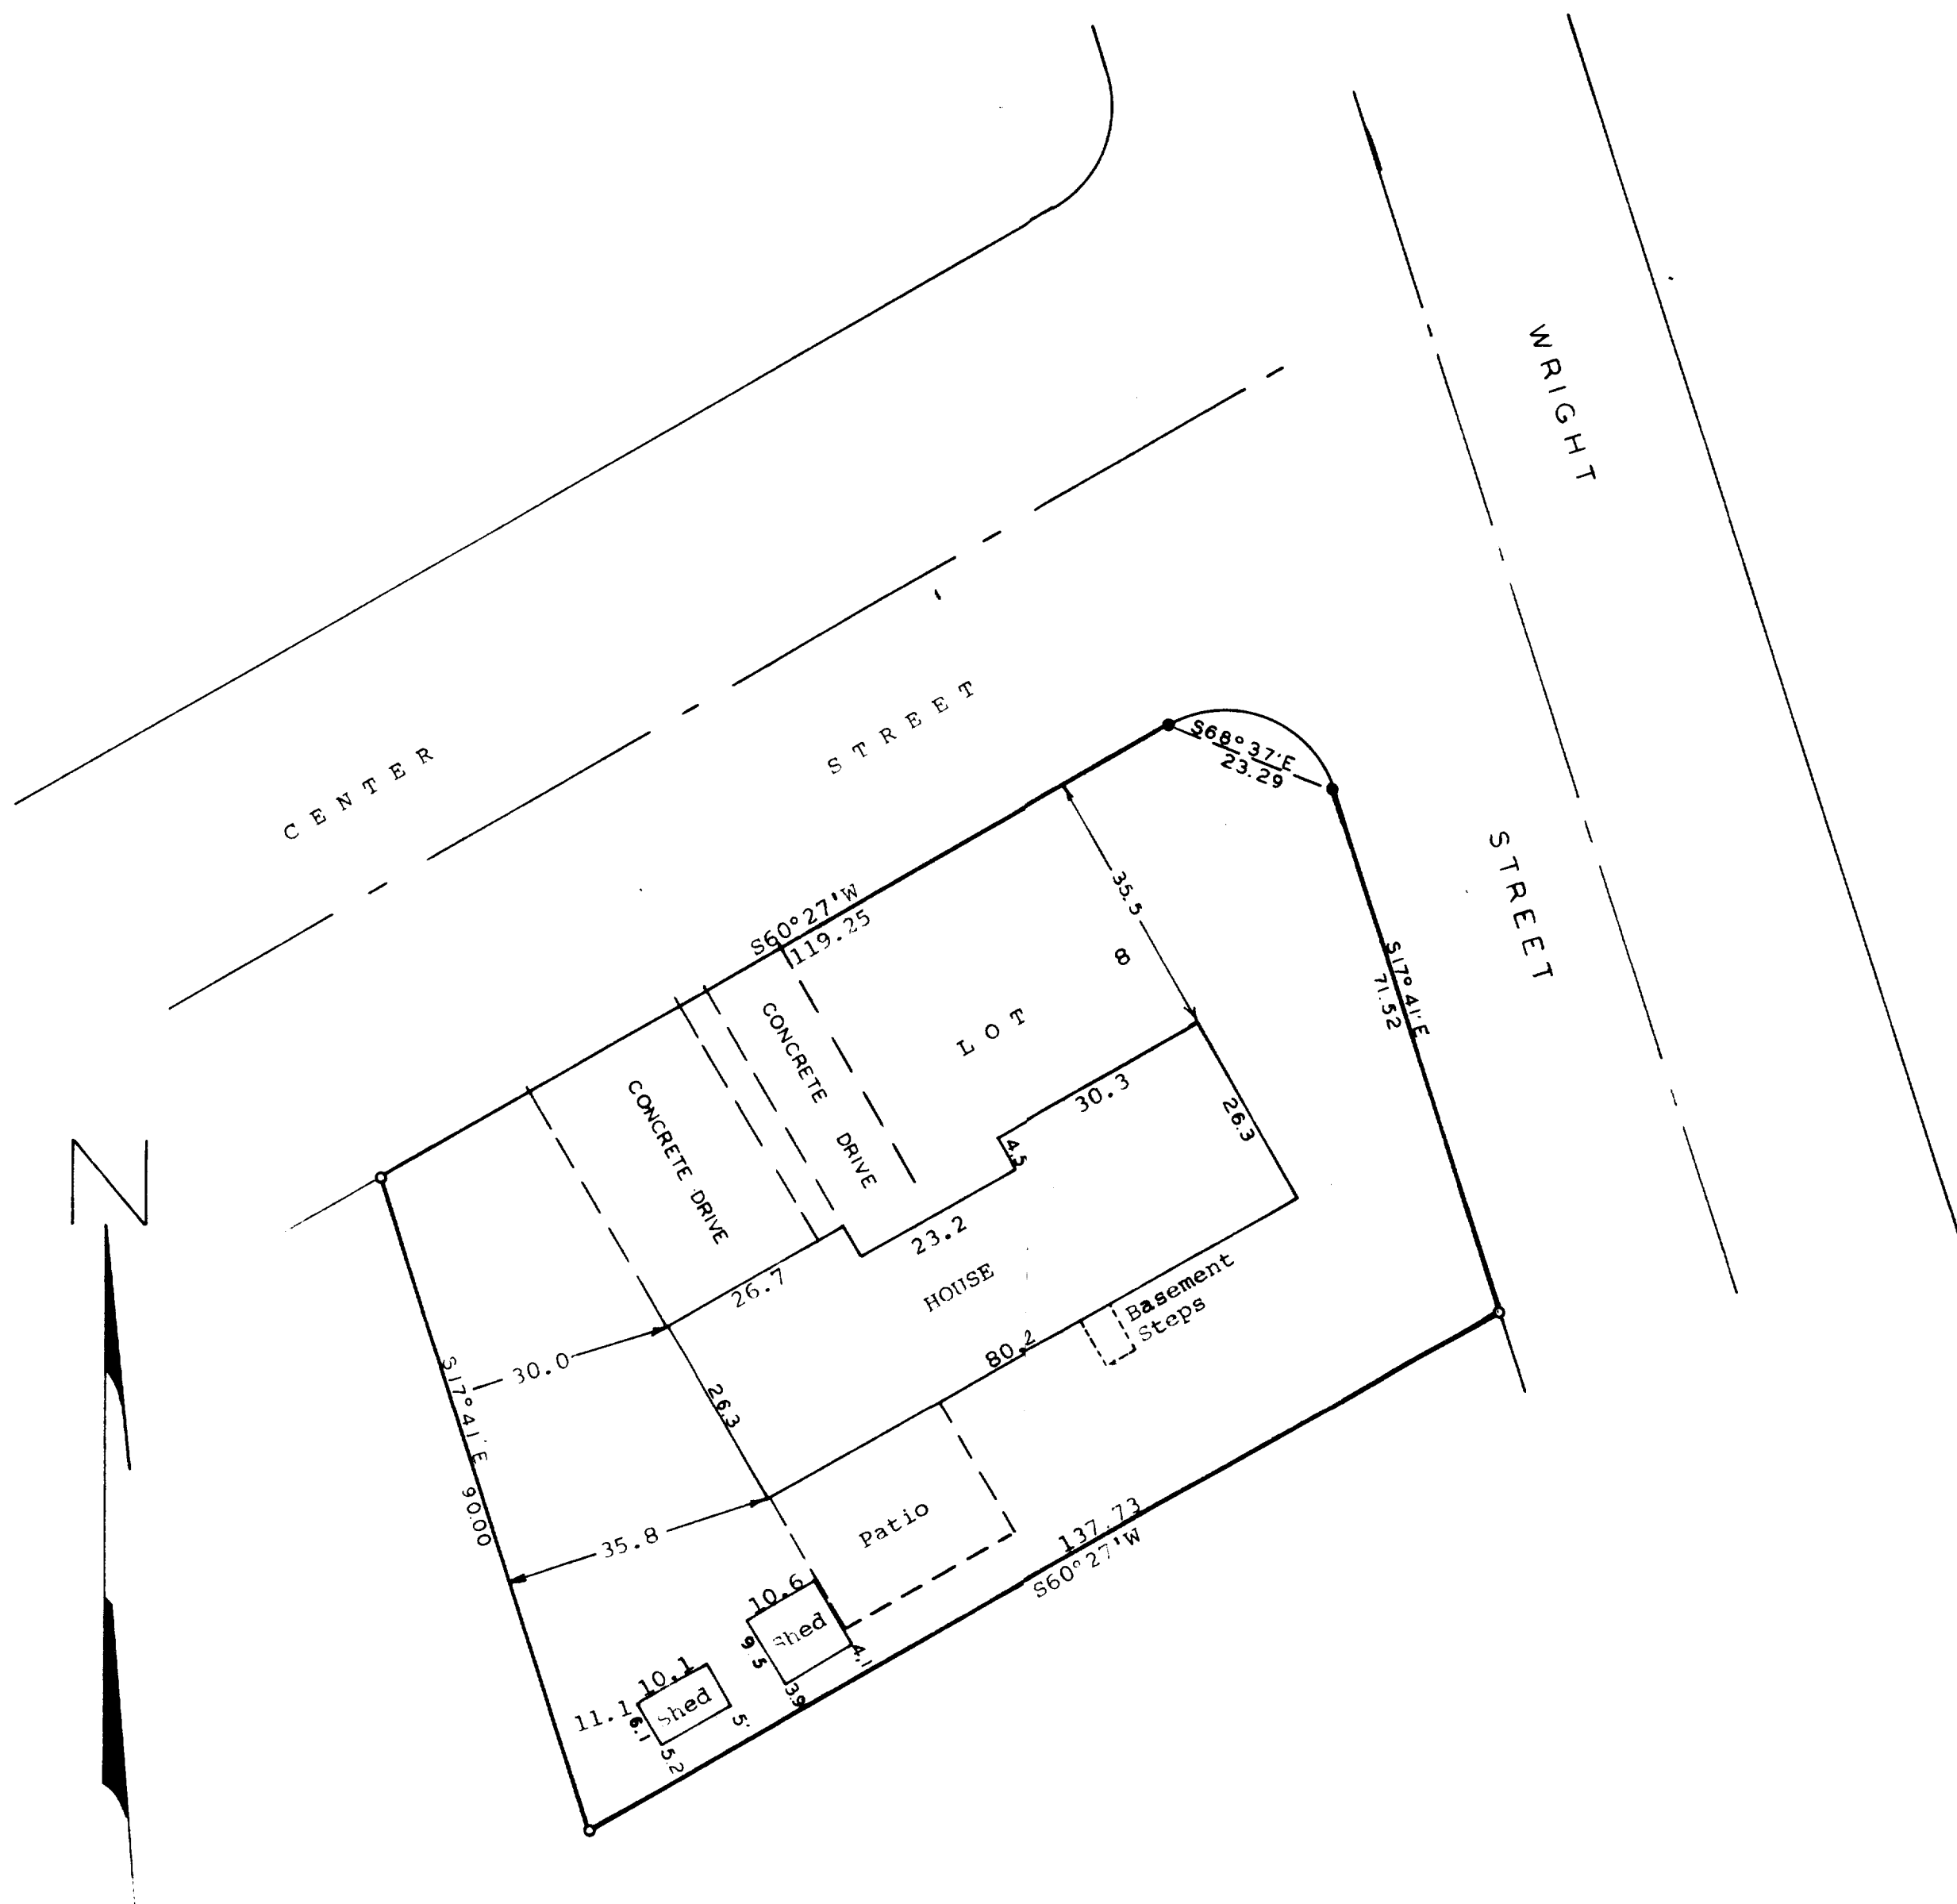

Scale: - 1" = 20'
 ○ = Iron Pipe Found
 ● = Concrete Monument Found
 Bearings are those of record
 Owner: Gene Showers
 1298 Center Street
 Delavan, WI 53115

STATE OF WISCONSIN)
 COUNTY OF WAUWATOSH)

I, James M. Dunham, Surveyor, certify that I have surveyed
 the property described as follows:

Lot 6 of Wright's Subdivision located in the City of Delavan,
 Walworth County, Wisconsin,

and that the above map is a true representation thereof and shows the
 size and location of the property, its exterior boundaries, the location
 of all visible structures and dimensions of all principal buildings
 thereon, boundary fences, apparent easements, roadways and visible
 encroachments, if any.

This survey is made for the use of the present owners of the property
 and also those who purchase, mortgage or guarantee the title thereto
 within one (1) year from date hereof.

April 29, 1982

James M. Dunham
 James M. Dunham, Surveyor

