


KOLB LAND CONSULTING, INC.
LAND SURVEYING • SUBDIVIDING • LAND PLANNING

LAKE GENEVA, WISCONSIN 53147

WHITEWATER, WISCONSIN 53190

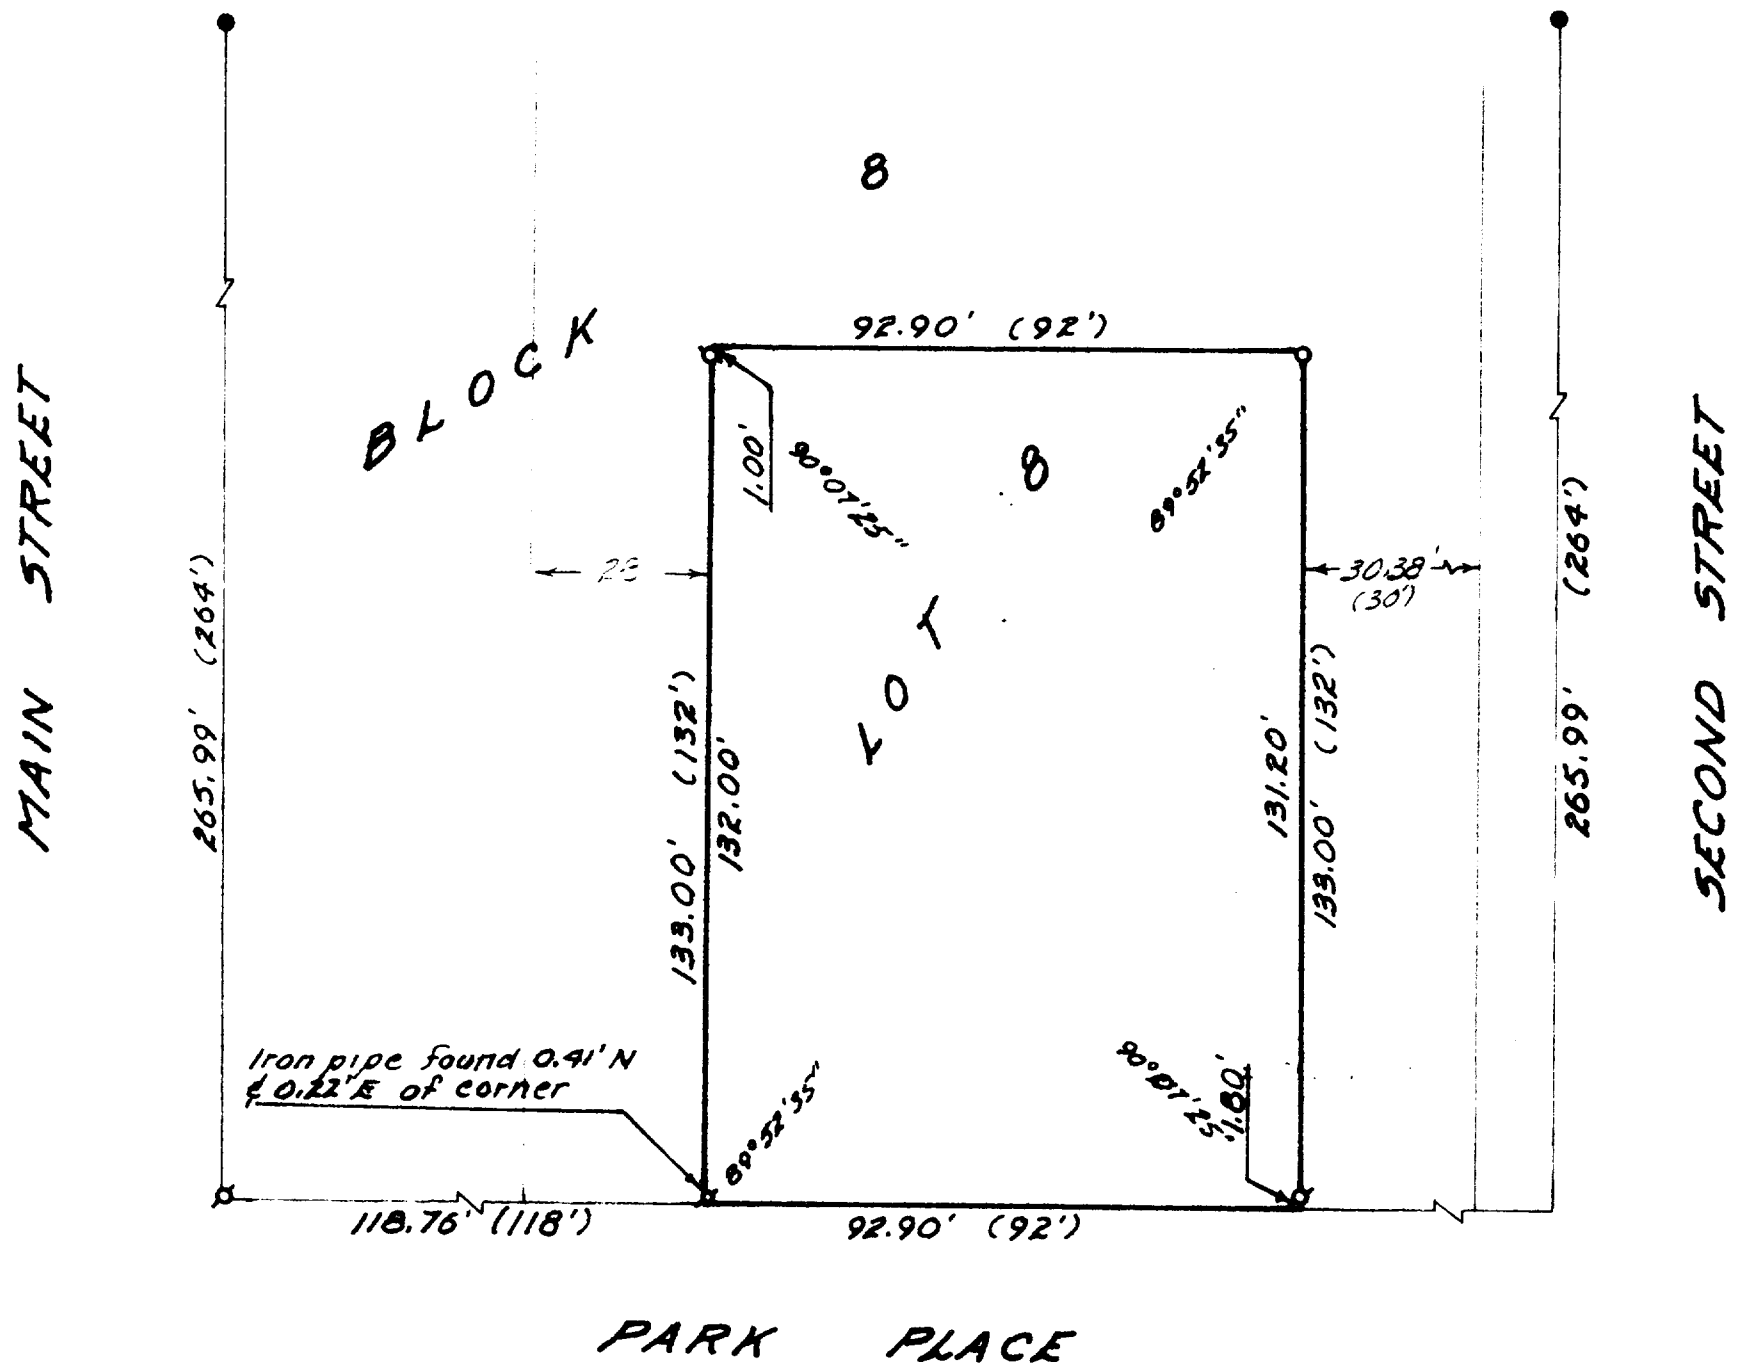

PARK PLACE

PLAT OF SURVEY OF


PART OF LOT 8, BLOCK 8, ORIGINAL PLAT OF THE VILLAGE, NOW CITY OF DELAVAN, WALWORTH COUNTY, WISCONSIN.

ORDERED BY: DON JOHNSON
COMBINED REALTY
DELAVAN, WI. 53115
FOR: THOMAS R. DEROT



SCALE: 1"=30'

- LEGEND
- IRON PIPE FOUND
 - IRON PIPE SET
 - CONCRETE MONUMENT FOUND
 - () AS RECORDED

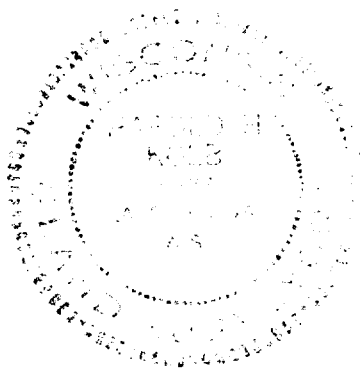

I, HAROLD H. KOLB, DO HEREBY CERTIFY THAT I HAVE SURVEYED THE PROPERTY HEREON DESCRIBED ACCORDING TO THE OFFICIAL RECORDS, AND THAT THE PLAT HEREON IS A CORRECT REPRESENTATION OF THE LOT LINES TO THE BEST OF MY KNOWLEDGE AND BELIEF.

Harold H. Kolb

WISCONSIN REGISTERED LAND SURVEYOR, S-187
DATE NOVEMBER 30, 1982

XOP-51

2-662-K