


KOLB LAND CONSULTING, INC.
LAND SURVEYING • SUBDIVIDING • LAND PLANNING

LAKE GENEVA, WISCONSIN 53147

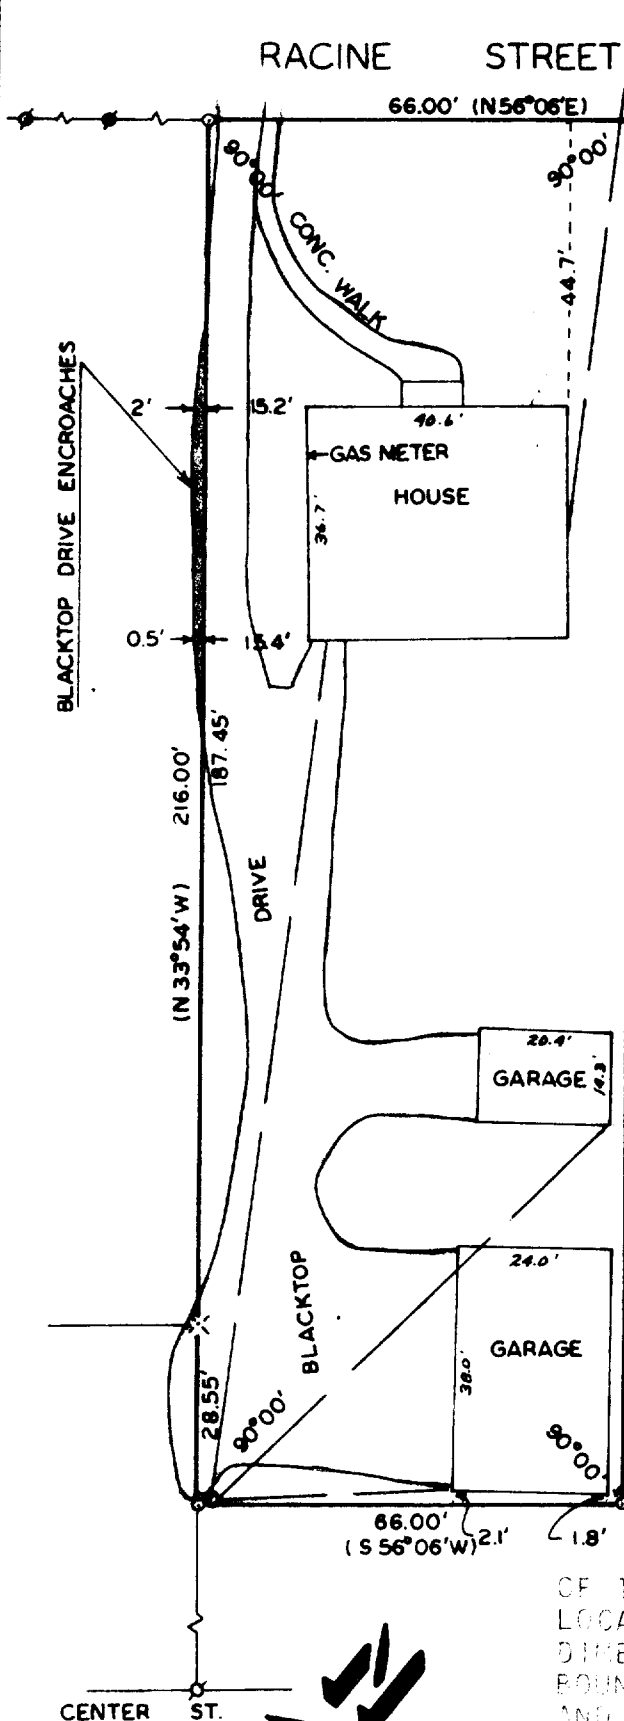

POINT DESCRIBED AS BEING N 56°06'E 6 CHAINS 38 LINKS FROM INTERSECTION OF NORTH-SOUTH 1/8 LINE OF THE NORTHWEST 1/4 OF SEC. 17-2-16, CITY OF DELAVAN

PLAT OF SURVEY OF

A PARCEL OF LAND LOCATED IN THE NORTHWEST 1/4 OF SECTION 17, T2N, R16E, CITY OF DELAVAN, WALWORTH COUNTY, WISCONSIN.

ORDERED BY: SECURITY SAVINGS
P.O. BOX 15401
MILWAUKEE, WI 53215

OWNER: JAMES & SHERRY SCHEURELL
926 RACINE ST.
DELAVAN, WI 53115

LEGEND

- ⊙ - IRON PIPE FOUND
- - IRON PIPE SET
- ⊙ - IRON ROD FOUND
- ⊙ - IRON BOLT FOUND
- - OVERHEAD UTILITY LINES
- Δ - UTILITY POLE
- () - RECORDED AS
- × - SPIKE FOUND

I HEREBY CERTIFY THAT I HAVE SURVEYED THE ABOVE DESCRIBED PROPERTY AND THAT THE ABOVE MAP IS A TRUE REPRESENTATION THEREOF AND SHOWS THE SIZE AND LOCATION OF THE PROPERTY, ITS EXTERIOR BOUNDARIES, THE LOCATION OF ALL VISIBLE STRUCTURES AND DIMENSIONS OF ALL PRINCIPAL BUILDINGS THEREON, BOUNDARY FENCES, APPARENT EASEMENTS, ROADWAYS AND VISIBLE ENCROACHMENTS, IF ANY.

THIS SURVEY IS MADE FOR THE USE OF THE PRESENT OWNERS OF THE PROPERTY, AND ALSO THOSE WHO PURCHASE, MORTGAGE, OR GUARANTEE THE TITLE THERETO WITHIN ONE (1) YEAR FROM DATE HEREOF.

Harold H. Kolb

HAROLD H. KOLB
WISCONSIN REGISTERED LAND SURVEYOR, S-187
DATE NOVEMBER 9, 1983

XWUP-28

2-665-K