


KOLB LAND CONSULTING, INC.
LAND SURVEYING • SUBDIVIDING • LAND PLANNING

LAKE GENEVA, WISCONSIN 53147

PHOENIX STREET 66' WIDE

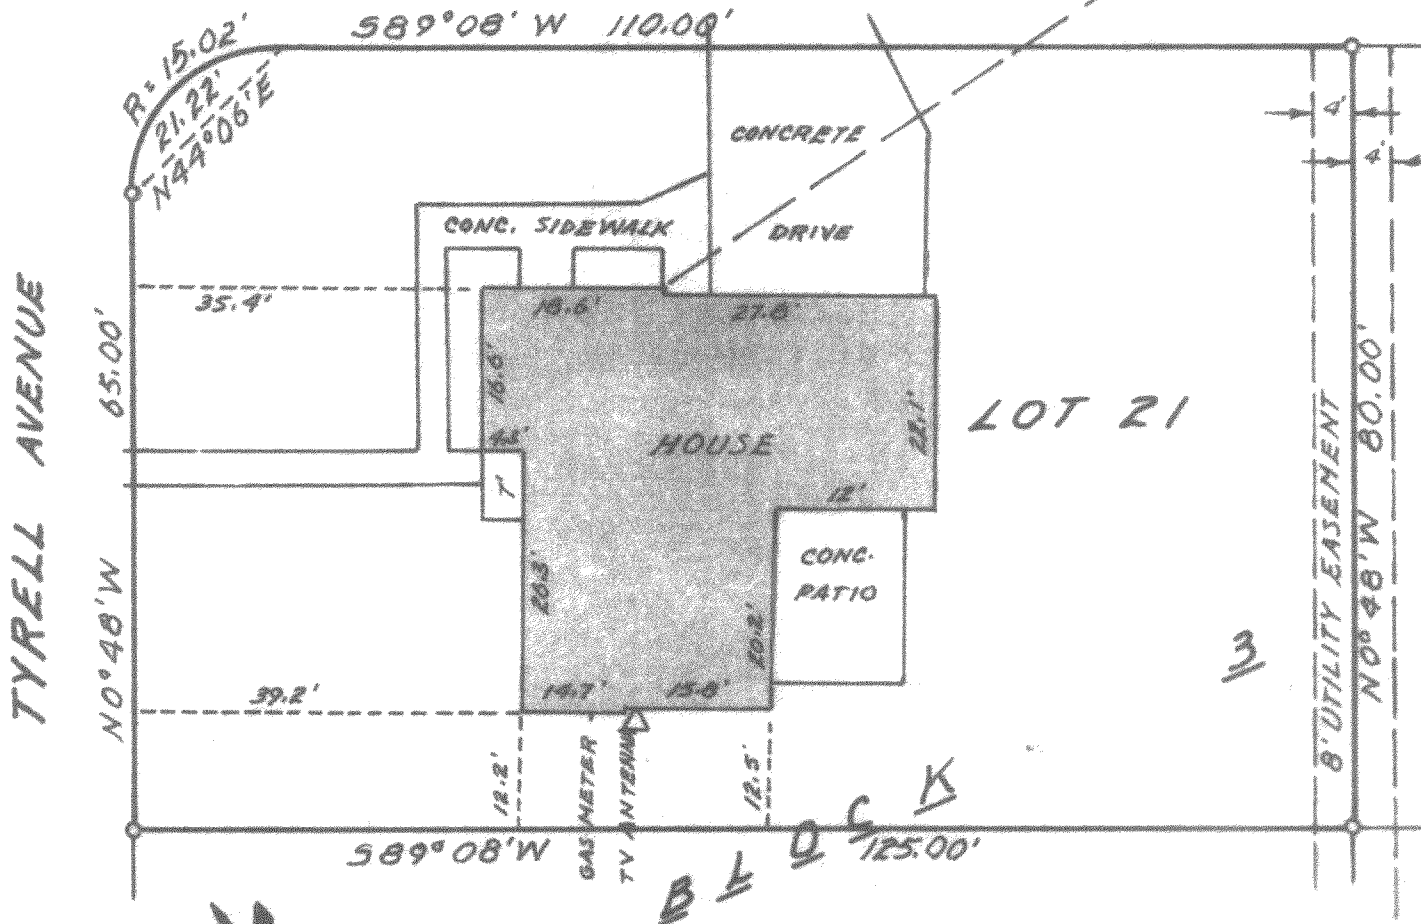

PLAT OF SURVEY OF
LOT 21, BLOCK 3, ALLYNHURST SUBDIVISION, LOCATED
IN THE SOUTHWEST 1/4 OF SECTION 17 AND IN
THE NORTHWEST 1/4 OF SECTION 20, T 2 N, R 17 E,
CITY OF DELAVAN, WALWORTH COUNTY, WISCONSIN.

SCALE: 1"=20'

LEGEND


○ IRON PIPE FOUND

ORDERED BY:
I.D.L. MORTGAGE CORP.
P.O. BOX 1256
KENOSHA, WI. 53141
FOR:
RONALD & JEAN TIPPITT

NOTE:
THE PLACEMENT OF MON-
UMENTS HAS BEEN WAIVED
BY THE CLIENT AS PER-
MITTED IN A-E 5.01(B).

I HEREBY CERTIFY THAT I HAVE SURVEYED THE
ABOVE DESCRIBED PROPERTY AND THAT THE ABOVE
MAP IS A TRUE REPRESENTATION THEREOF AND
SHOWS THE SIZE AND LOCATION OF THE PROPERTY,
ITS EXTERIOR BOUNDARIES, THE LOCATION OF ALL
VISIBLE STRUCTURES AND DIMENSIONS OF ALL
PRINCIPAL BUILDINGS THEREON, BOUNDARY FENCES,
APPARENT EASEMENTS, ROADWAYS AND VISIBLE
ENCROACHMENTS, IF ANY.

THIS SURVEY IS MADE FOR THE USE OF THE
PRESENT OWNERS OF THE PROPERTY, AND ALSO
THOSE WHO PURCHASE, MORTGAGE, OR GUARANTEE
THE TITLE THERETO WITHIN ONE (1) YEAR FROM
THE DATE HEREOF.

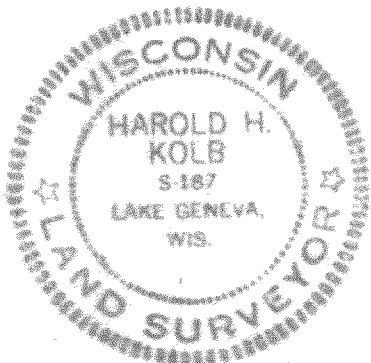

Harold H. Kolb

WISCONSIN REGISTERED LAND SURVEYOR, S-187
DATE MARCH 19, 1983