


KOLB LAND CONSULTING, INC.
LAND SURVEYING • SUBDIVIDING • LAND PLANNING

LAKE GENEVA, WISCONSIN 53147

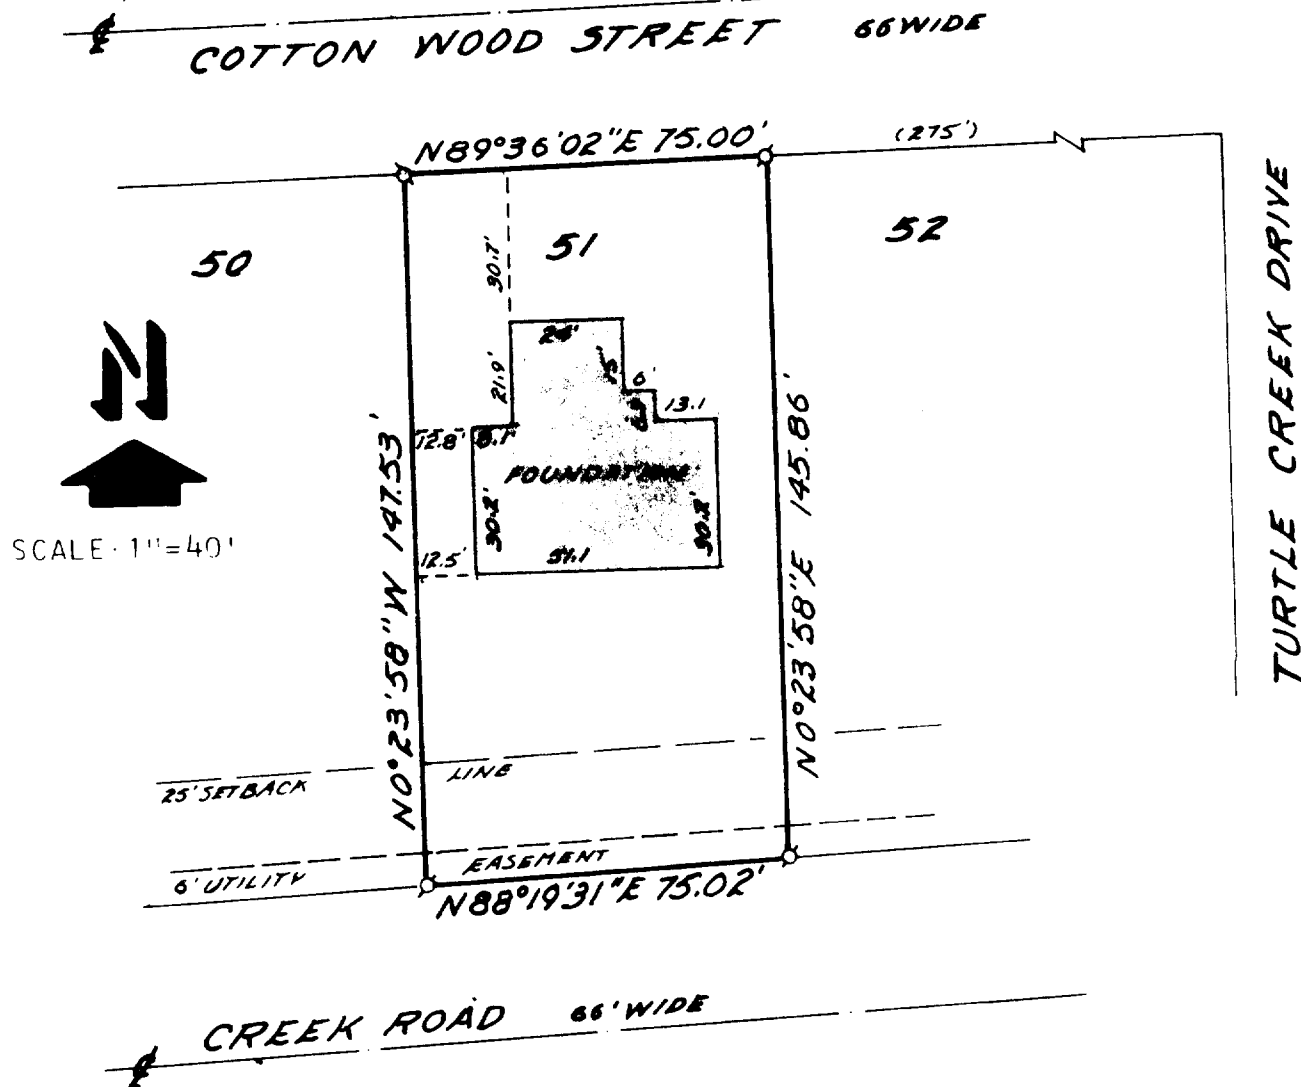

PLAT OF SURVEY OF

LOT 51, TURTLE CREEK, A SUBDIVISION LOCATED IN THE SOUTH-
EAST 1/4 OF SECTION 13, T 2 N, R 15 E, CITY OF DELAVAN,
WALWORTH COUNTY, WISCONSIN.

ORDERED BY: ANCHOR SAVINGS & LOAN ASSOCIATION
P.O. BOX 346
DELAVAN, WI. 53115

NOTE: BEARINGS ARE ASSUMED AS SHOWN ON THE RECORDED PLAT
OF TURTLE CREEK.

LEGEND
p IRON PIPE FOUND
(7) AS RECORDED

I, HAROLD H. KOLB, DO HEREBY CERTIFY
THAT I HAVE SURVEYED THE PROPERTY
HEREON DESCRIBED ACCORDING TO THE
OFFICIAL RECORDS, AND THAT THE PLAT
HEREON IS A CORRECT REPRESENTATION
OF THE LOT LINES AND THE PRINCIPAL
LINES OF THE BUILDINGS THEREON TO THE
BEST OF MY KNOWLEDGE AND BELIEF.

Harold H. Kolb

HAROLD H. KOLB
WISCONSIN REGISTERED LAND SURVEYOR, S- 187
DATE JUNE 12, 1984

2-669-K^v