


DUNHAM SURVEYING, S.C.
SURVEYING & SUBDIVIDING
DELAVER, WISCONSIN 53115

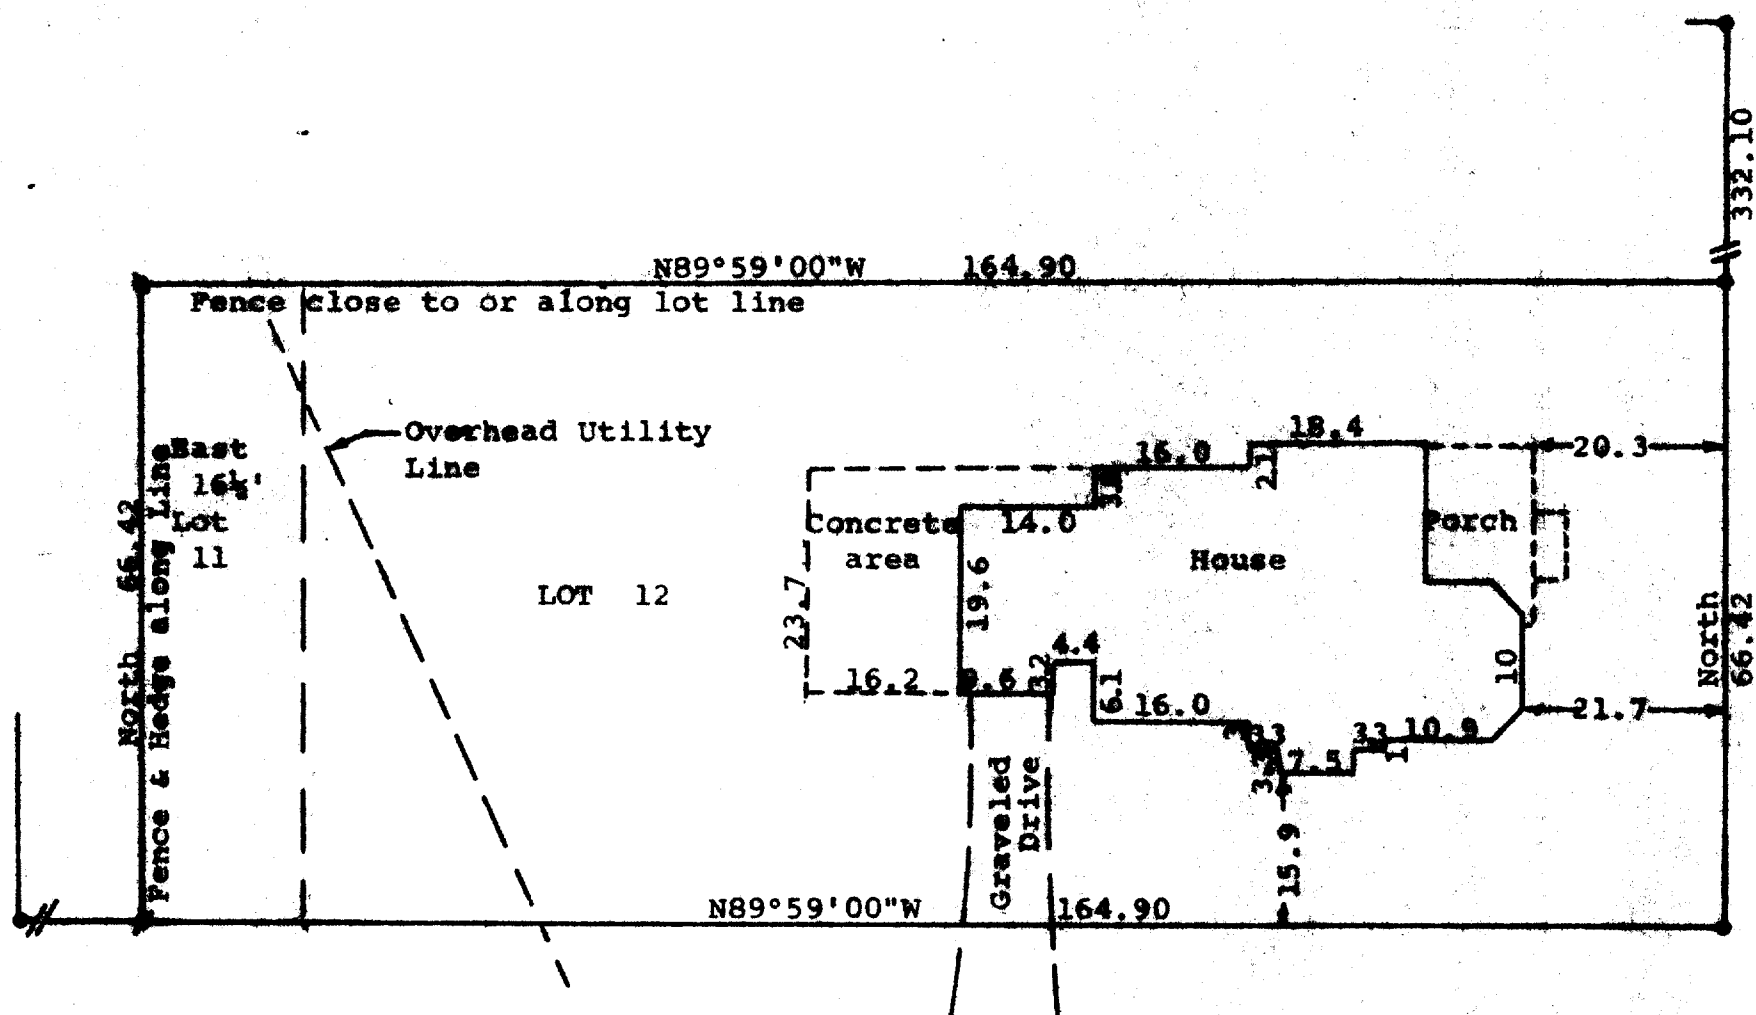

MATTHEW

STREET

MAIN

STREET



Scale - 1" = 20'
e = Concrete Monument Found
o = 1" Iron Pipe Found
s = 3/4" Iron Pipe Found
u = 1/2" Iron Pipe Set in Old Stump of Tree
Bearings referenced to the West Line of Main Street with the Assumed Bearing of North
Owner: Lavina Piersen
Delavan, WI 53115

STATE OF WISCONSIN)
COUNTY OF WALWORTH)

I, George T. Dunham, Surveyor, certify that I have surveyed the property described as follows:
Lot 12 and the East 16.50 feet of Lot 11, Block 22 of the Original Plat of the Village, (Now City) of Delavan, Walworth County, Wisconsin,

and that the above map is a true representation thereof and shows the size and location of the property, its exterior boundaries, the location of all visible structures and dimensions of all principal buildings thereon, boundary fences, apparent easements, roadways and visible encroachments, if any, and that I have surveyed the property hereon described according to the official records, to the best of my knowledge and belief.
May 16, 1983

George T. Dunham
George T. Dunham, Surveyor

