


DUNHAM SURVEYING, S. C.
SURVEYING & SUBDIVISION
DELAVER, WISCONSIN 53115

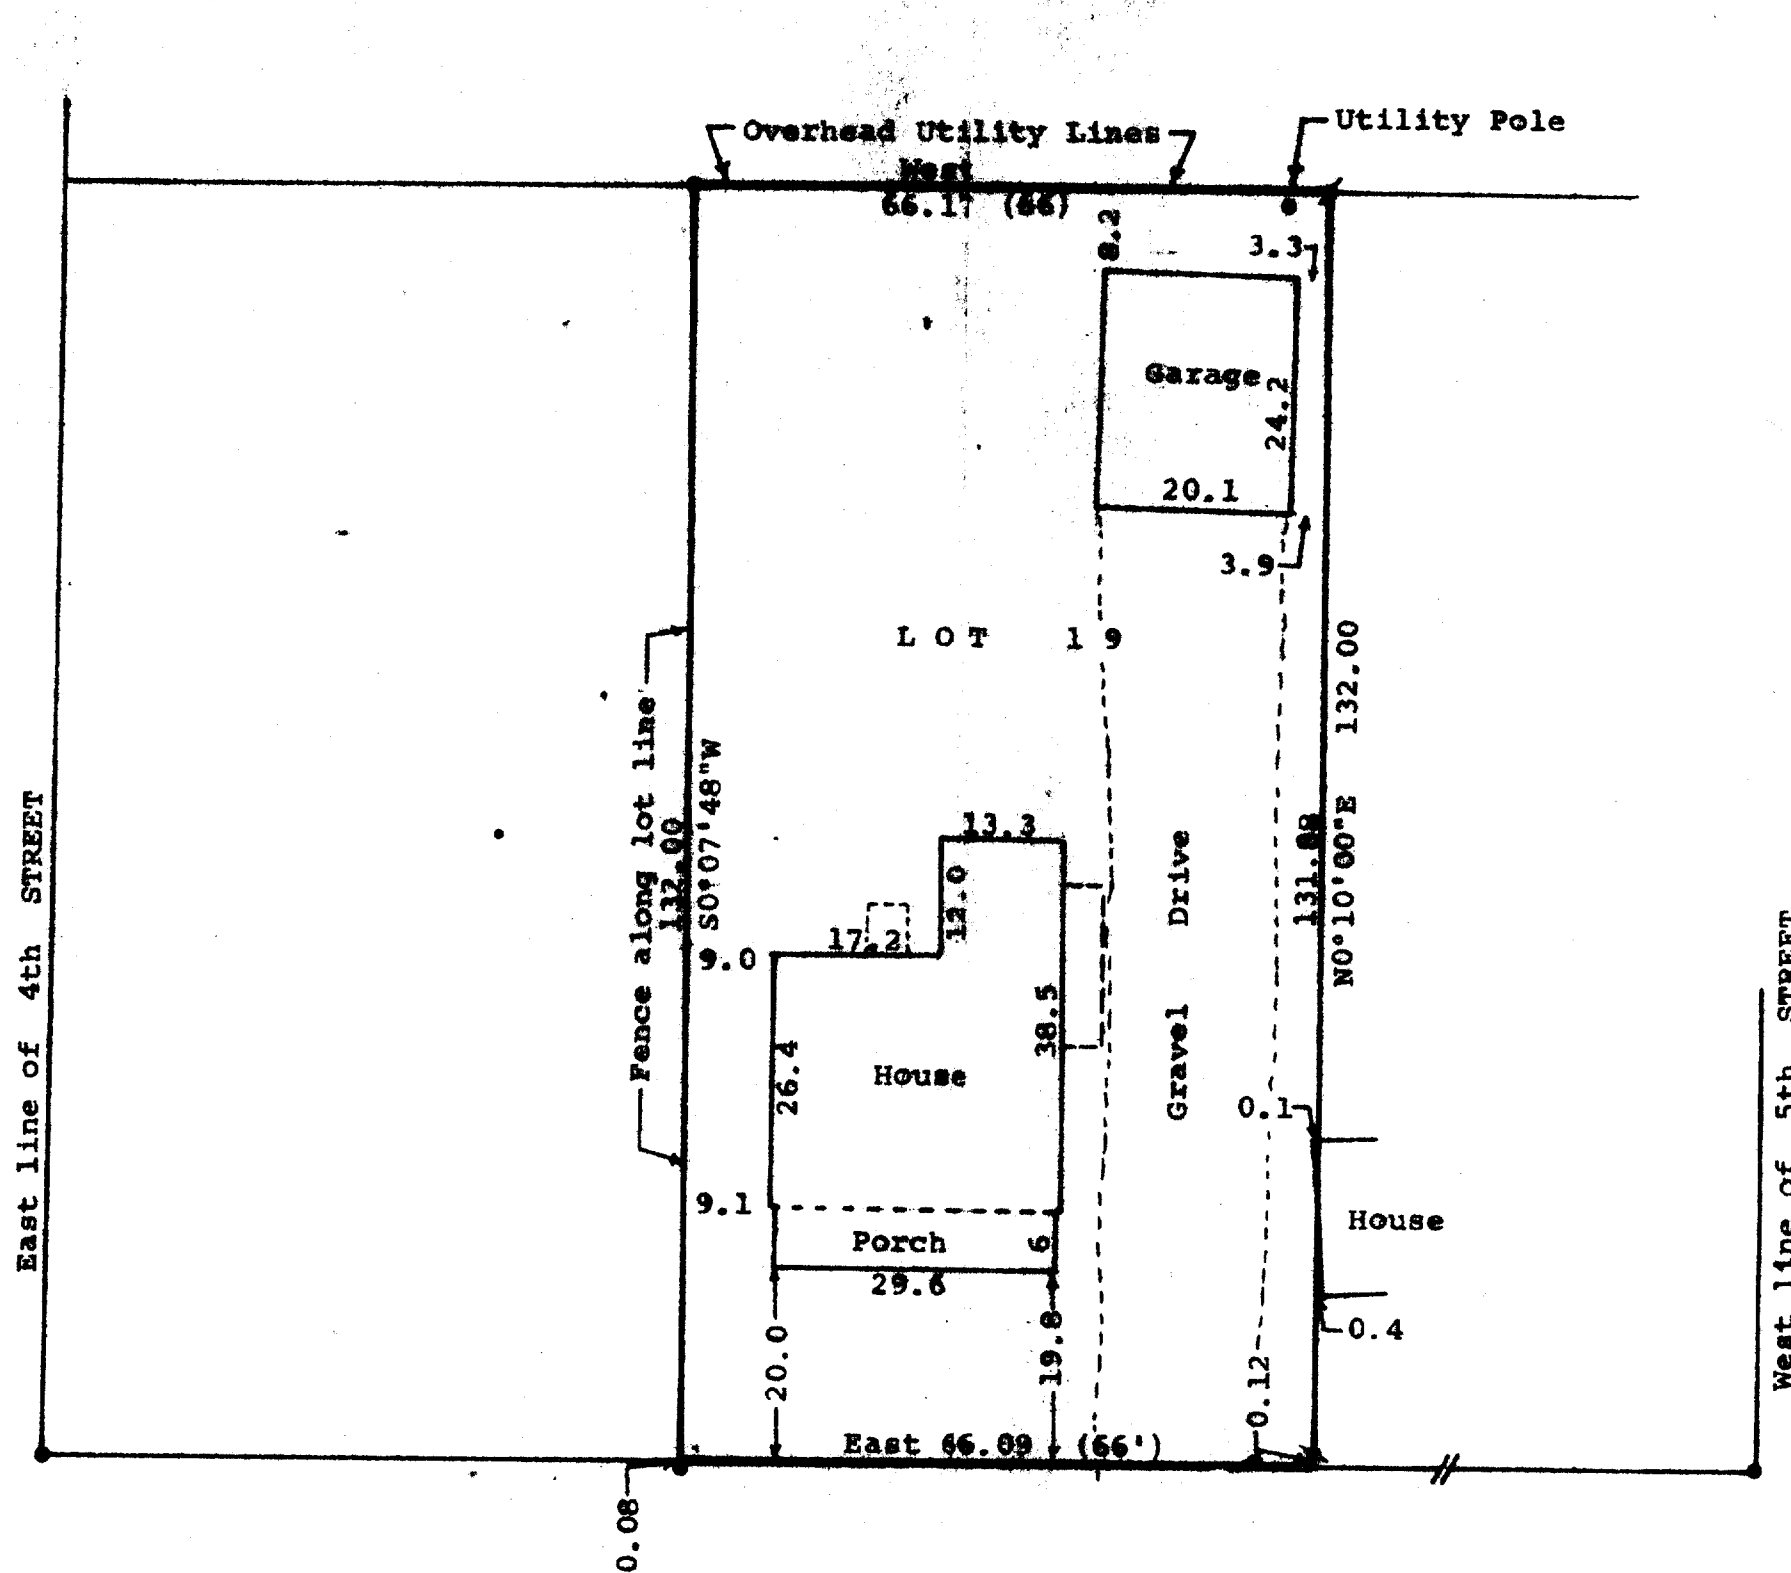

GENEVA

STREET

STATE OF WISCONSIN)
COUNTY OF WALWORTH) ss

I, George T. Dunham, Surveyor, certify that I have surveyed the property described as follows,
Lot 19, Block 3 of Passage, Aram and Downies Addition to the Village (now City) of Delavan, Walworth County, Wisconsin.

and that the above map is a true representation thereof and shows the size and location of the property, its exterior boundaries, the location of all visible structures and dimensions of all principal buildings thereon, boundary fences, apparent easements, roadways and visible encroachments, if any.

This survey is made for the use of the present owners of the property, and also those who purchase, mortgage, or guarantee the title thereto within one (1) year from date hereof.

November 4, 1962

George T. Dunham
George T. Dunham, Surveyor

