

COOPER SURVEYING SERVICES


Rural - Residential - Commercial

DANIEL D. COOPER
Registered Land Surveyor

Route 3, Box 255 :: Elkhorn, Wisconsin 53121

Phone (414) 723-6265

SURVEYING & PLANNING
SUBDIVISIONS - LOT SURVEYS
CONSTRUCTION STAKING - MAPPING

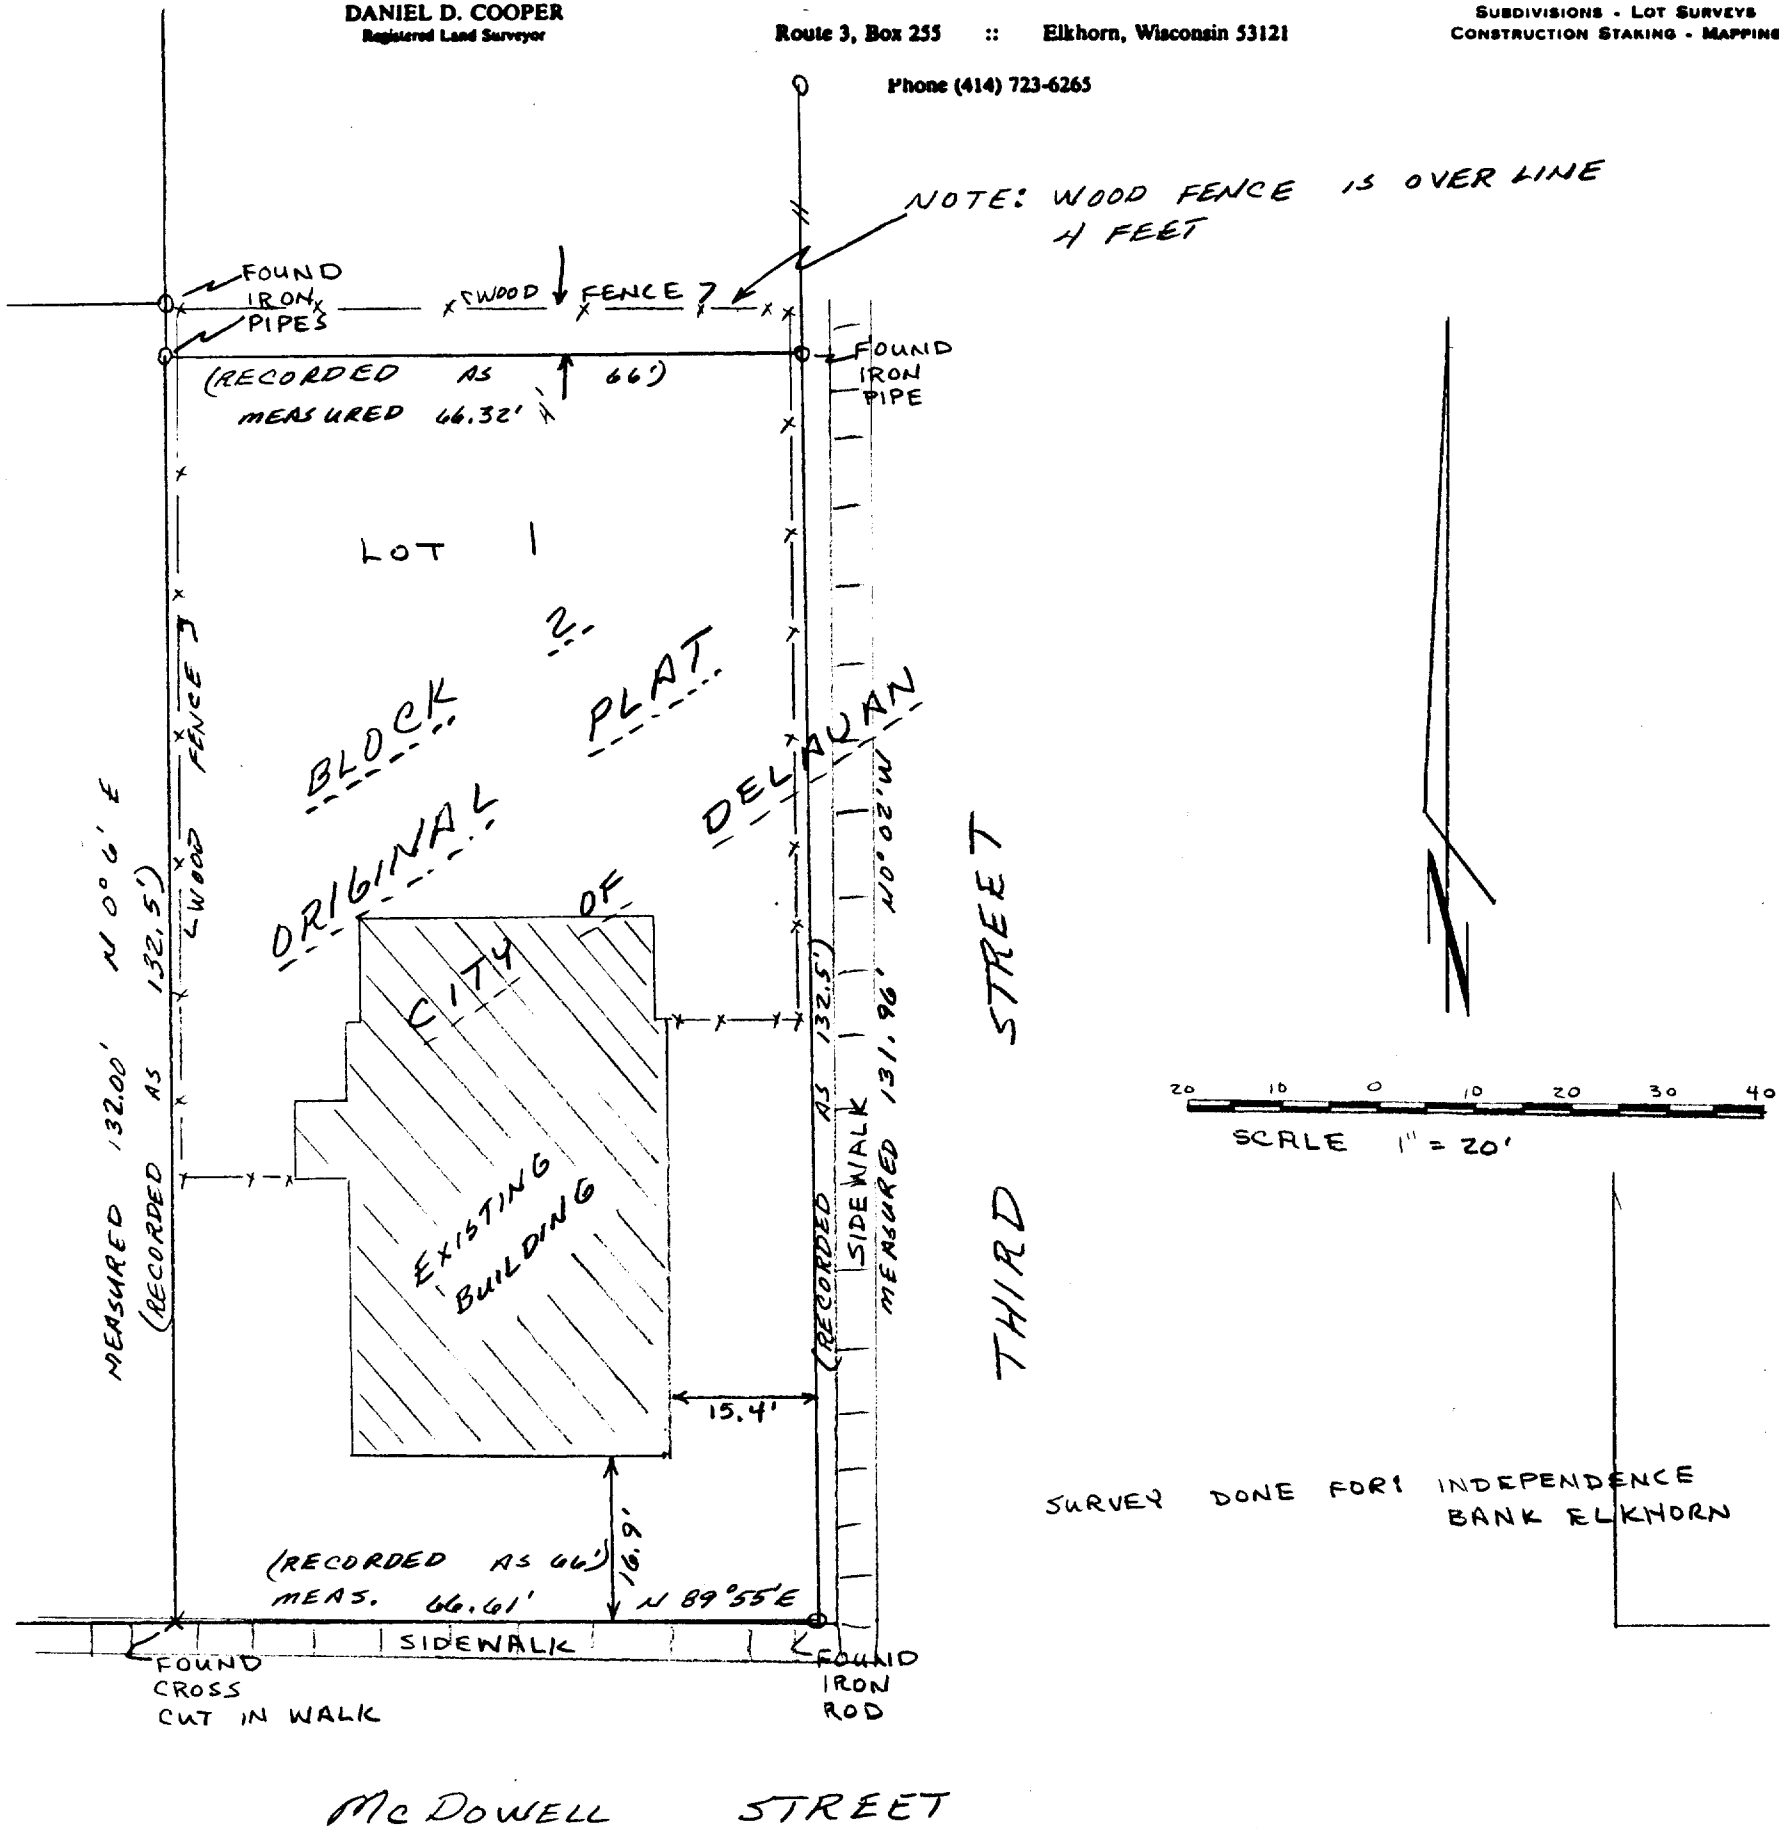

DESCRIPTION OF RECORD.

PLAT OF SURVEY OF THE SOUTHERLY
132.5 FEET OF LOT 1 OF BLOCK 2 OF
THE ORIGINAL PLAT OF THE CITY OF
DELAVAN, WALWORTH COUNTY, WISCONSIN

I, DANIEL D. COOPER, REGISTERED SURVEYOR, DO HEREBY CERTIFY THAT
I HAVE SURVEYED THE PROPERTY DESCRIBED HEREON AND THAT THE MAP
SHOWN HEREON IS A TRUE AND ACCURATE REPRESENTATION THEREOF TO THE
BEST OF MY PROFESSIONAL KNOWLEDGE AND BELIEF.

DATED THIS 7 DAY OF May, 1984

Daniel D. Cooper
DANIEL D. COOPER, RLS NO. S-1464



XOP-2

2-680-C
DRAWING NO. 1916