


DUNHAM SURVEYING, S.C.
SURVEYING & SUBDIVIDING
DELAVER, WISCONSIN 53115

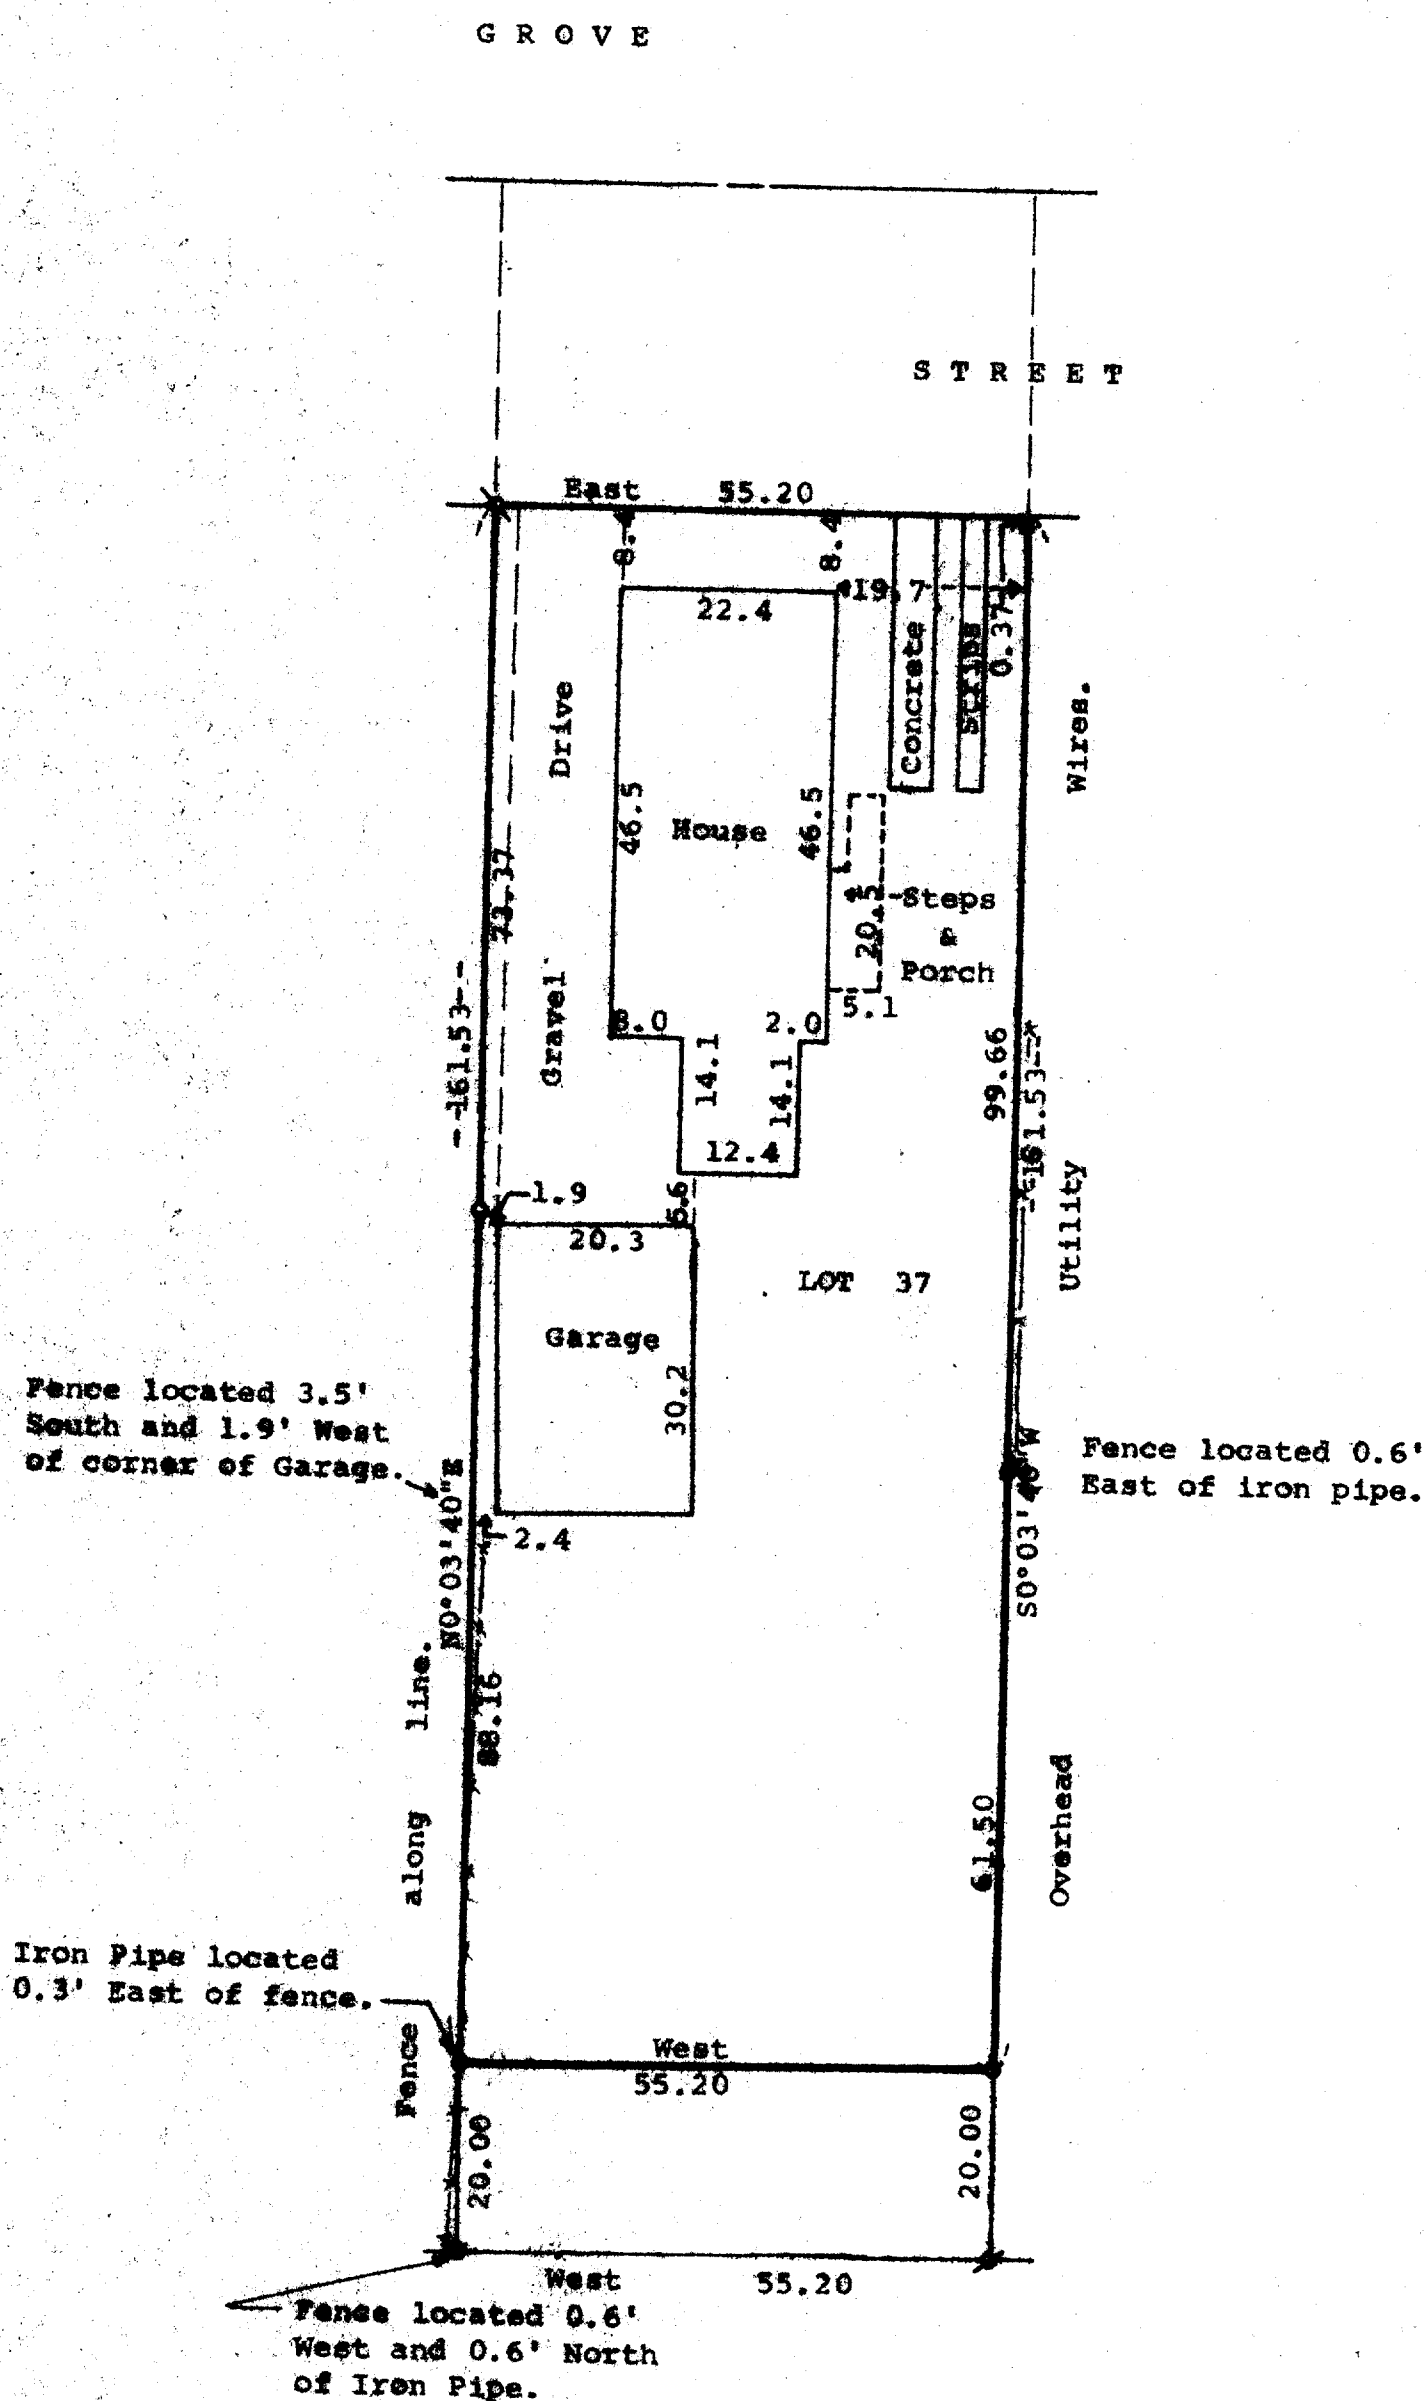

STATE OF WISCONSIN) SS
COUNTY OF WALWORTH)

I, George T. Dunham, Surveyor, certify that I have surveyed the property described as follows,

Lot 37 of J. W. Barlow's Subdivision of Block 16 of Passage, Aram, and Downie Addition to the Village, (now City) of Delavan, Walworth County, Wisconsin, according to the recorded plat in Volume 3 of Plats, Page 69, EXCEPTING land reserving the South 20.00 feet thereof and subject to the use by the public as a public street that portion now occupied as such,

and that the above map is a true representation thereof and shows the size and location of the property, its exterior boundaries, the location of all visible structures and dimensions of all principal buildings thereon, boundary fences, apparent easements, roadways and visible encroachments, if any, and that I have surveyed the property hereon described according to the official records, to the best of my knowledge and belief.

July 19, 1983.

George T. Dunham
George T. Dunham, Surveyor

