

PLAT OF SURVEY


OF LOT 2, BLOCK 25, ORIGINAL PLAT OF THE CITY OF DELAVAN
WALWORTH COUNTY, WISCONSIN.

JENSEN SURVEYING & MAPPING S.C.

P.O. Box 322

ELKHORN, WIS. 53121

MATTHEW ST
(82.5' WIDE)

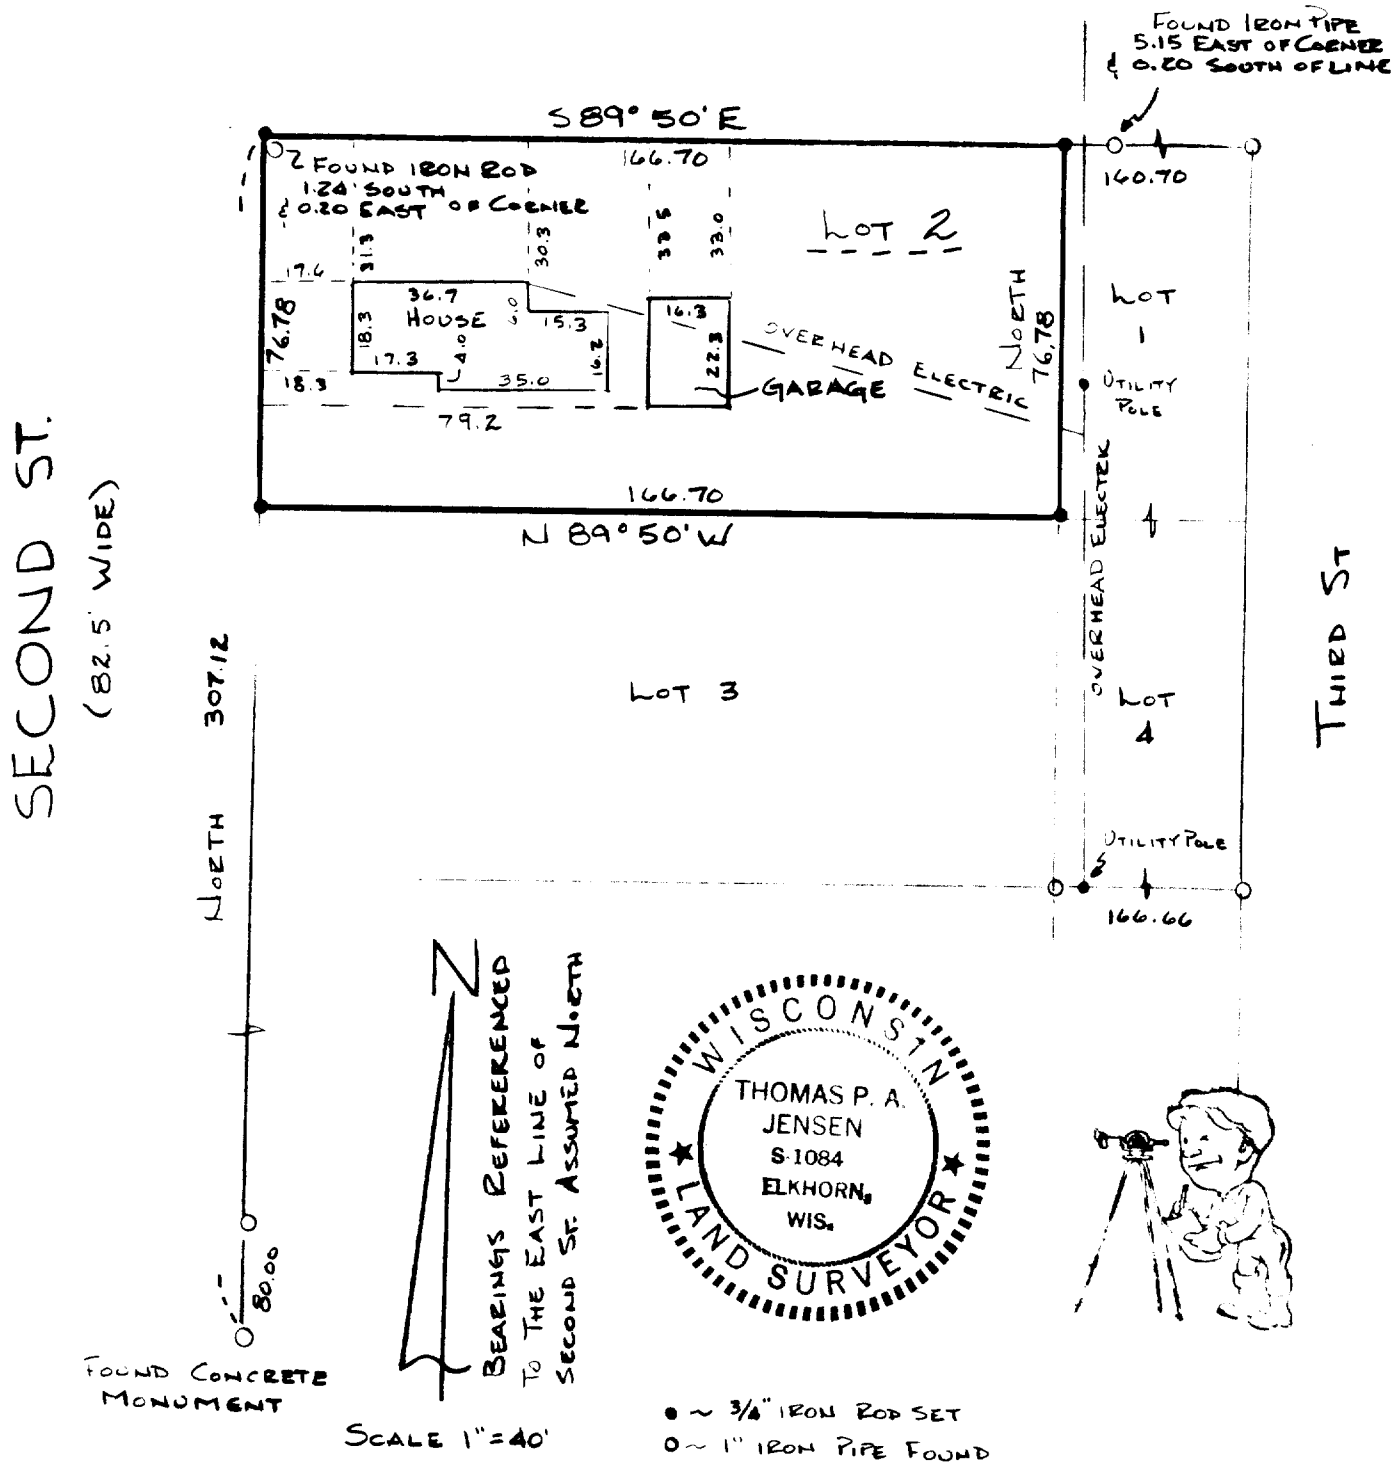

I HEREBY CERTIFY THAT THE ABOVE DESCRIBED PROPERTY HAS BEEN SURVEYED UNDER MY DIRECTION, THAT THE PLAT SHOWN HEREON IS AN ACCURATE SURVEY, A TRUE REPRESENTATION THEREOF, CORRECTLY SHOWS THE EXTERIOR BOUNDARY LINES ON SAID PROPERTY AND THE CORRECT MEASUREMENTS THEREOF AND THE BUILDINGS THEREON

Thomas P. Jensen

THOMAS P.A. JENSEN R.L.S # 1084

SURVEYED FOR: RUTH VINES
403 S SECOND ST
DELAWARE, WI 53115

MAPPING DATE: JULY 6, 1988

2-686-J[✓]
1984.041

XOP. 00254