




SOUTH VINE

STREET

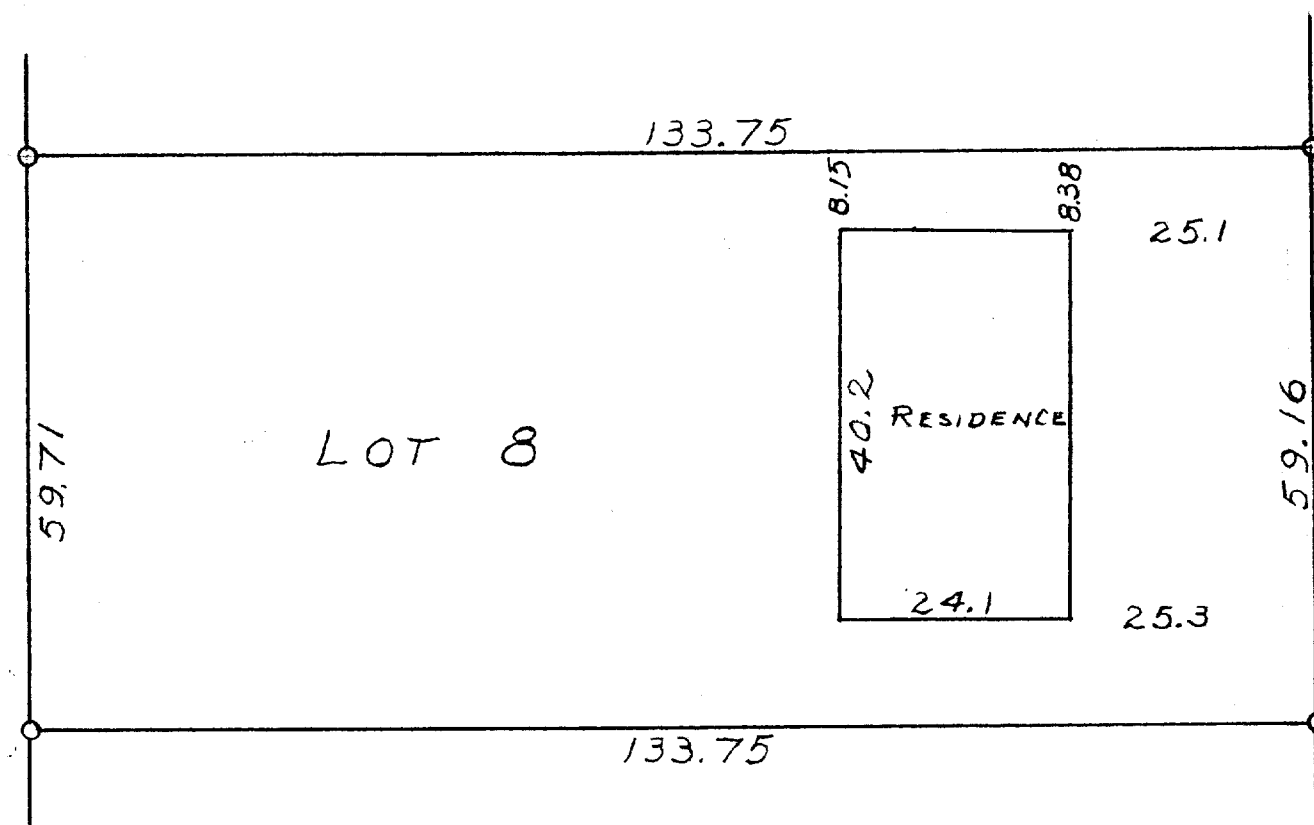

SCALE ~ 1" = 20'  
O ~ IRON PIPE

STATE OF WISCONSIN } S.S.  
COUNTY OF WALWORTH }

I, GEORGE T. DUNHAM, DO HEREBY CERTIFY THAT I HAVE SURVEYED THE  
PROPERTY DESCRIBED AS FOLLOWS:

LOT 8, BLOCK 2 OF SUNSET VIEW SUBDIVISION LOCATED IN THE  
SOUTHWEST 1/4 OF SECTION 18, T2NR16E, CITY OF DELAVAN,  
WALWORTH COUNTY, WISCONSIN

AND THAT THE PLAT SHOWN ABOVE IS A CORRECT REPRESENTATION  
OF THE PROPERTY LINES AND OF THE BUILDINGS LOCATED THEREON.  
JULY 18, 1957

George T. Dunham  
GEORGE T. DUNHAM, SURVEYOR  
DELAVAN, WISCONSIN

2-69