


N

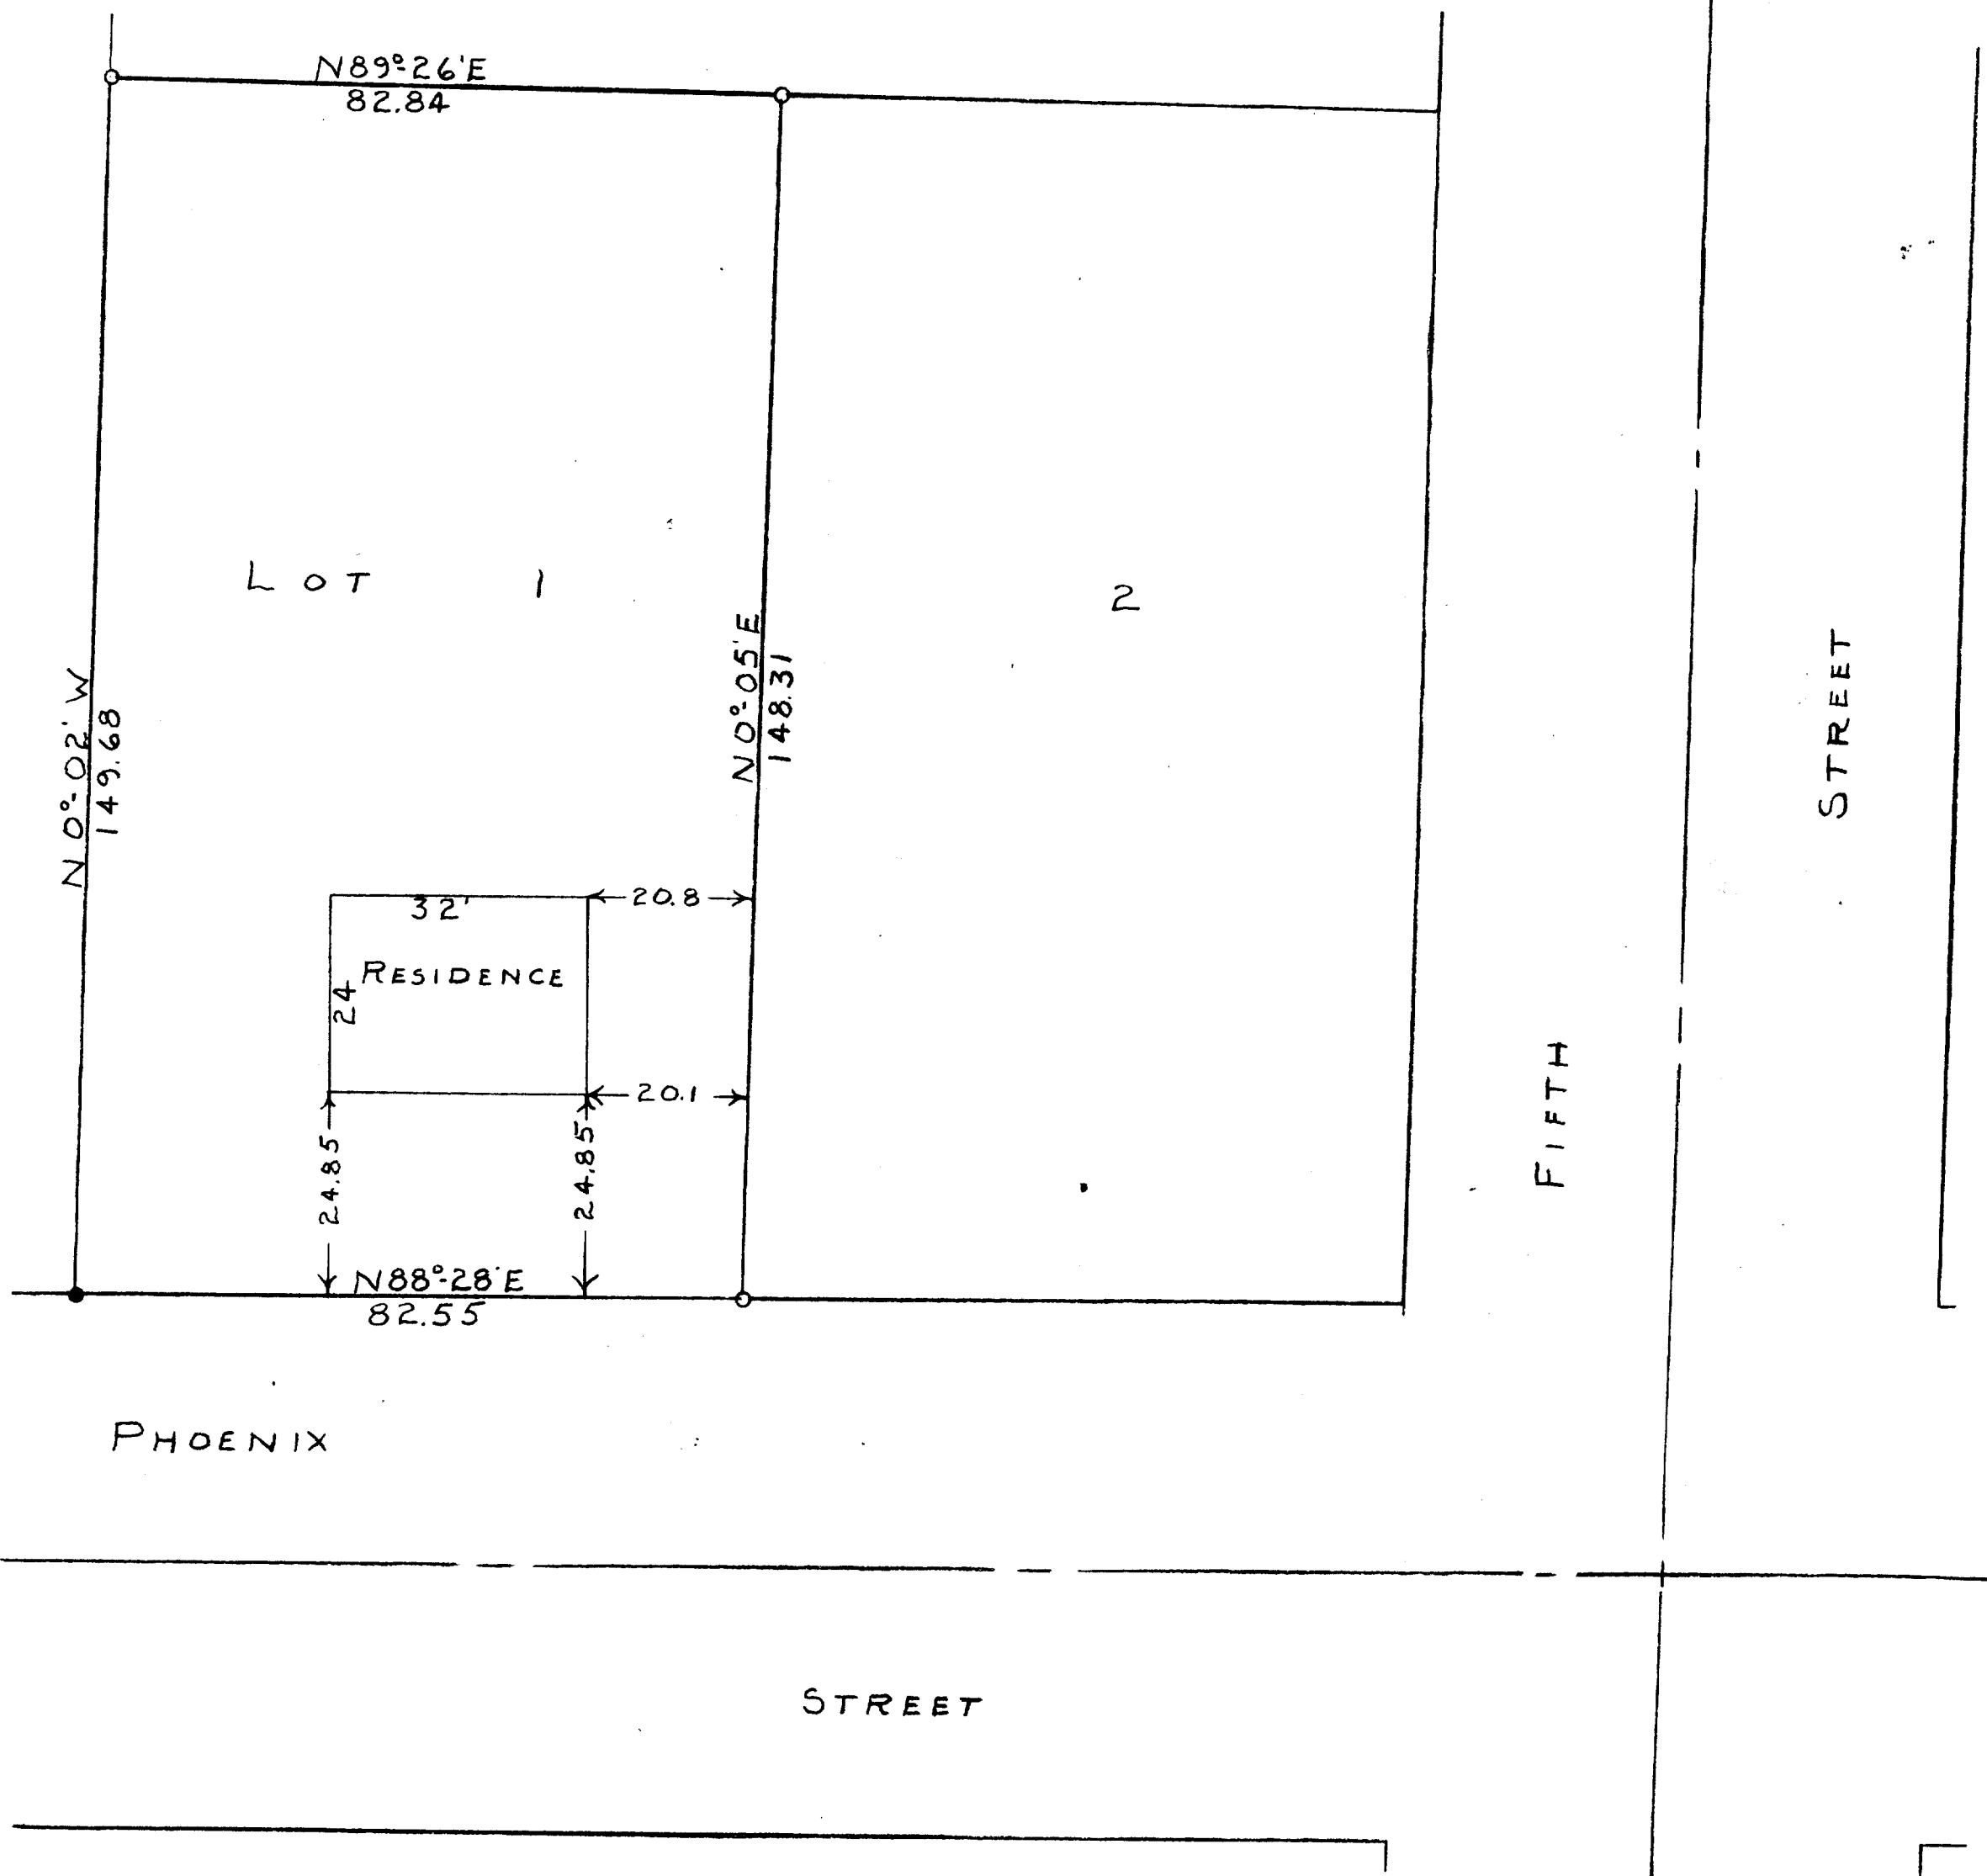

SCALE-1"=20'
 O=IRON PIPE
 ●=CONC. MONU.

PHOENIX

STREET

STATE OF WISCONSIN)
 COUNTY OF WALWORTH)

I, GEORGE T. DUNHAM, DO HEREBY CERTIFY THAT I HAVE SURVEYED
 THE PROPERTY DESCRIBED AS FOLLOWS:

LOT 1 OF KNAPP'S SUBDIVISION LOCATED IN THE CITY OF
 DELAVAN, WALWORTH COUNTY, WISCONSIN
 AND THAT THE PLAT SHOWN ABOVE IS A CORRECT REPRESENTATION OF THE
 PROPERTY LINES.
 JAN. 3, 1956

George T. Dunham
 GEORGE T. DUNHAM, SURVEYOR
 DELAVAN, WISCONSIN

XK-1

2-7✓