
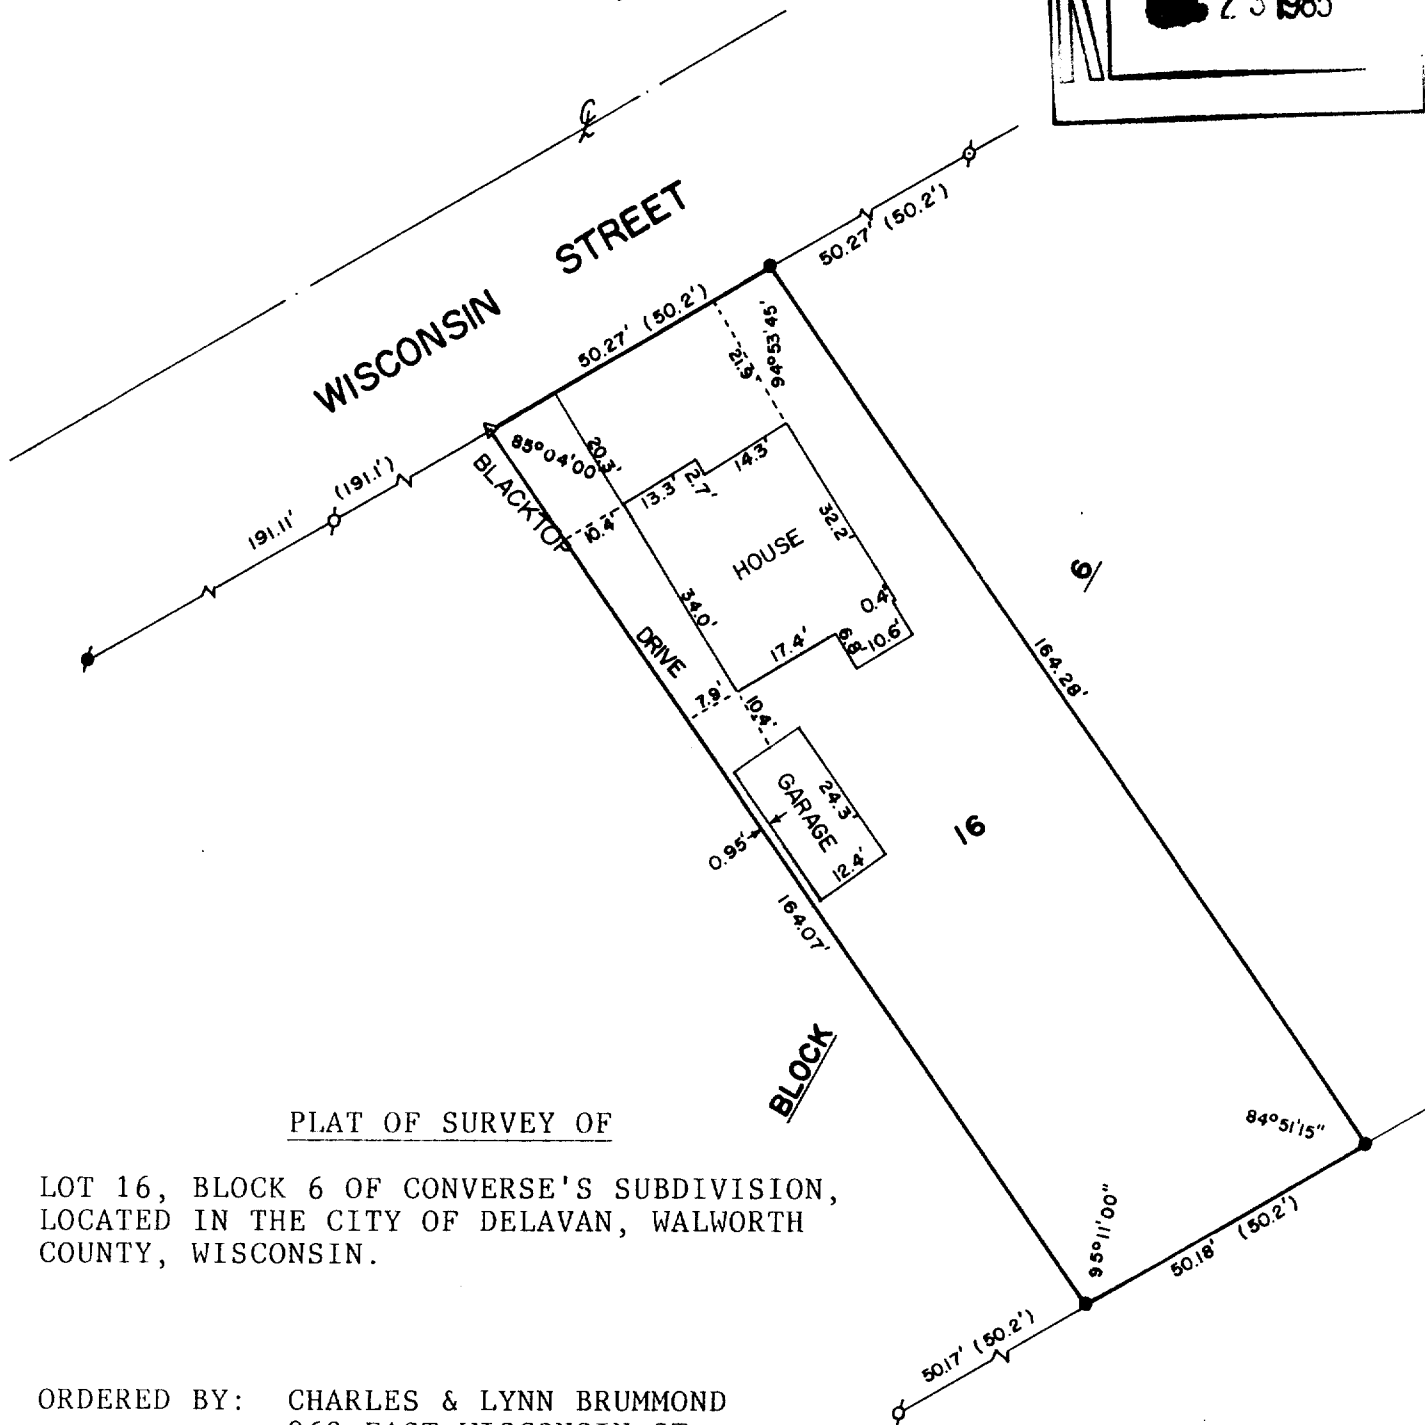



ABELL
SURVEYING & MAPPING
DELAVAN, WISCONSIN 53115

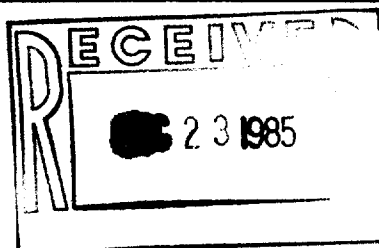

PLAT OF SURVEY OF

LOT 16, BLOCK 6 OF CONVERSE'S SUBDIVISION,
LOCATED IN THE CITY OF DELAVAN, WALWORTH
COUNTY, WISCONSIN.

ORDERED BY: CHARLES & LYNN BRUMMOND
962 EAST WISCONSIN ST.
DELAVAN, WI 53115

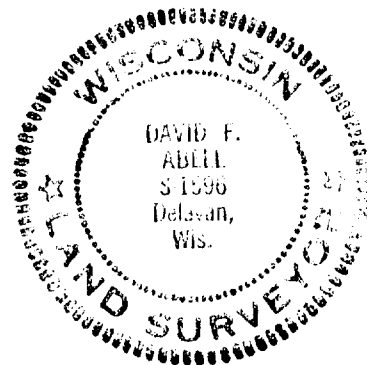

SCALE - 1"=30'

LEGEND

- ♂ - IRON PIPE FOUND
- ♂ - IRON ROD FOUND
- Δ - RAILROAD SPIKE FOUND
- - IRON ROD SET
- () - RECORDED AS

I, DAVID F. ABELL, DO HEREBY CERTIFY
THAT I HAVE SURVEYED THE PROPERTY
HEREON DESCRIBED ACCORDING TO THE
OFFICIAL RECORDS, AND THAT THE PLAT
HEREON IS A CORRECT REPRESENTATION
OF THE PROPERTY LINES TO THE BEST
OF MY KNOWLEDGE AND BELIEF.

David F. Abell

DAVID F. ABELL
WISCONSIN REGISTERED LAND SURVEYOR, S-1596

November 14, 1985
DATE

JOB NUMBER - 1185003

2-703-A