



ABELL
SURVEYING & MAPPING
DELAVER, WISCONSIN 53115
414-728-6737

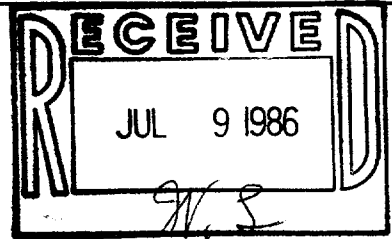

WALWORTH AVENUE

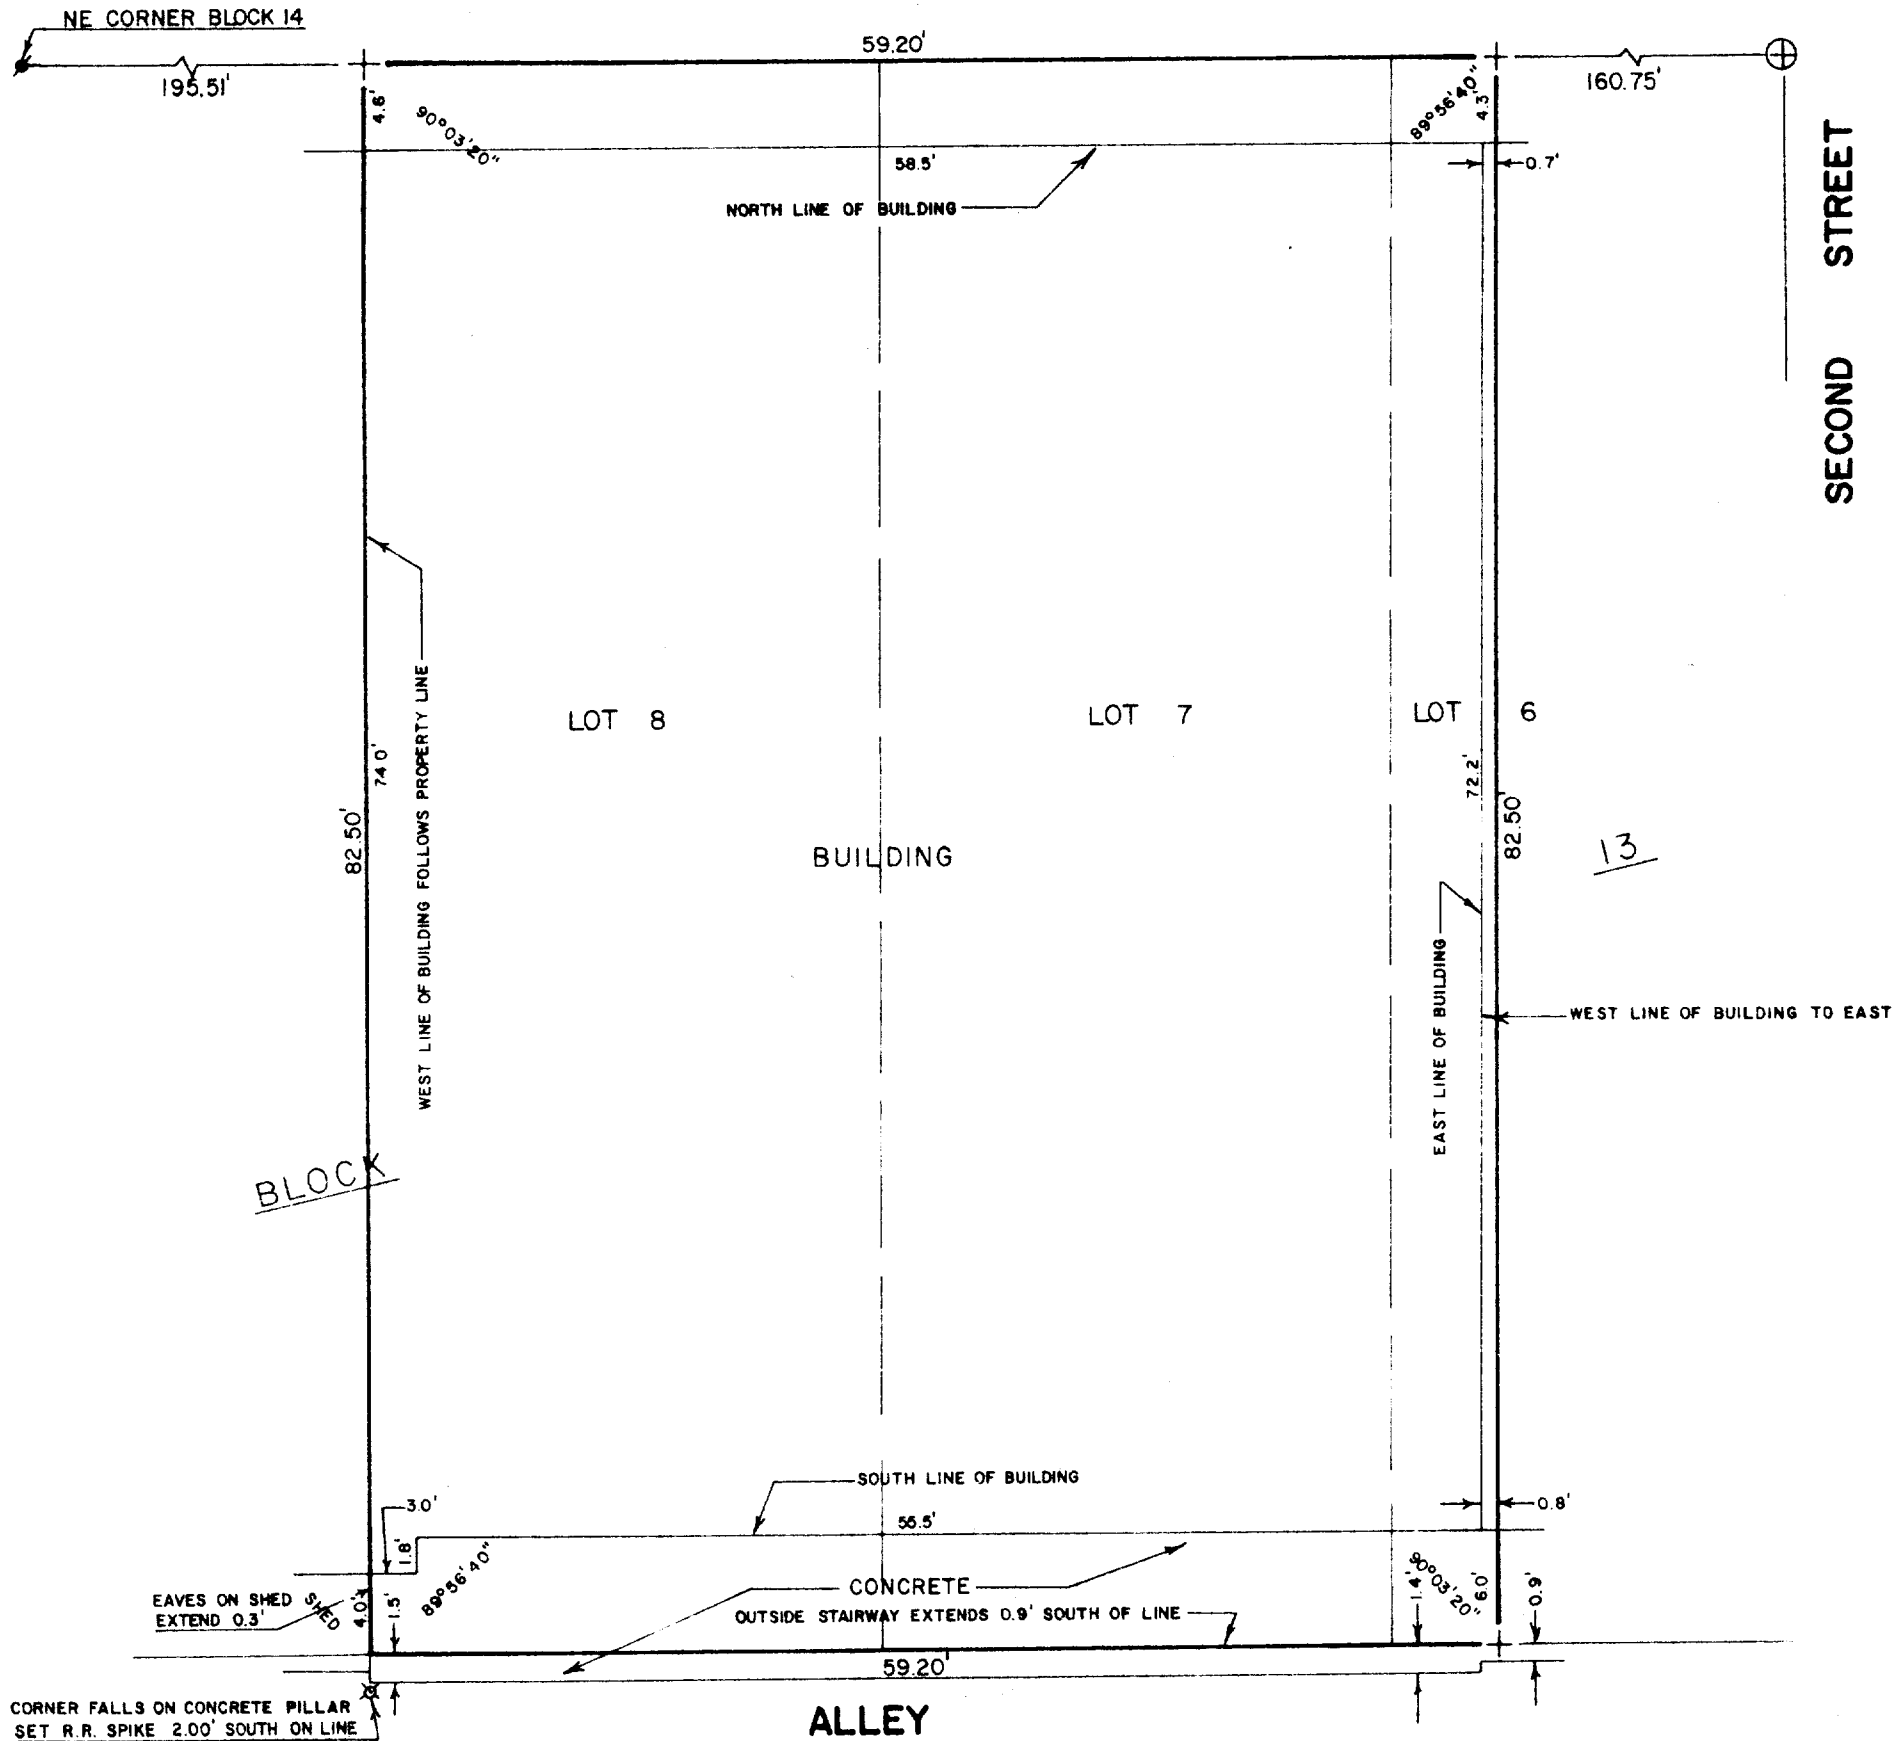

PLAT OF SURVEY OF

LOTS 6, 7 AND 8, EXCEPT THE EAST 21 FEET OF LOT 6,
BLOCK 13 OF THE ORIGINAL PLAT, CITY OF DELAVER,
WALWORTH COUNTY, WISCONSIN.

ORDERED BY: DR. DOUGLAS WILD
415 BROAD STREET
LAKE GENEVA, WI 53147



SCALE - 1"=10'

LEGEND

- - CONCRETE MONUMENT FOUND
- ⊕ - CUT CROSS IN CONCRETE FOUND
- ⊕ - CUT CROSS IN CONCRETE SET
- ⌵ - RAILROAD SPIKE SET



I, DAVID F. ABELL, DO HEREBY CERTIFY
THAT I HAVE SURVEYED THE PROPERTY
HEREON DESCRIBED ACCORDING TO THE
OFFICIAL RECORDS, AND THAT THE PLAT
HEREON IS A CORRECT REPRESENTATION
OF THE PROPERTY LINES TO THE BEST OF
MY KNOWLEDGE AND BELIEF.

David F. Abell

DAVID F. ABELL
WISCONSIN REGISTERED LAND SURVEYOR, S-1596

DATE June 19, 1986 JOB NUMBER - 86015

XOP-00127

2-705-A