
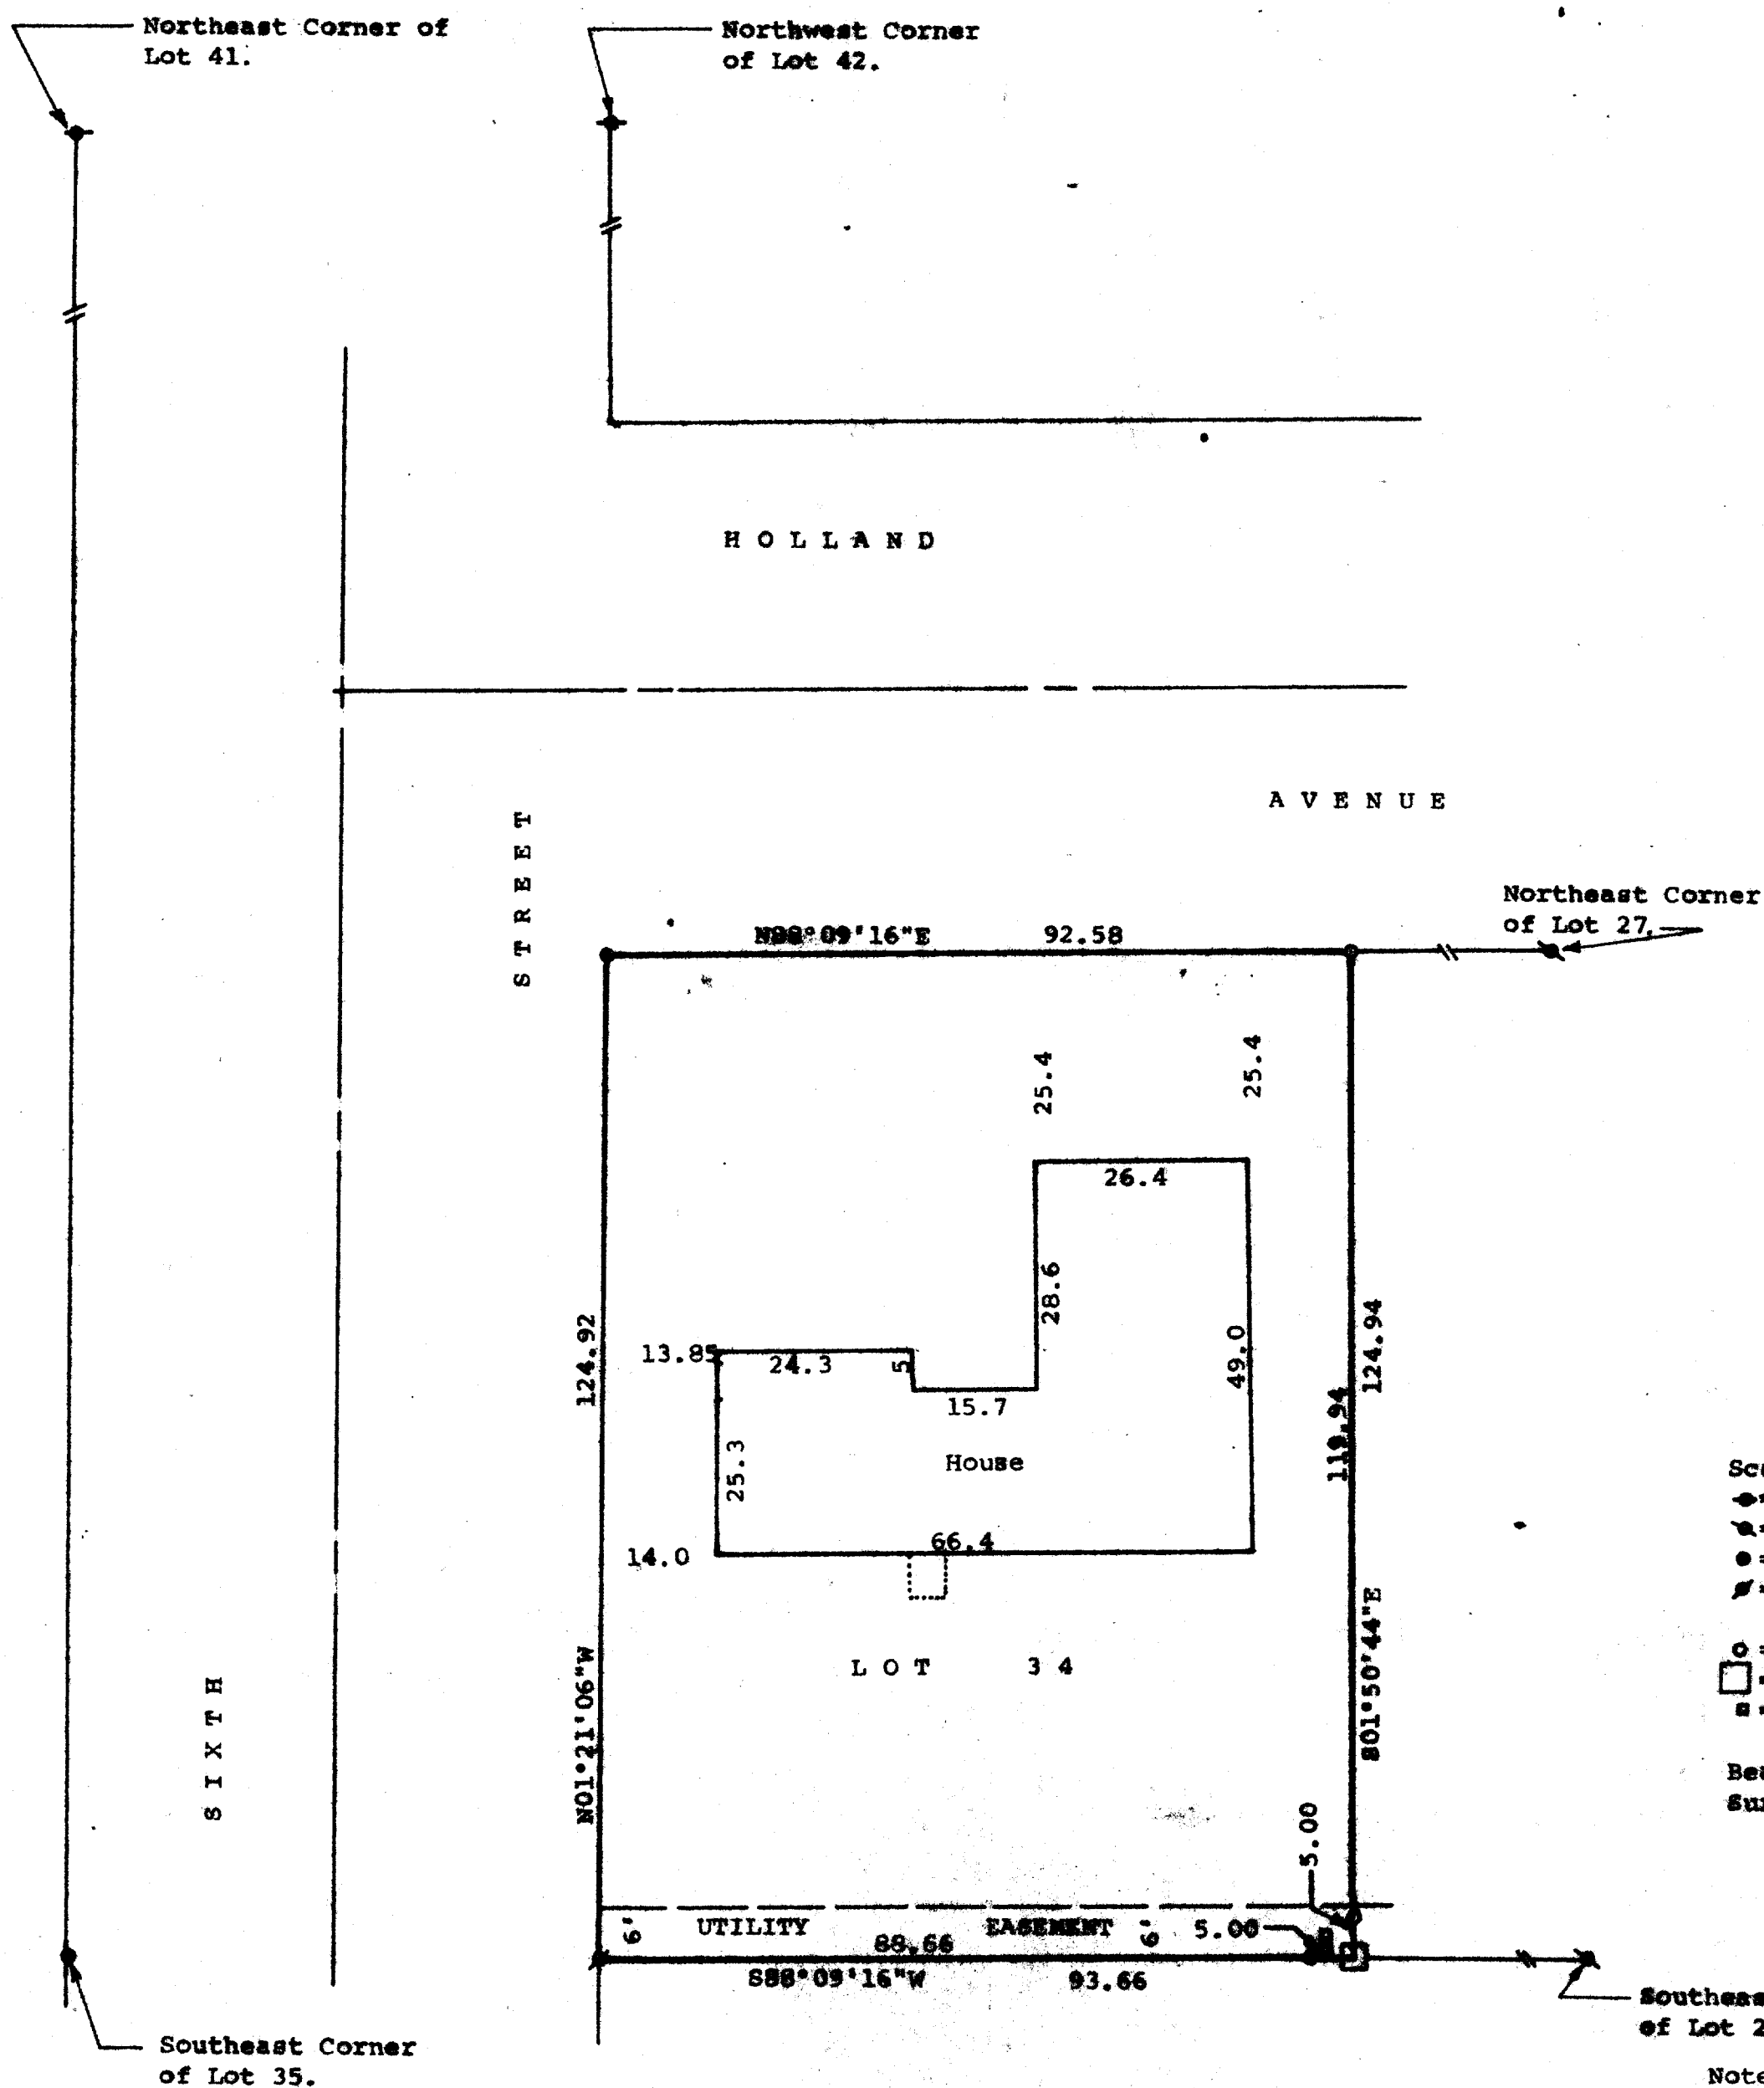


DUNHAM SURVEYING, S.C.
SURVEYING & SUBDIVIDING
DELAVER, WISCONSIN 53115

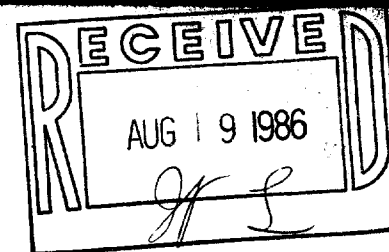

Scale - 1" = 20'

1 1/4" Dia. Iron Pipe Found

2" Dia. Iron Pipe Found

3/4" Dia. Iron Rod Found

3/4" Dia. Iron Rod Found Bent and reset

3/4"x24" Iron Pipe Set

Electric Transformer

Telephone Pedestal

Bearings are those of record.

Survey Ordered By:

Century 21

Skandia Realty

312 South 7th Street

Delaver, Wisconsin 53115

Note: Iron Pipes at the NE and NW corners of the lot were reset Sept. 5, 1985.

New House was located on lot

STATE OF WISCONSIN) ss
COUNTY OF WALWORTH)

I, George T. Dunham, Surveyor, certify that I have surveyed the property described as follows,

Lot 34 of the First Addition to Tod Miller Subdivision, located in the City of Delaver, Walworth County, Wisconsin, and that the map shown hereon is a correct representation thereof and shows the size and location of the property, its exterior boundaries, the location of all visible structures and dimensions of all principal buildings thereon, boundary fences, apparent easements, roadways and visible encroachments, if any, and that I have surveyed the property hereon described according to the official records to the best of my knowledge and belief.

June 17, 1985.
Revised September 5, 1985

George T. Dunham
George T. Dunham, Surveyor

