


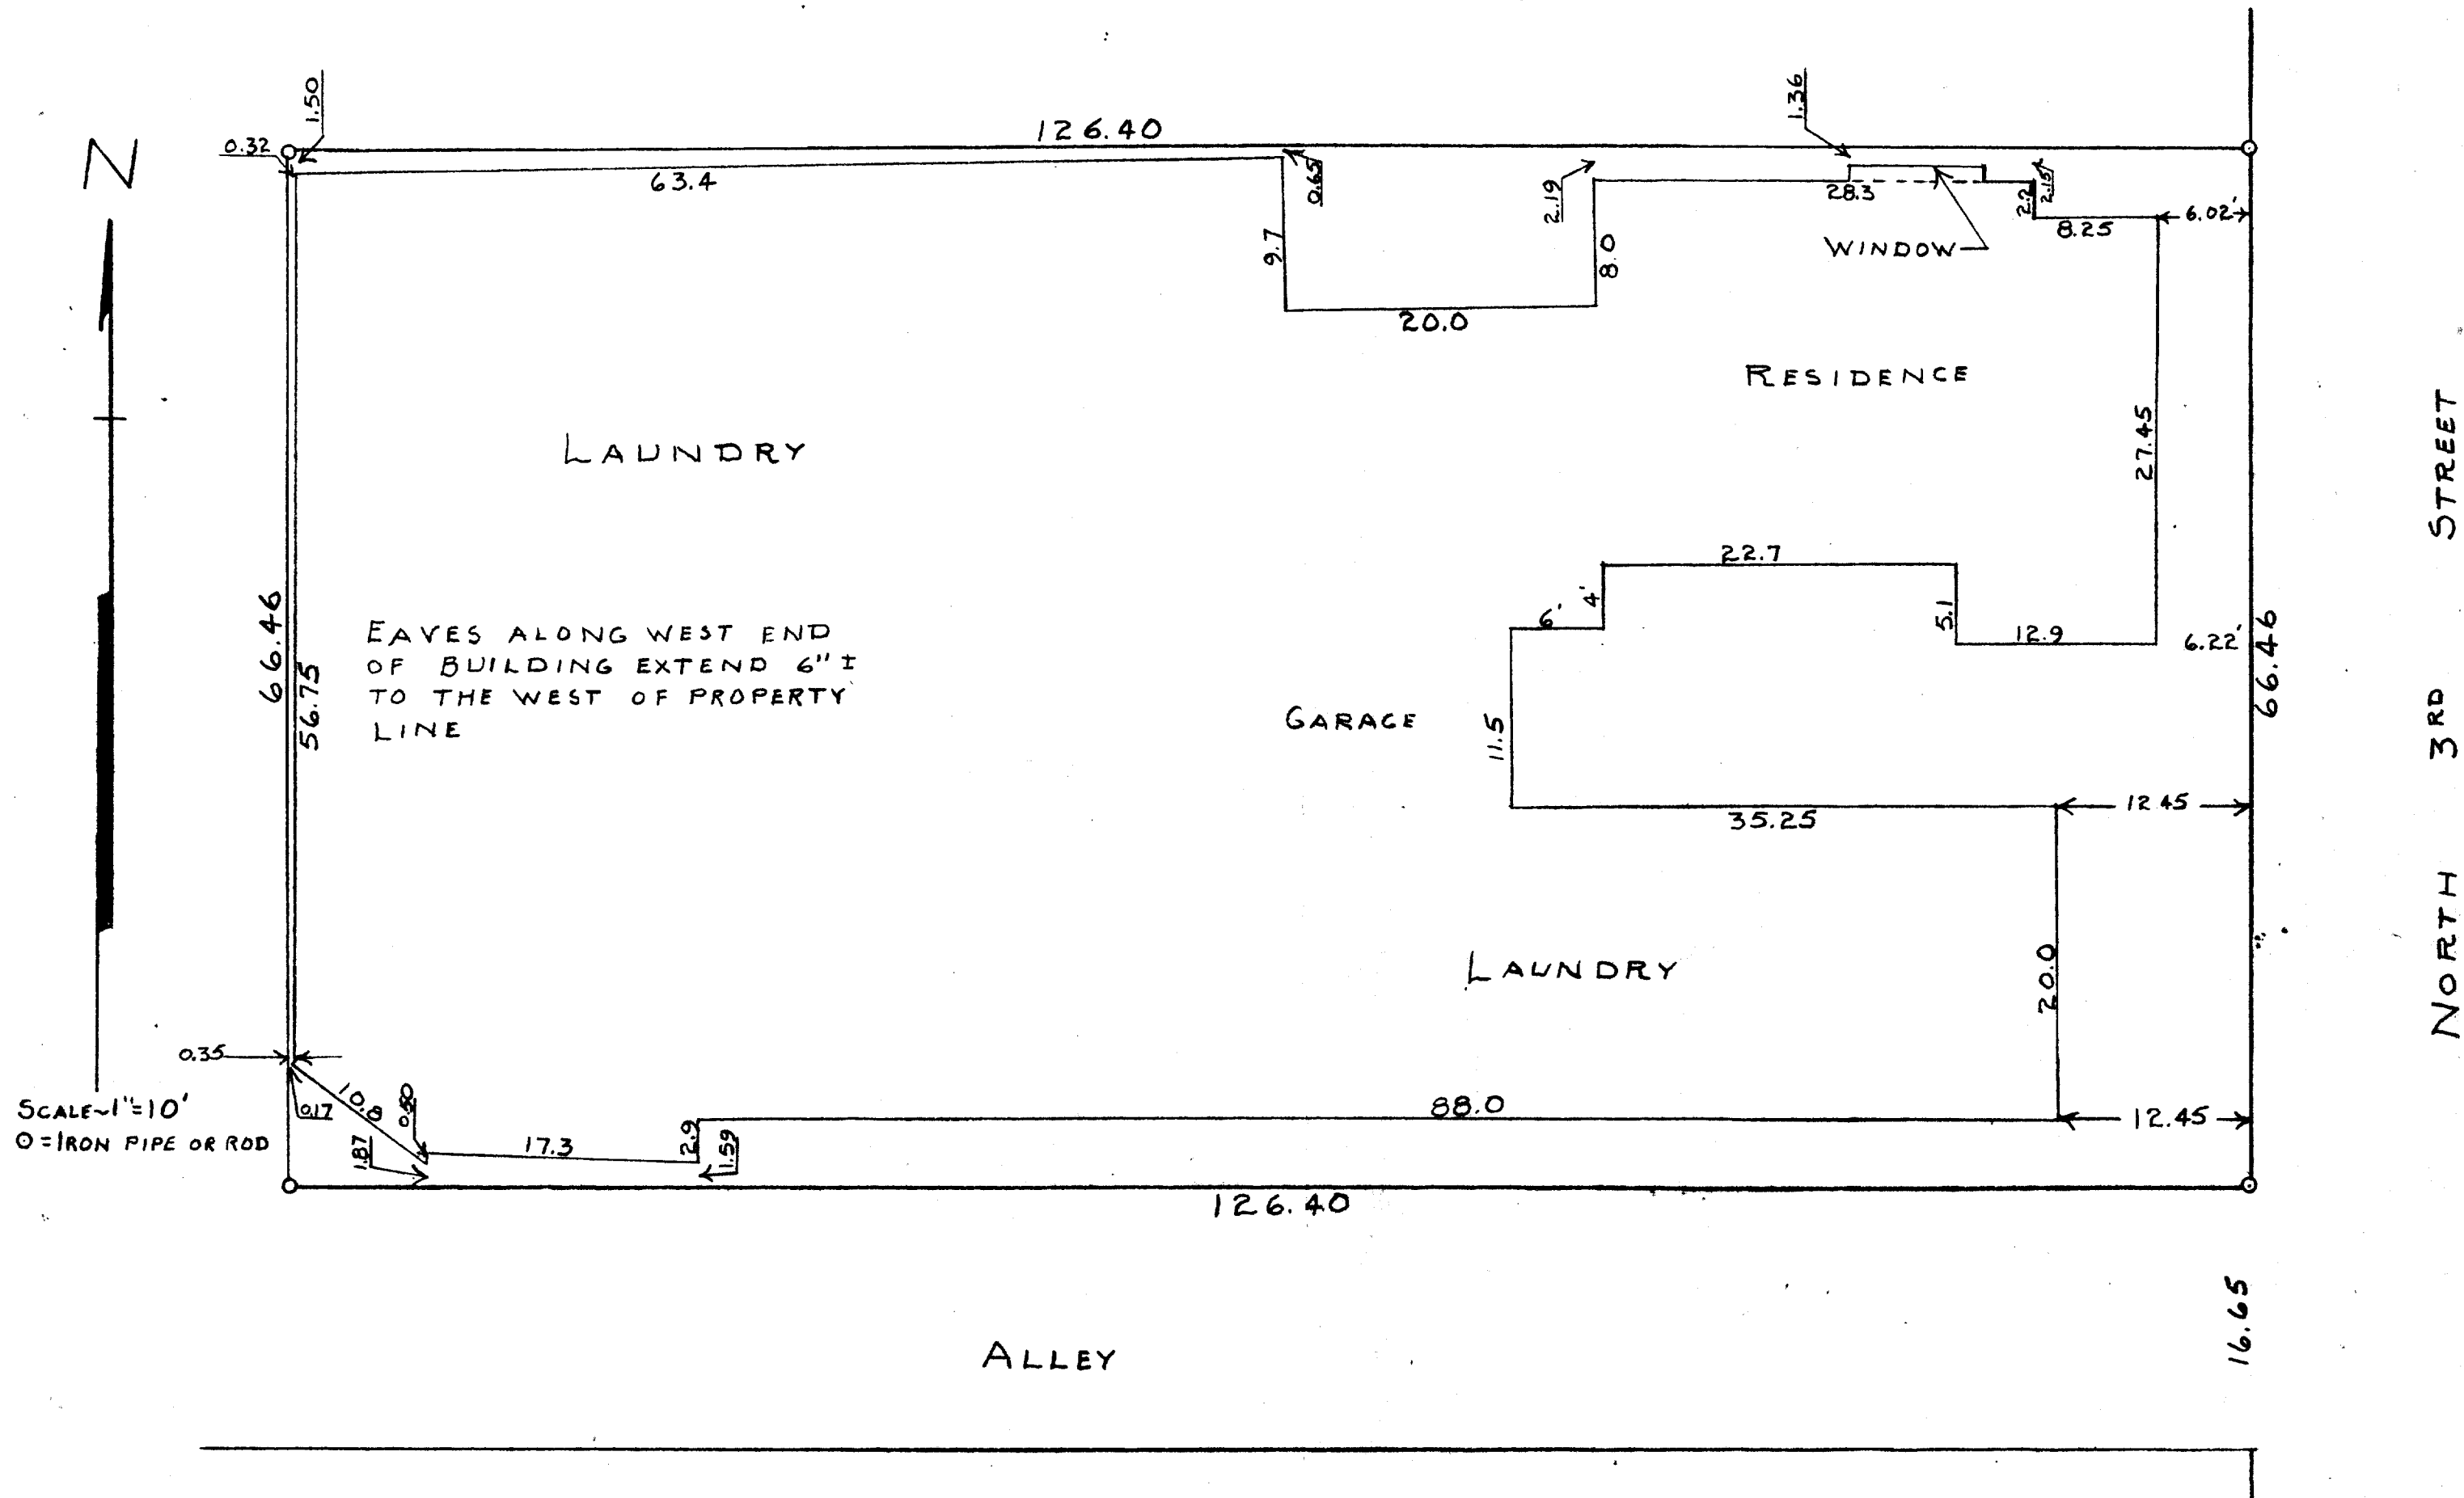

STATE OF WISCONSIN)
 WALWORTH COUNTY)

I, GEORGE T. DUNHAM, DO HEREBY CERTIFY THAT I HAVE SURVEYED
 THE PROPERTY DESCRIBED AS FOLLOWS:

LOT 8, BLOCK 9 OF THE ORIGINAL PLAT OF THE CITY OF
 DELAYAN, WALWORTH COUNTY, WISCONSIN, EXCEPT THE WEST
 40.00 FEET THEREOF.

AND THAT THE PLAT SHOWN ABOVE IS A CORRECT REPRESENTATION OF THE
 PROPERTY LINES AND OF THE BUILDINGS LOCATED THEREON.
 JUNE 13, 1957

George T. Dunham
 GEORGE T. DUNHAM, SURVEYOR
 DELAYAN, WISCONSIN

2-72

XOP-63