

Date February 21, 1986



PLAT OF SURVEY

Job No. Z-378-33568

LOT 11 - BLOCK 7 - SPRINGS PARK SUBDIVISION ADDITION NO. 2,
located in the Southwest 1/4 of Section 18, Town 2 North, Range 16 East, City of Delavan, Walworth
County, Wisconsin.

Located at 316 Spring Drive

Owners: Richard E. and Suzanne M. Johnson

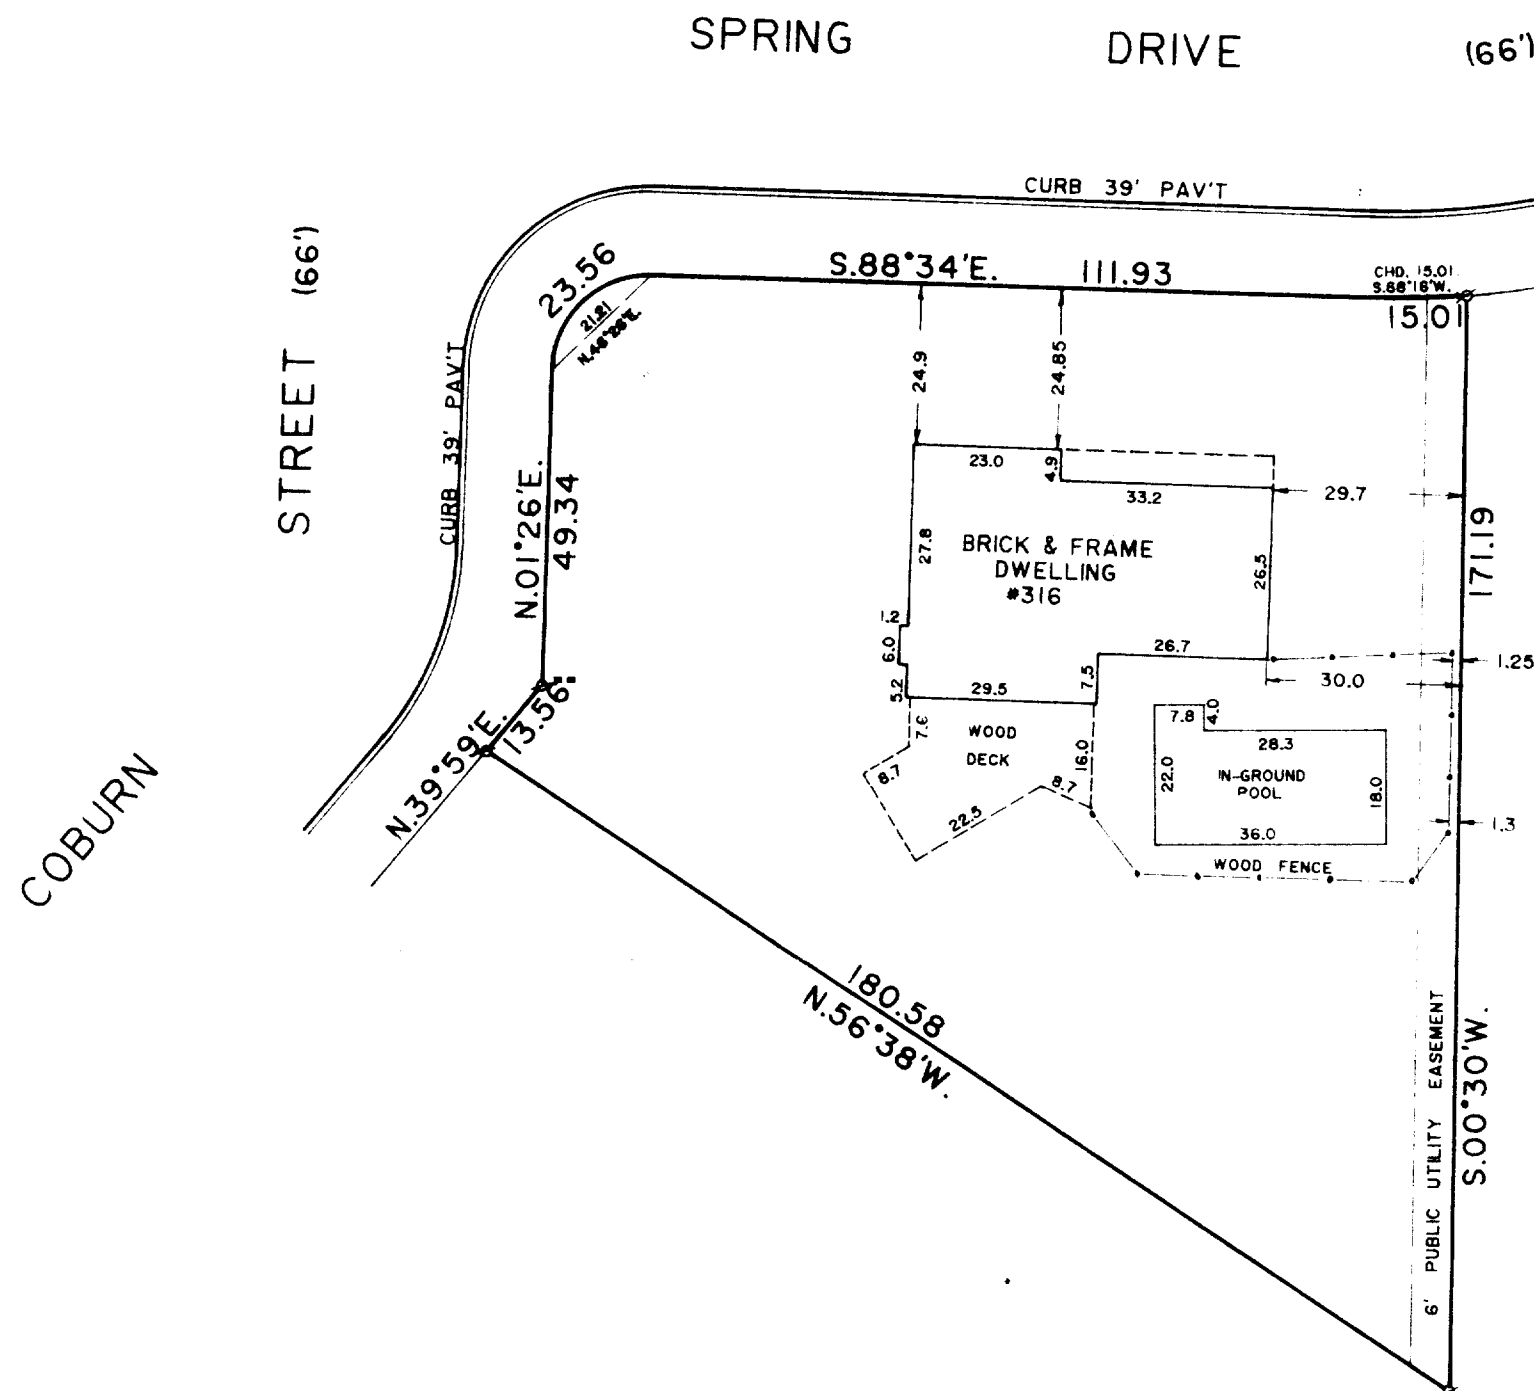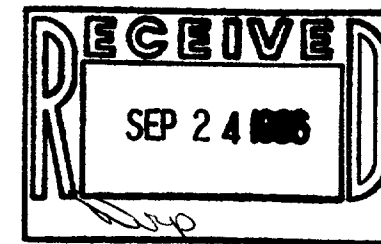

In accordance with Chapter A-E 5.01b
a signed agreement is on file waiving the
setting of monuments on the property.

Scale 1"=30'

FOUND IRON PIPE
SET IRON PIPE
8522 West Lisbon Avenue
Milwaukee, Wisconsin 53222

SURVEYED FOR
Security Savings and Loan Assn.
1055 N. Mayfair Rd.
Wauwatosa, Wisconsin 53226


LANDMARK SURVEYING CO.

I, Richard J. Lammi, surveyed the above described prop-
erty, and the above map is a true representation thereof
and shows the size and location of the property, its
exterior boundaries, the location and dimensions of
all visible structures thereon, fences, apparent ease-
ments, roadways and visible encroachments.

This survey is made for the exclusive use of the present
owners of the property; also those who purchase, mort-
gage or guarantee the title thereto, within one year
from date hereof.

Richard J. Lammi
REGISTERED LAND SURVEYOR NO. 5-777 - STATE OF WISCONSIN

PHONE
461-3730

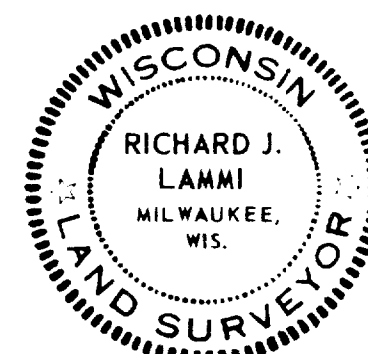

XSP52-18