

Farris, Hansen & Associates, Inc.




Engineers, Architects and Surveyors

P.O. BOX 187

7 RIDGEWAY COURT

ELKHORN, WISCONSIN 53121


PLAT OF SURVEY LOT 65 TURTLE CREEK
A SUBDIVISION IN SW 1/4 SE 1/4 SEC. 13, T. 2 N., R. 15 E
CITY OF DELAVAN, WALWORTH CO., WIS.

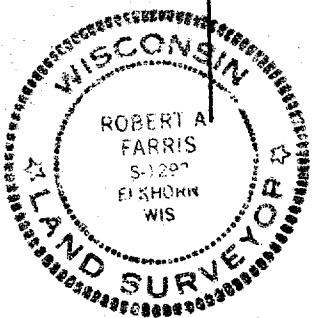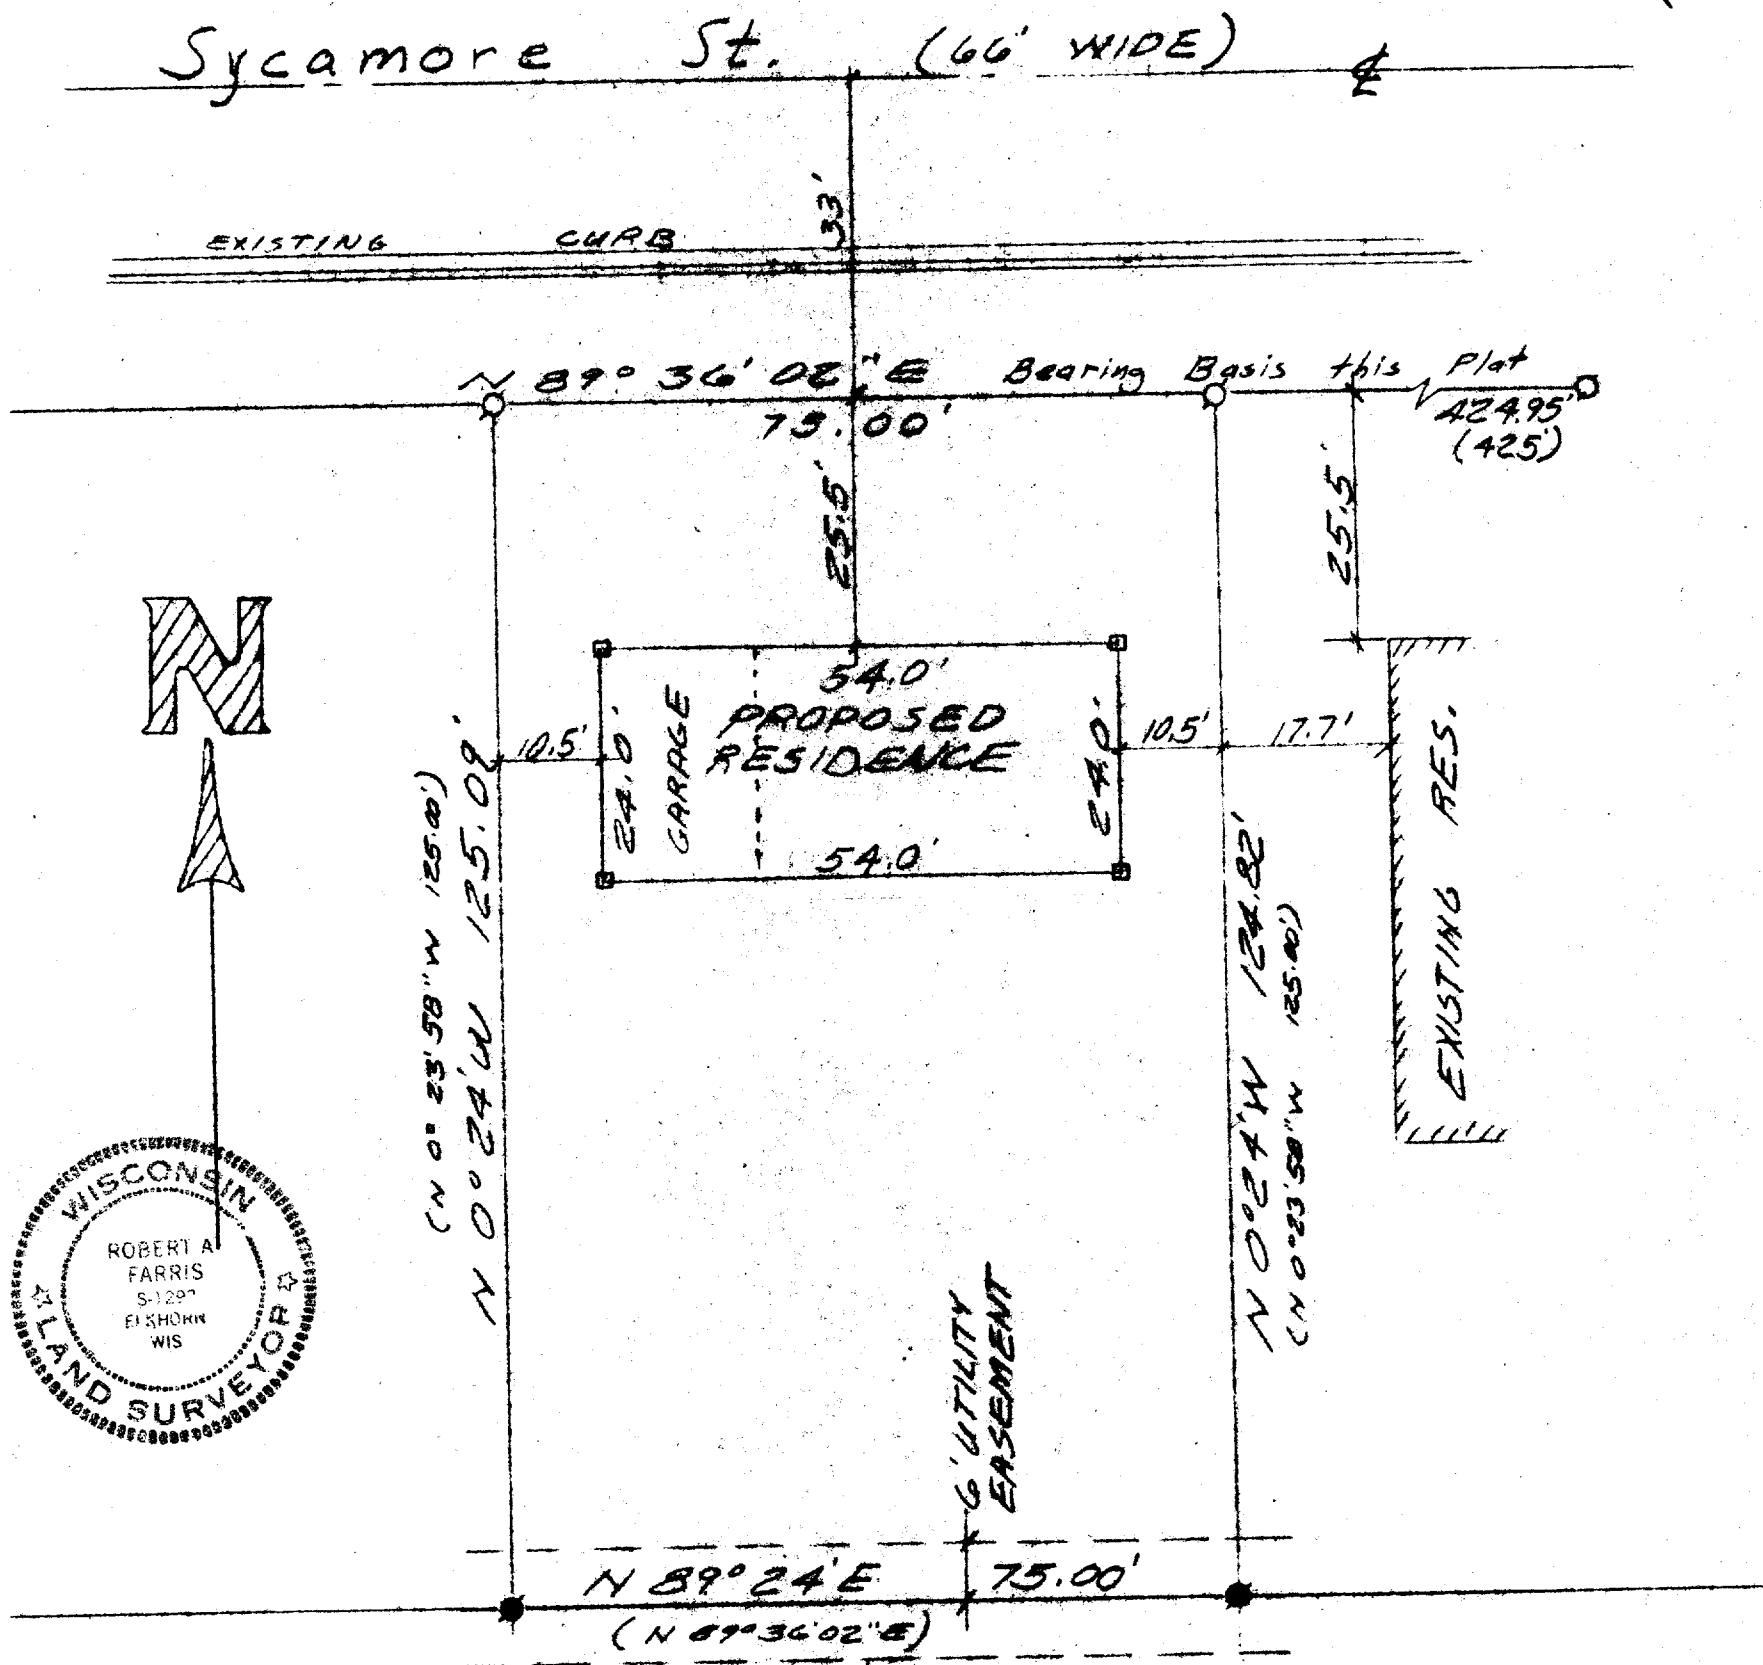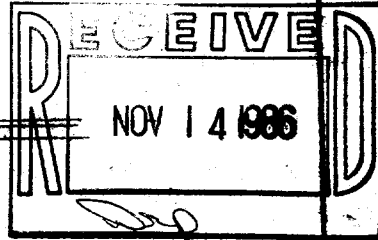

WORK ORDERED BY: SCHAUDER BUILDING & REALTY

LEGEND

- ⊙ = Iron Pipe Survey Stake Found
- = Iron Pipe Survey Stake Set
- (xxx) = Record Dimension
- = Iron Rod Stake Found
- = WOOD STAKE SET

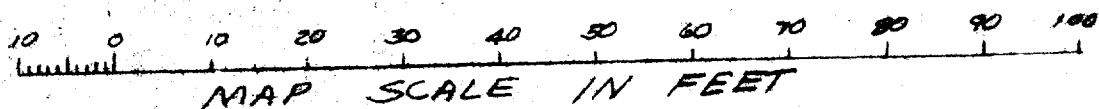

CERTIFICATE

I hereby certify that the above described property has been surveyed under my direction and that the above map is a true representation thereof and shows the size and location of the property, its exterior boundaries, the location of all visible structures and dimensions of all principal buildings thereon, boundary fences, apparent easements, roadways and visible encroachments, if any. This survey is made for the use of the present owners of the property, and also for those who purchase, mortgage, or guarantee the title thereto within one (1) year from the date hereof.

Robert A. Farris
Robert A. Farris, R.L.S.

Dated this 24 day of October, 1986

PROJECT NO. 2667