
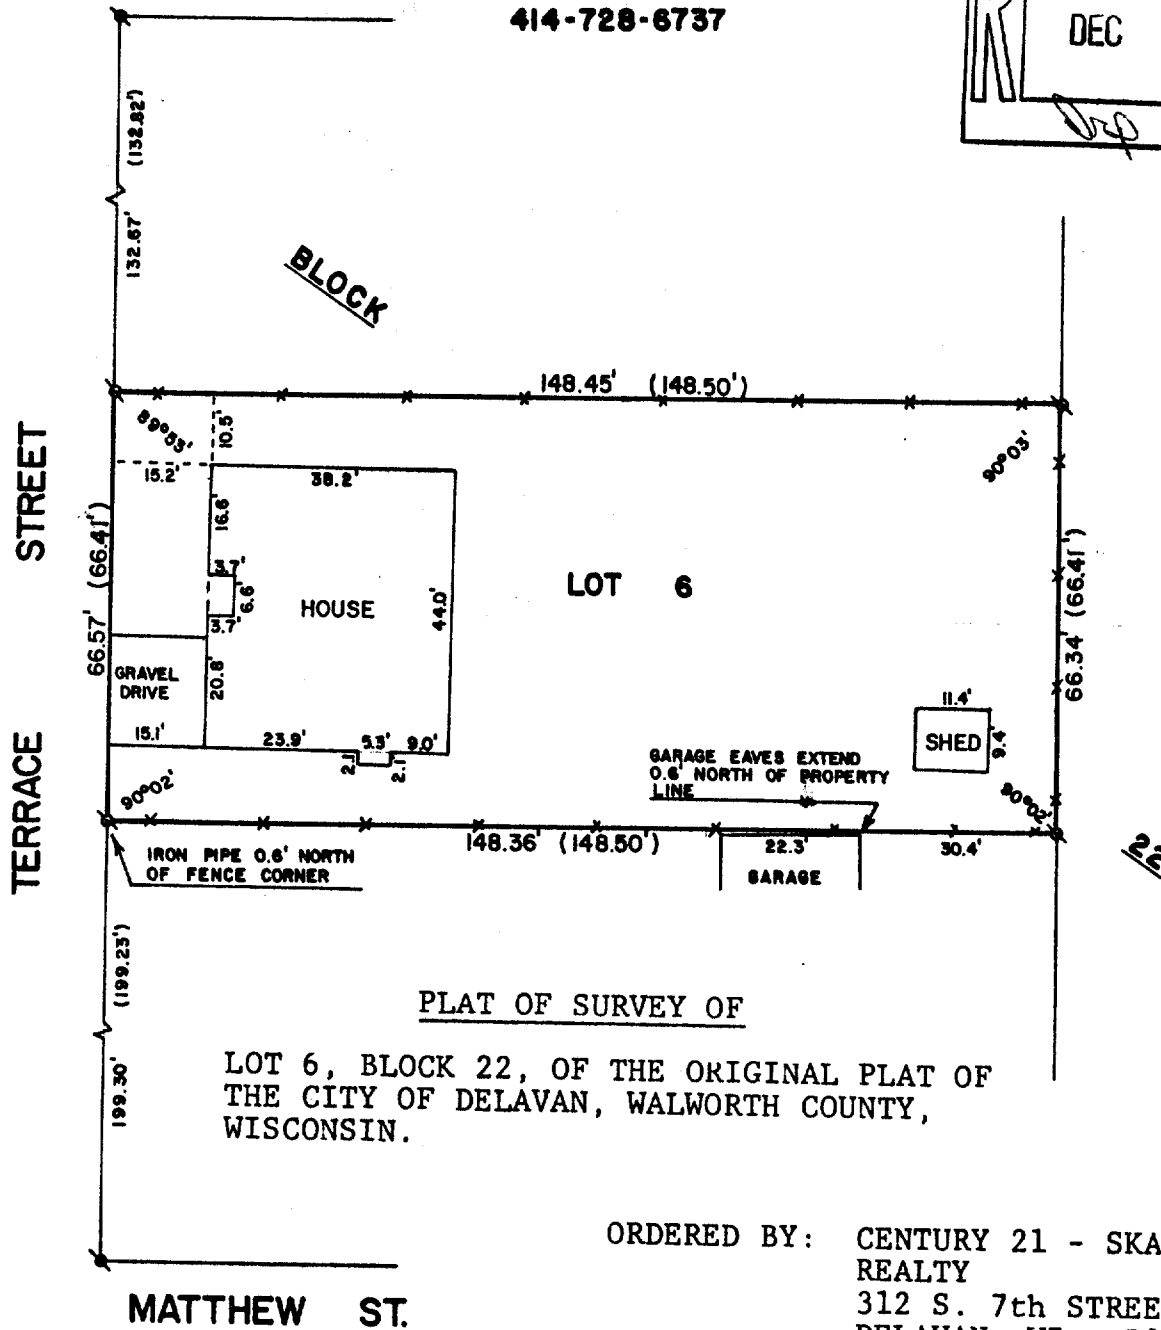


ABELL
WISCONSIN ST. SURVEYING & MAPPING
DELAVER, WISCONSIN 53115
414-728-6737

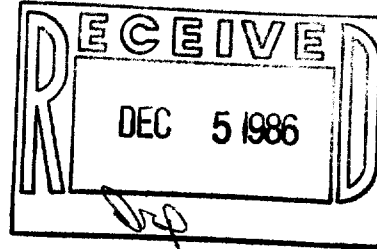

SCALE - 1"=30'

LEGEND

- ⊕ - IRON PIPE FOUND
- ⊕ - CONCRETE MONUMENT FOUND
- - - FENCE
- () - AS SHOWN ON CITY ENGINEERS RECORDS

I, DAVID F. ABELL, DO HEREBY CERTIFY
THAT I HAVE SURVEYED THE PROPERTY
HEREON DESCRIBED ACCORDING TO THE
OFFICIAL RECORDS AND THAT THE PLAT
HEREON IS A CORRECT REPRESENTATION
OF THE PROPERTY LINES TO THE BEST OF
MY KNOWLEDGE AND BELIEF.

David F. Abell
DAVID F. ABELL
WISCONSIN REGISTERED LAND SURVEYOR, S-1596

DATE *November 10, 1986*
JOB NUMBER - 86068