
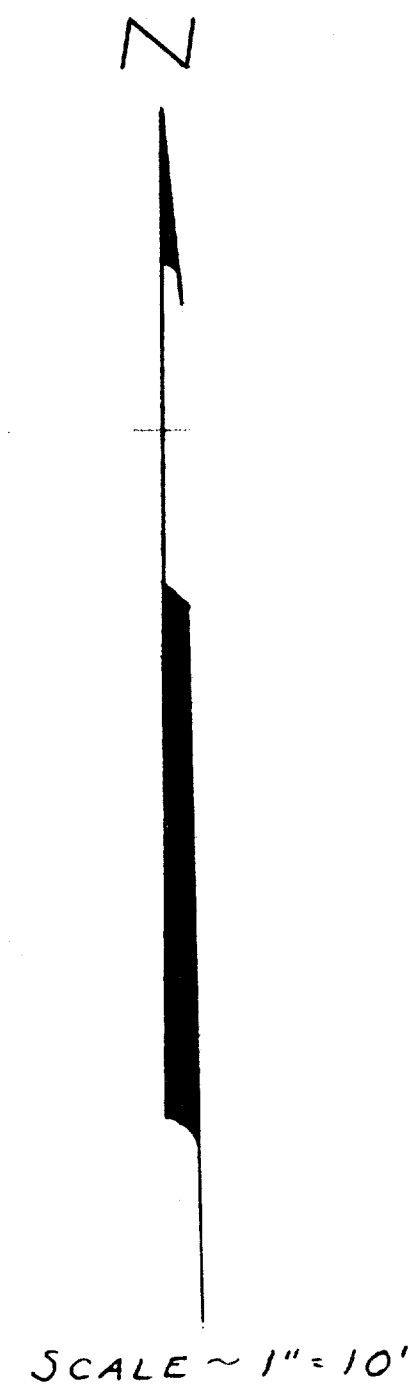


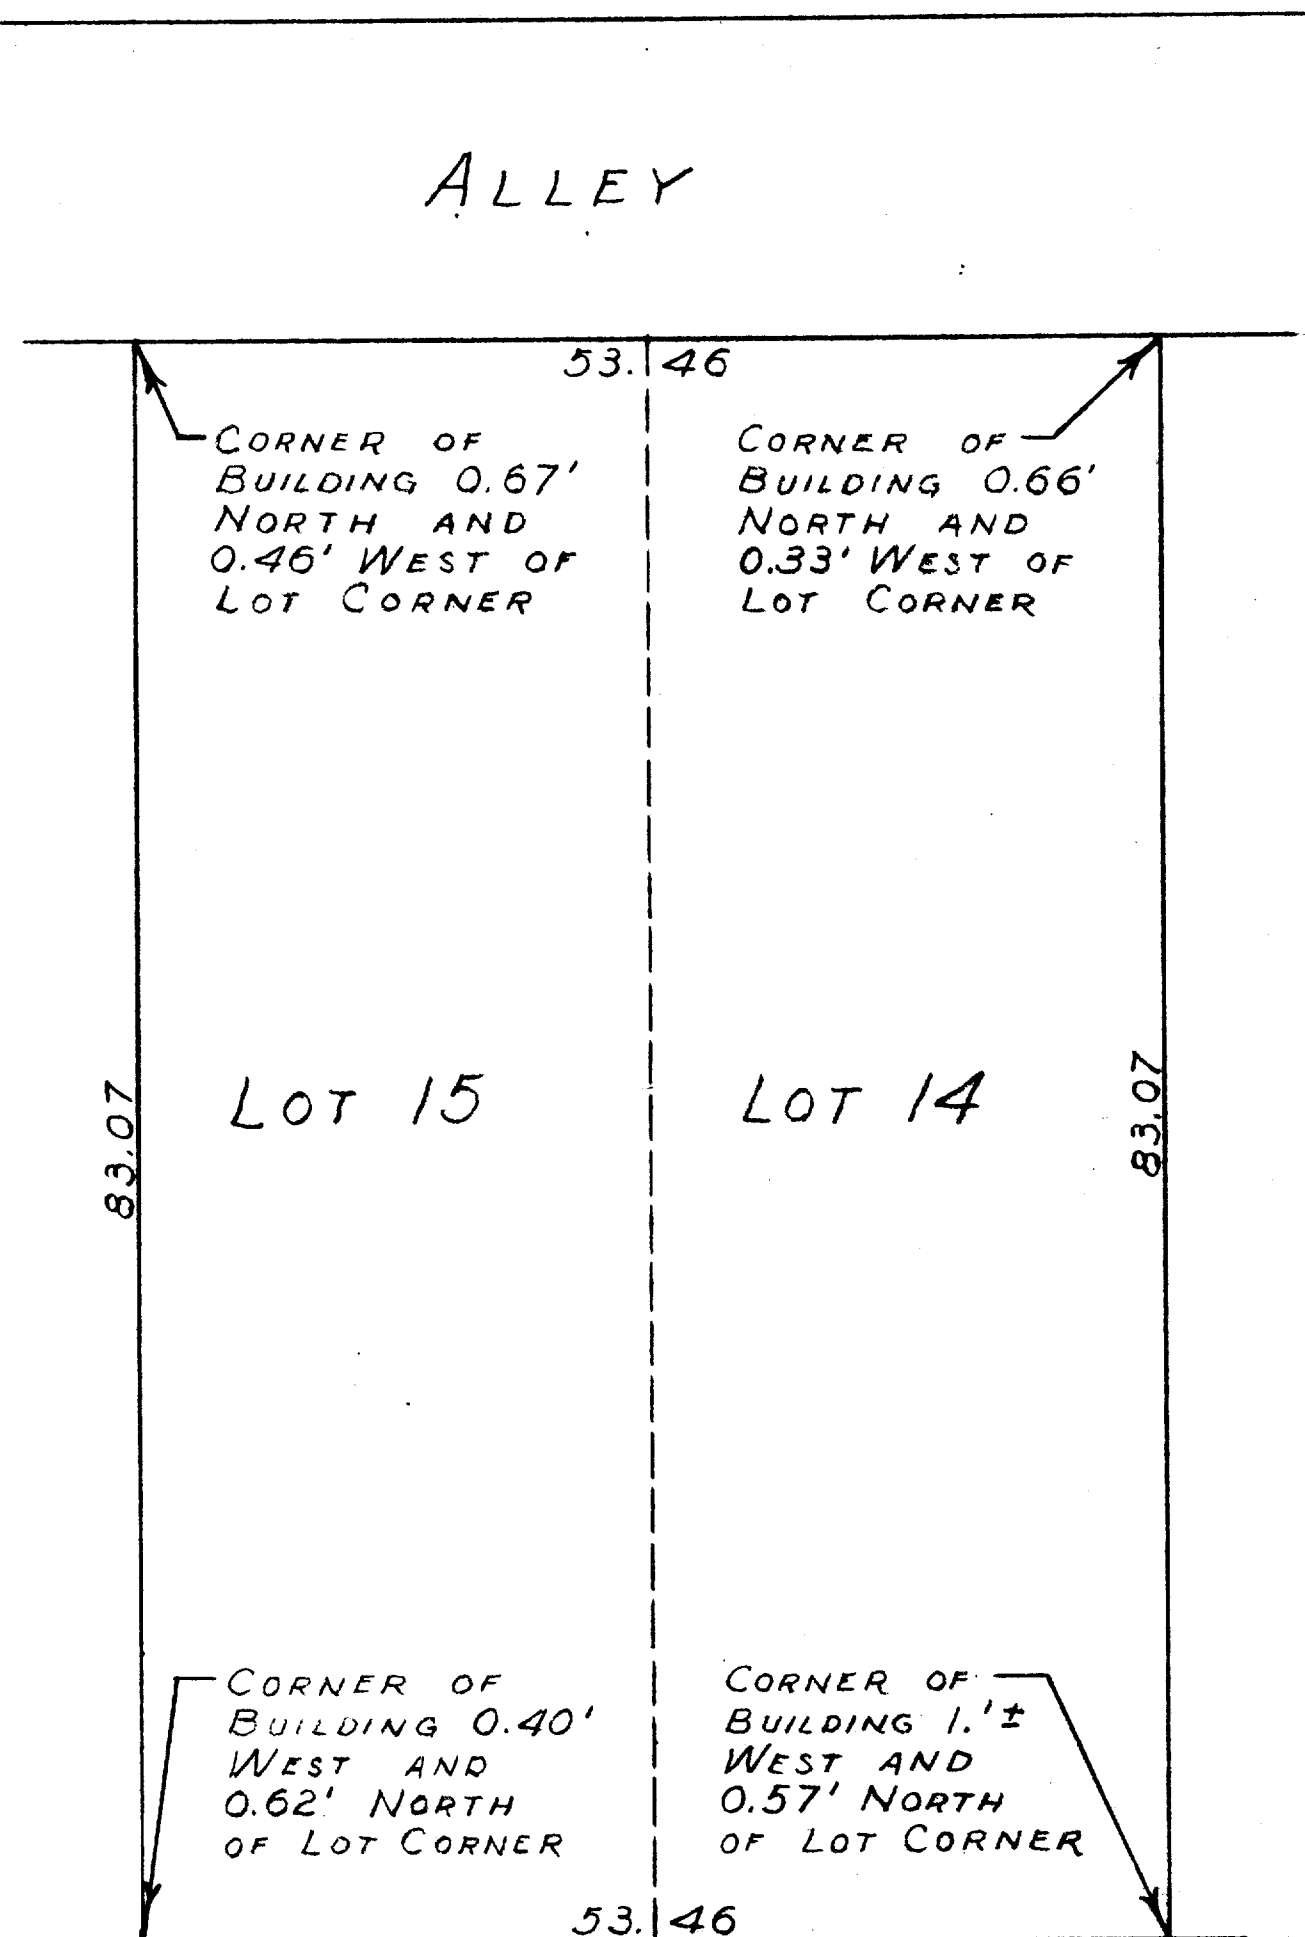

PLAT OF SURVEY OF LOTS 14 AND 15,
BLOCK 9, ORIGINAL PLAT, CITY OF
DEHAVAN, WALWORTH COUNTY, WISCONSIN
MARCH 18, 1955

George T. Dunham
GEORGE T. DUNHAM, SURVEYOR
DEHAVAN, WISCONSIN

OF WALWORTH AVENUE