
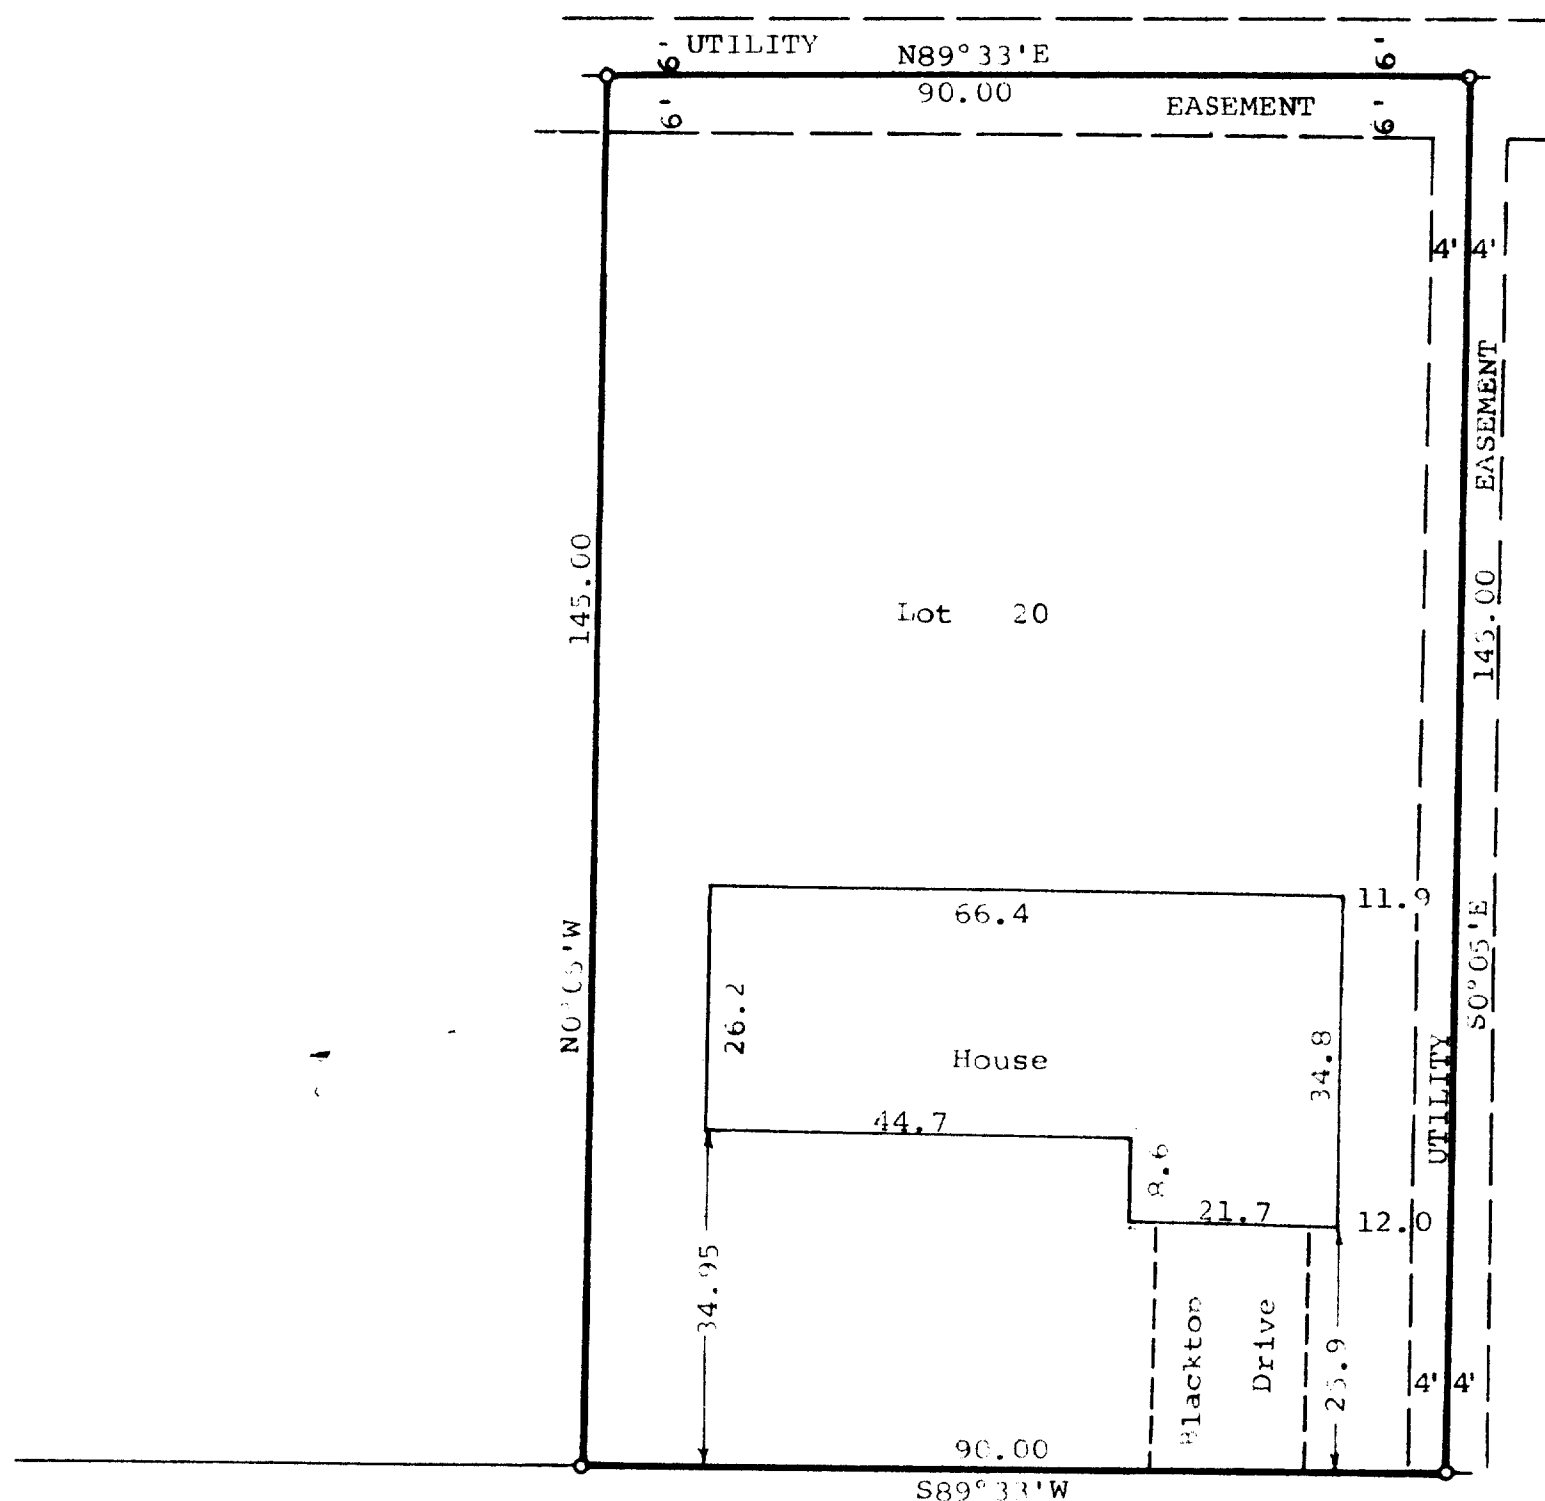


DUNHAM SURVEYING, S. C.
SURVEYING & SUBDIVIDING
DELAVER, WISCONSIN 53115

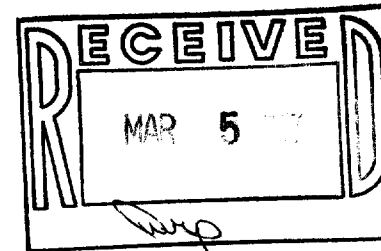

Scale - 1" = 20'
○ = 1" Dia. Iron Pipe Found

Bearings are those of record.

Owner: John Stack
c/o Brian Riemer
Attorney At Law
Riemer Law Offices
601 E. Walworth Ave.
Delaver, Wisconsin
53115

GENEVA

STREET

STREET

COURT

STATE OF WISCONSIN)
COUNTY OF WALWORTH)

I, George T. Dunham, Surveyor, certify that I have surveyed the property described as follows.

Lot 20, Block 5 of Springs Park Subdivision Addition No. 1, a subdivision located in the Southwest 1/4 of the Southwest 1/4 of Section 16, T2N, R16E, City of Delaver, Walworth County, Wisconsin, and that the map shown above is a correct representation thereof and shows the size and location of the property, its exterior boundaries, the location of all visible structures and dimensions of all principal buildings thereon, boundary fences, apparent easements, roadways and visible encroachments, if any, and that I have surveyed the property hereon described, according to the official records, to the best of my knowledge and belief.
January 19, 1937.

George T. Dunham
George T. Dunham, Surveyor

