
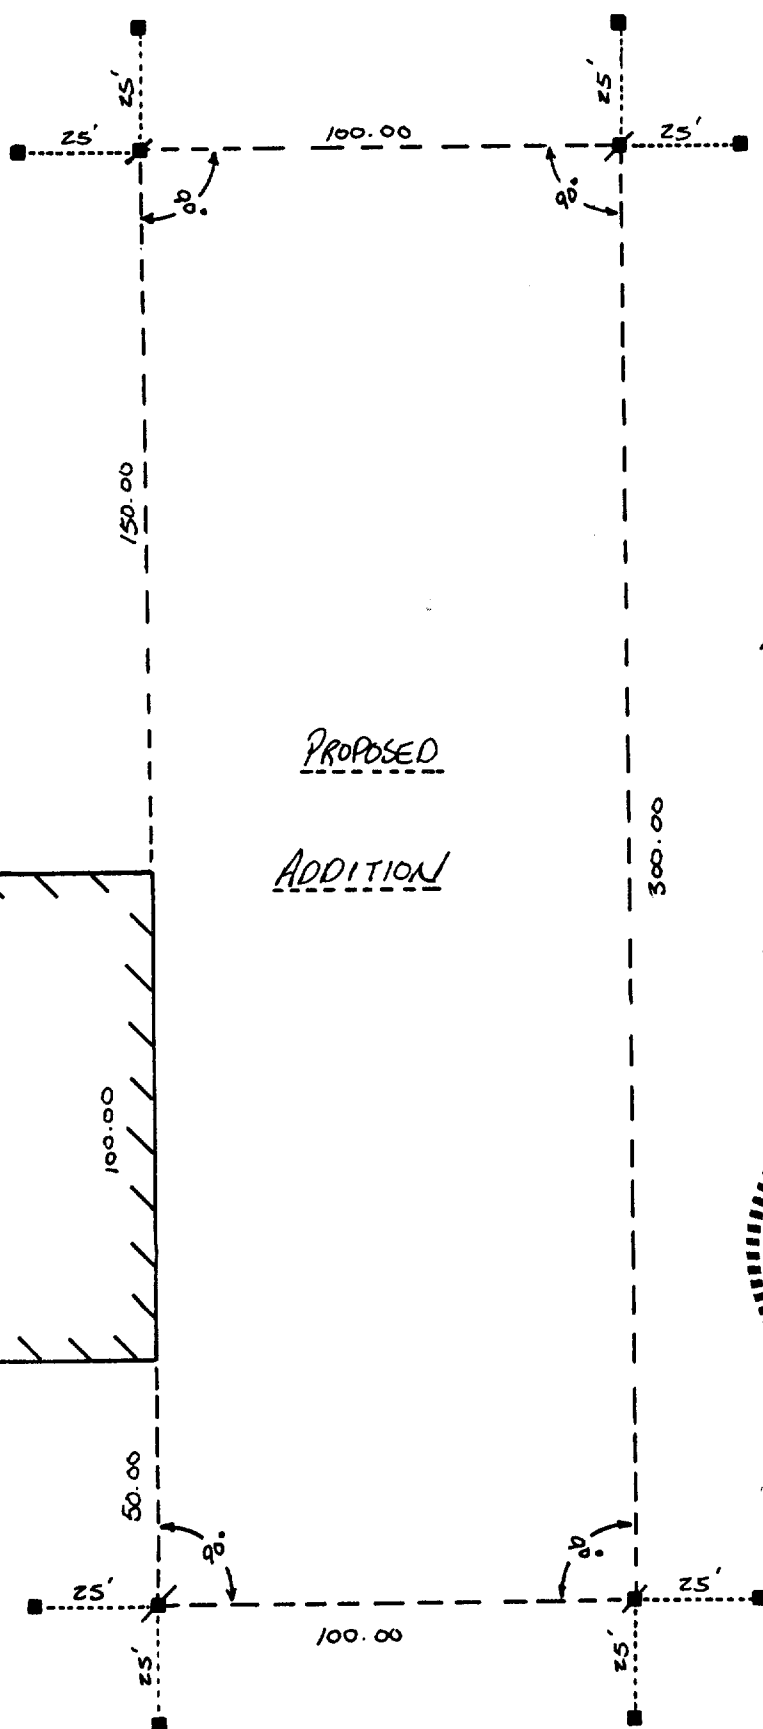


SKETCH OF BUILDING STAKEOUT

ON THE PROPERTY OF SUPERIOR STAINLESS, HWY. "O",
DELEVAN, WISCONSIN.

FOR: MAGILL CONSTRUCTION COMPANY
P.O. BOX 407
ELKHORN, WI. 53121

BY: JENSEN SURVEYING & MAPPING S.C.
45 S. WISCONSIN ST. P.O. BOX 322
ELKHORN, WI. 53121

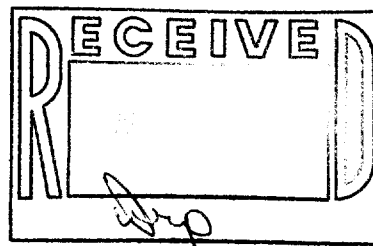

SCALE: 1" = 40'

LEGEND

- ~ SET WOOD STAKE AT BUILDING CORNER
- ~ SET WOOD STAKE, 25' OFFSET

STAKED: DECEMBER 5, 1986

MAPPING DATE: DECEMBER 8, 1986

