


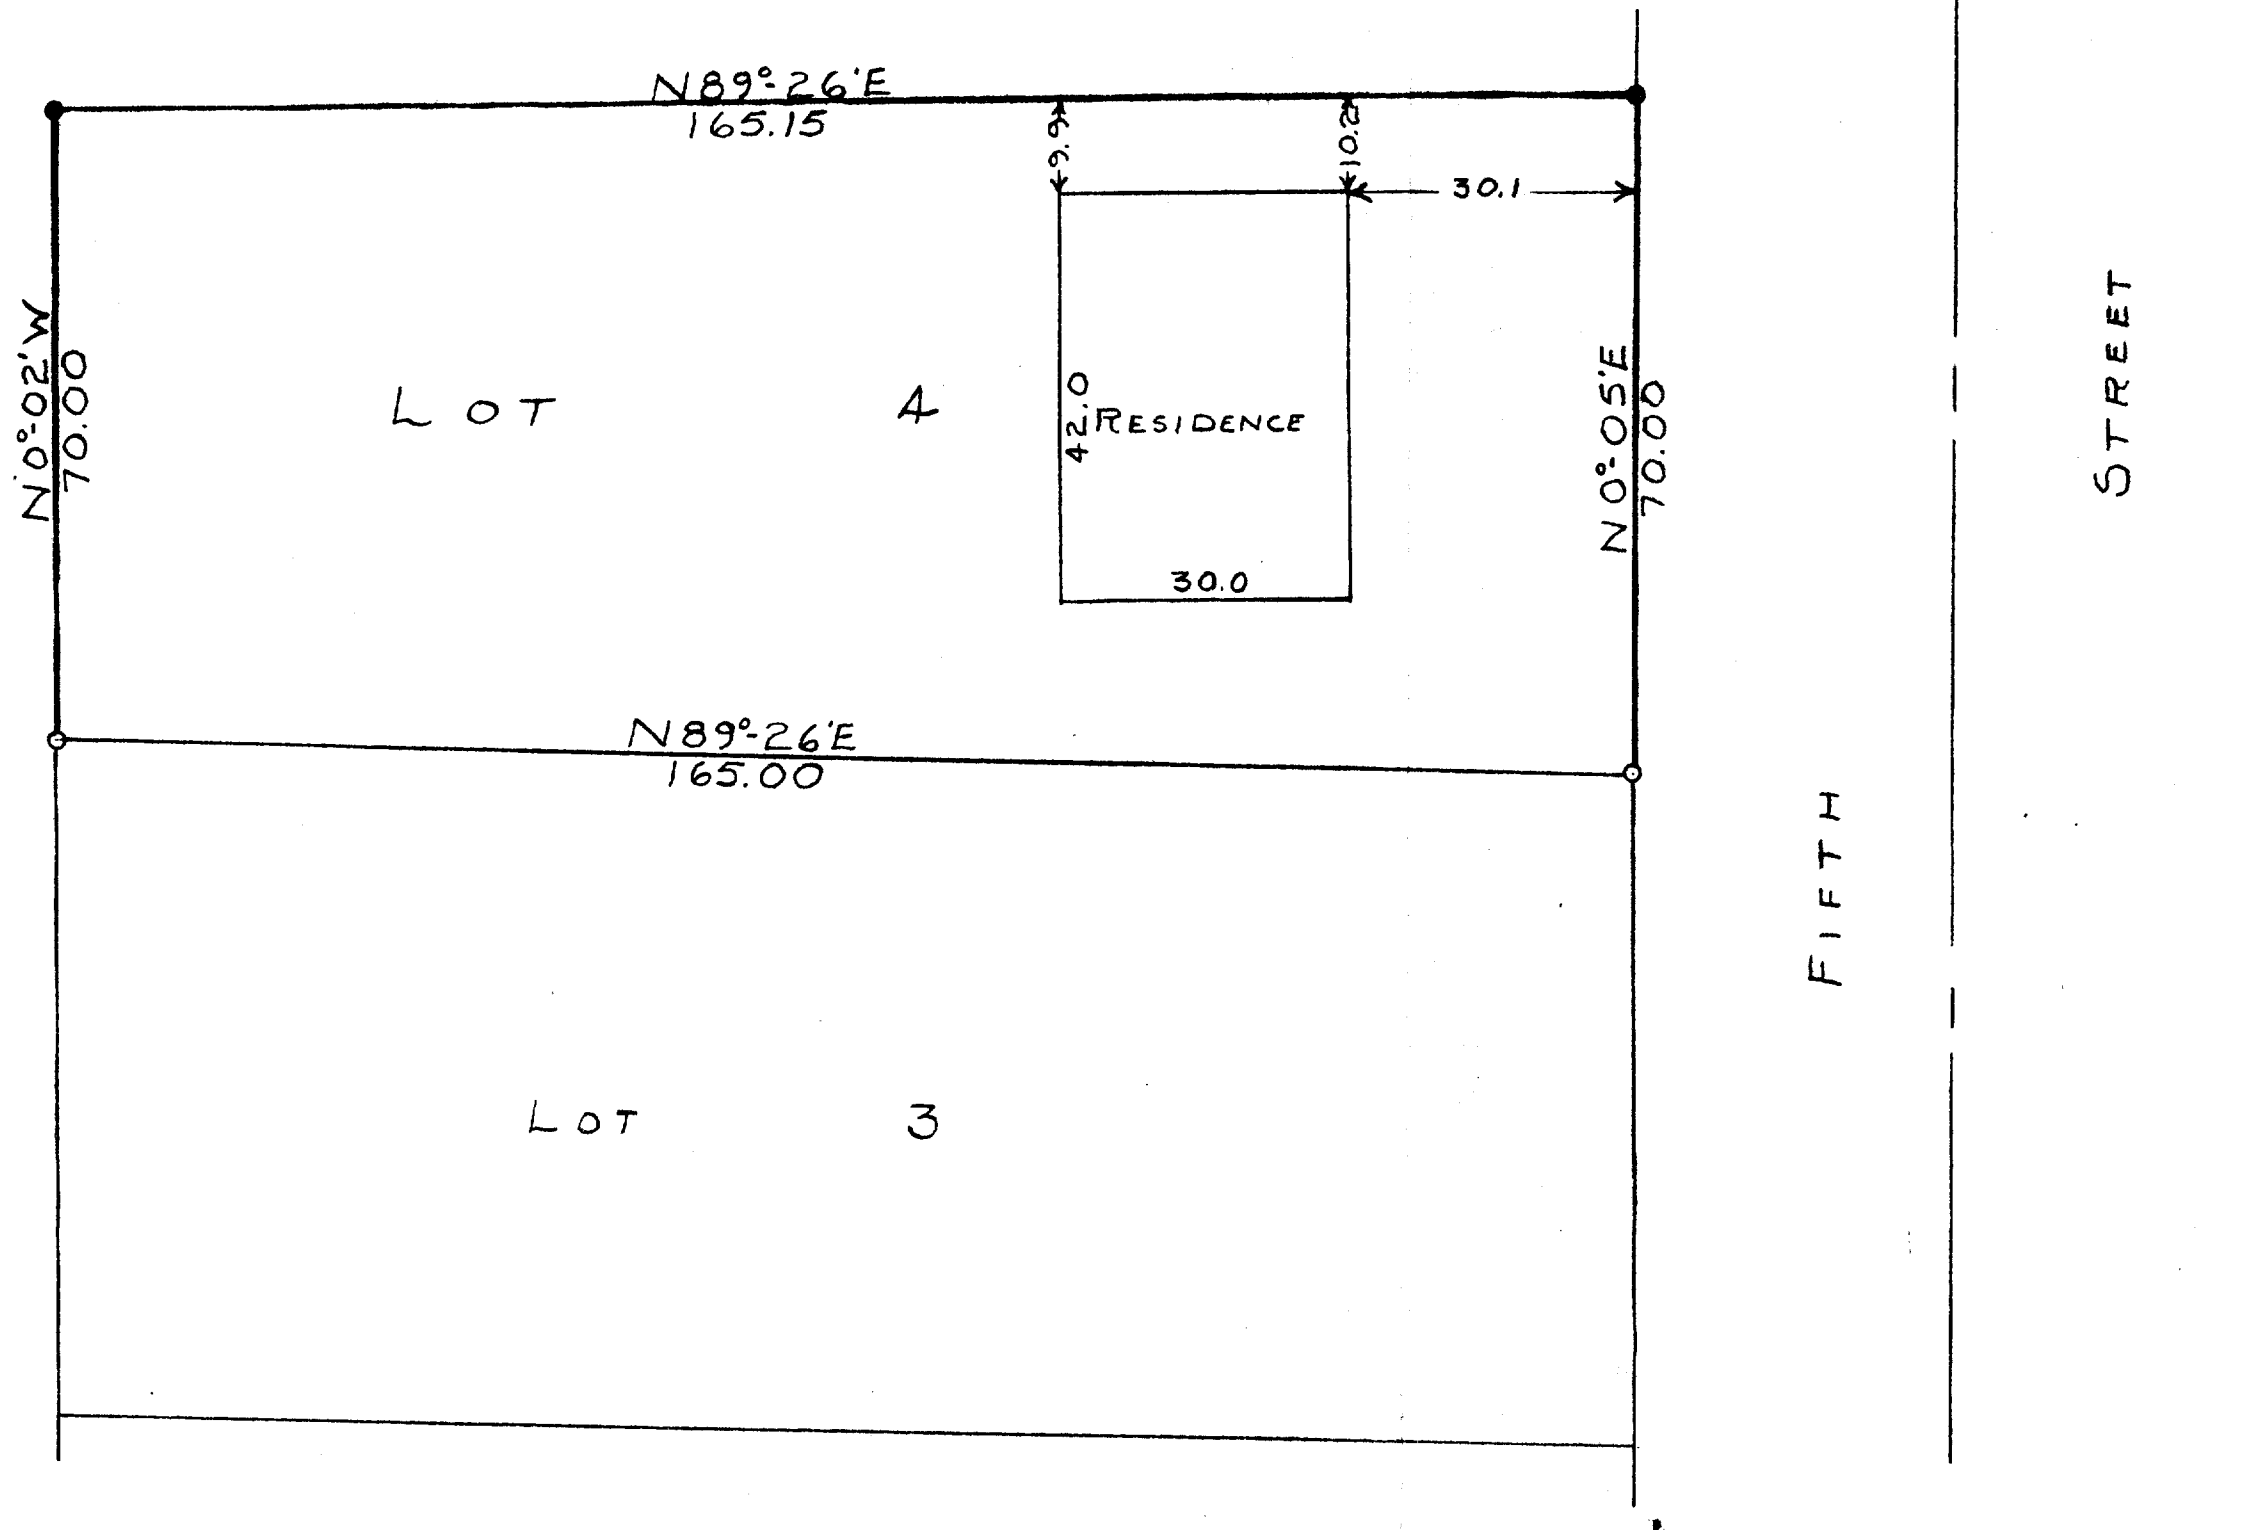

SCALE-1"=20'
 O=IRON PIPE
 ●=CONC. MONU.

STATE OF WISCONSIN)⁵⁵
 COUNTY OF WALWORTH)

I, GEORGE T. DUNHAM, DO HEREBY CERTIFY THAT I HAVE SURVEYED THE
 PROPERTY DESCRIBED AS FOLLOWS:

LOT 4 OF KNAPP'S SUBDIVISION LOCATED IN THE CITY OF DELAVAN,
 WALWORTH COUNTY, WISCONSIN

AND THAT THE PLAT SHOWN ABOVE IS A CORRECT REPRESENTATION OF THE PROPERTY
 LINES AND OF THE IMPROVEMENTS LOCATED THEREON.

NOV. 21, 1956

George T. Dunham
 GEORGE T. DUNHAM, SURVEYOR
 DELAVAN, WISCONSIN

2-76