


N
SCALE-1"=20'
IRON PIPE

WISCONSIN

STREET

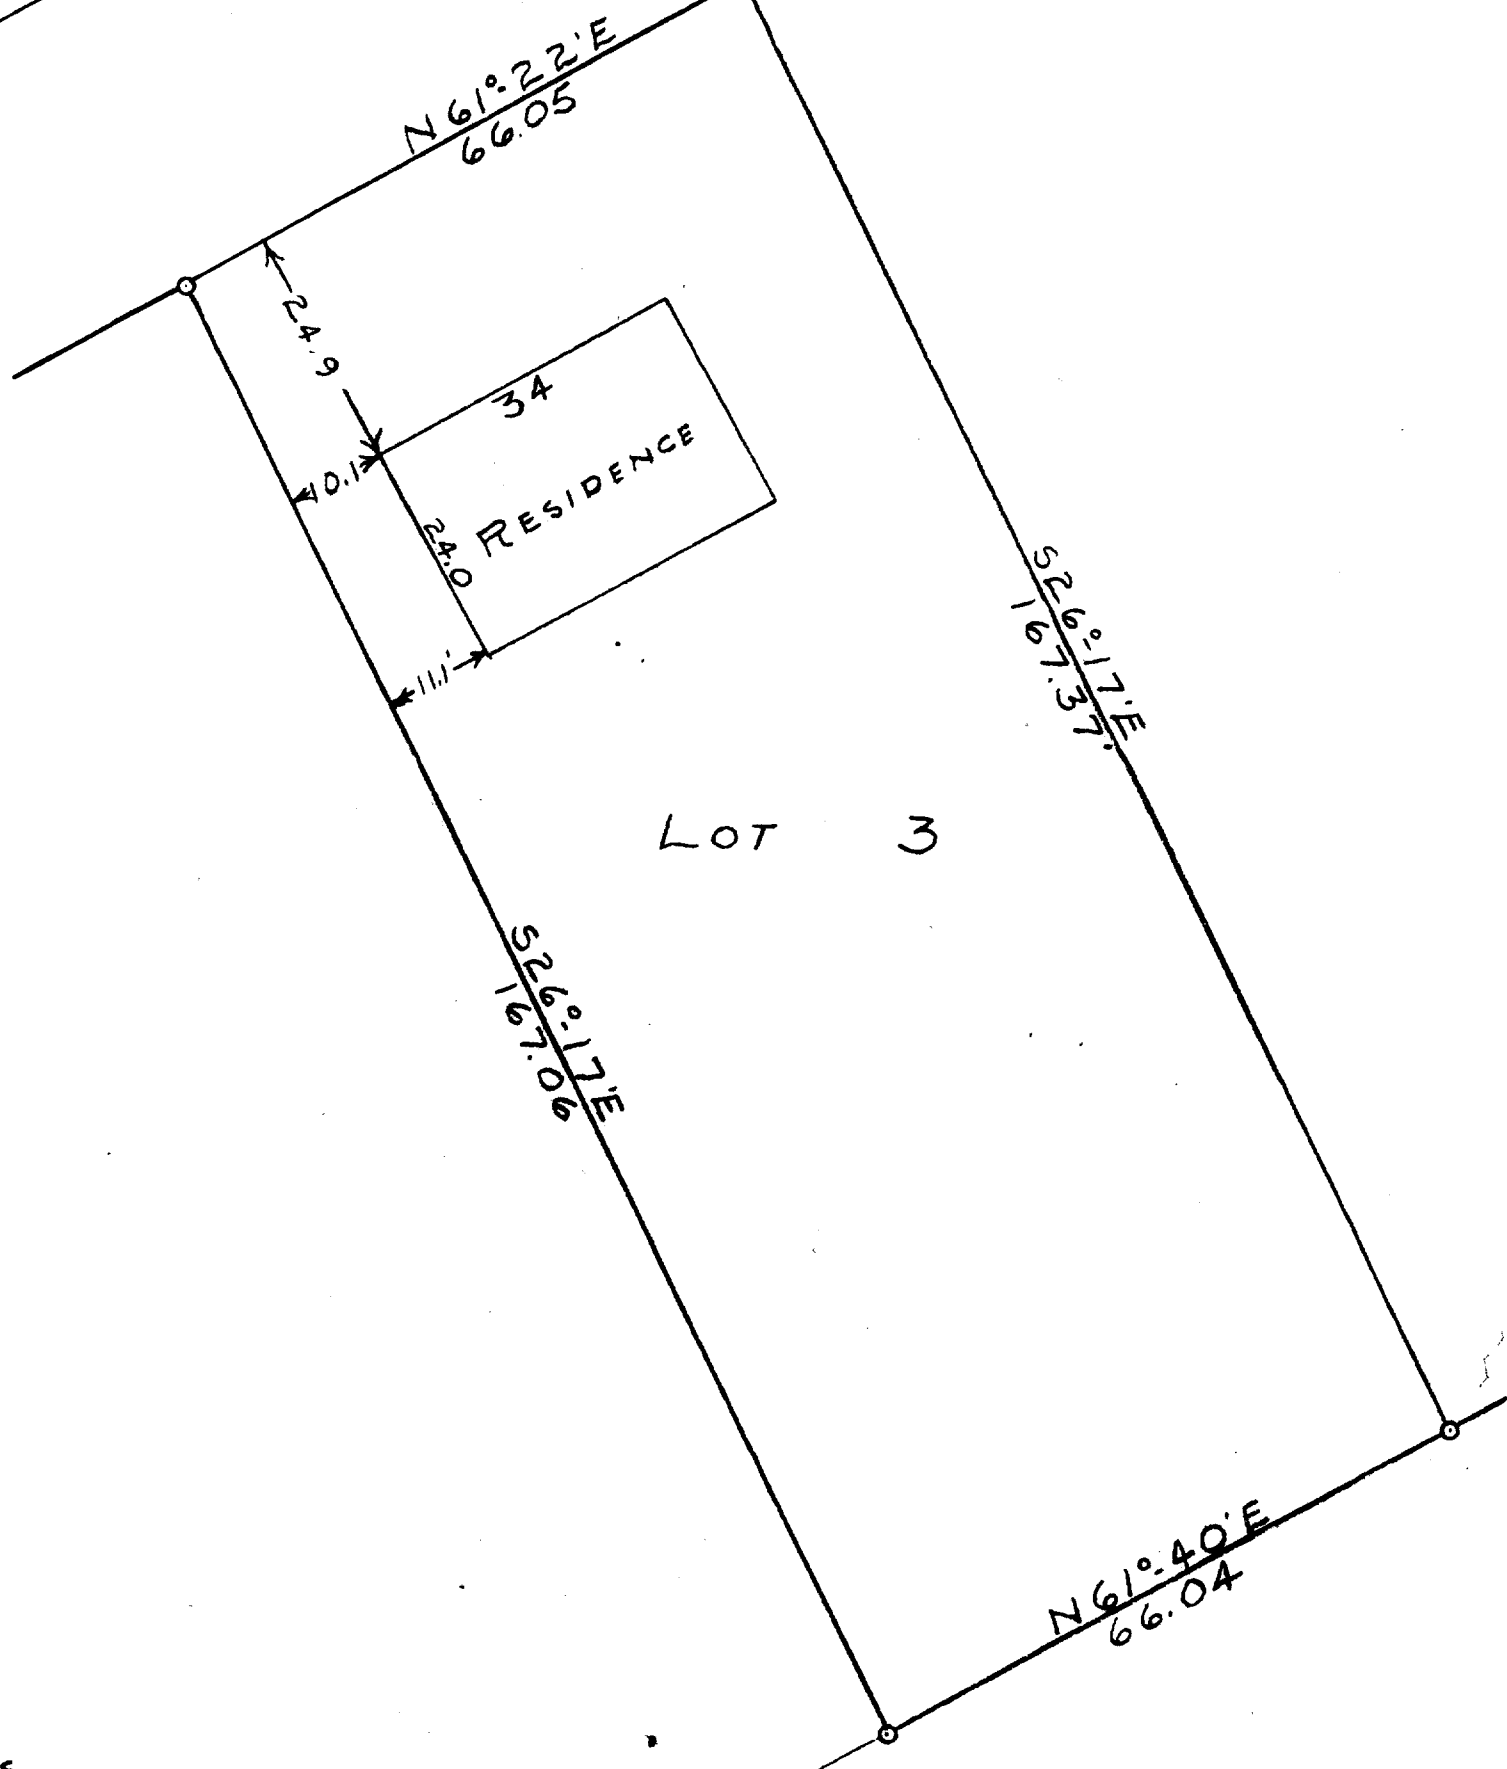

STATE OF WISCONSIN)⁵⁵
COUNTY OF WALWORTH)

I, GEORGE T. DUNHAM, DO HEREBY CERTIFY THAT I HAVE SURVEYED
THE PROPERTY DESCRIBED AS FOLLOWS:

LOT 3, BLOCK 1 OF SUNNY SIDE SUBDIVISION LOCATED IN THE
CITY OF DELAVAN, WALWORTH COUNTY, WISCONSIN

AND THAT THE PLAT SHOWN ABOVE IS A CORRECT REPRESENTATION OF THE
PROPERTY LINES AND OF THE IMPROVEMENTS LOCATED THEREON.
OCT. 5, 1956

George T. Dunham
GEORGE T. DUNHAM, SURVEYOR
DELAVAN, WISCONSIN