


DUNHAM SURVEYING, S. C.
SURVEYING & SUBDIVIDING
DELAVAL, WISCONSIN 53115

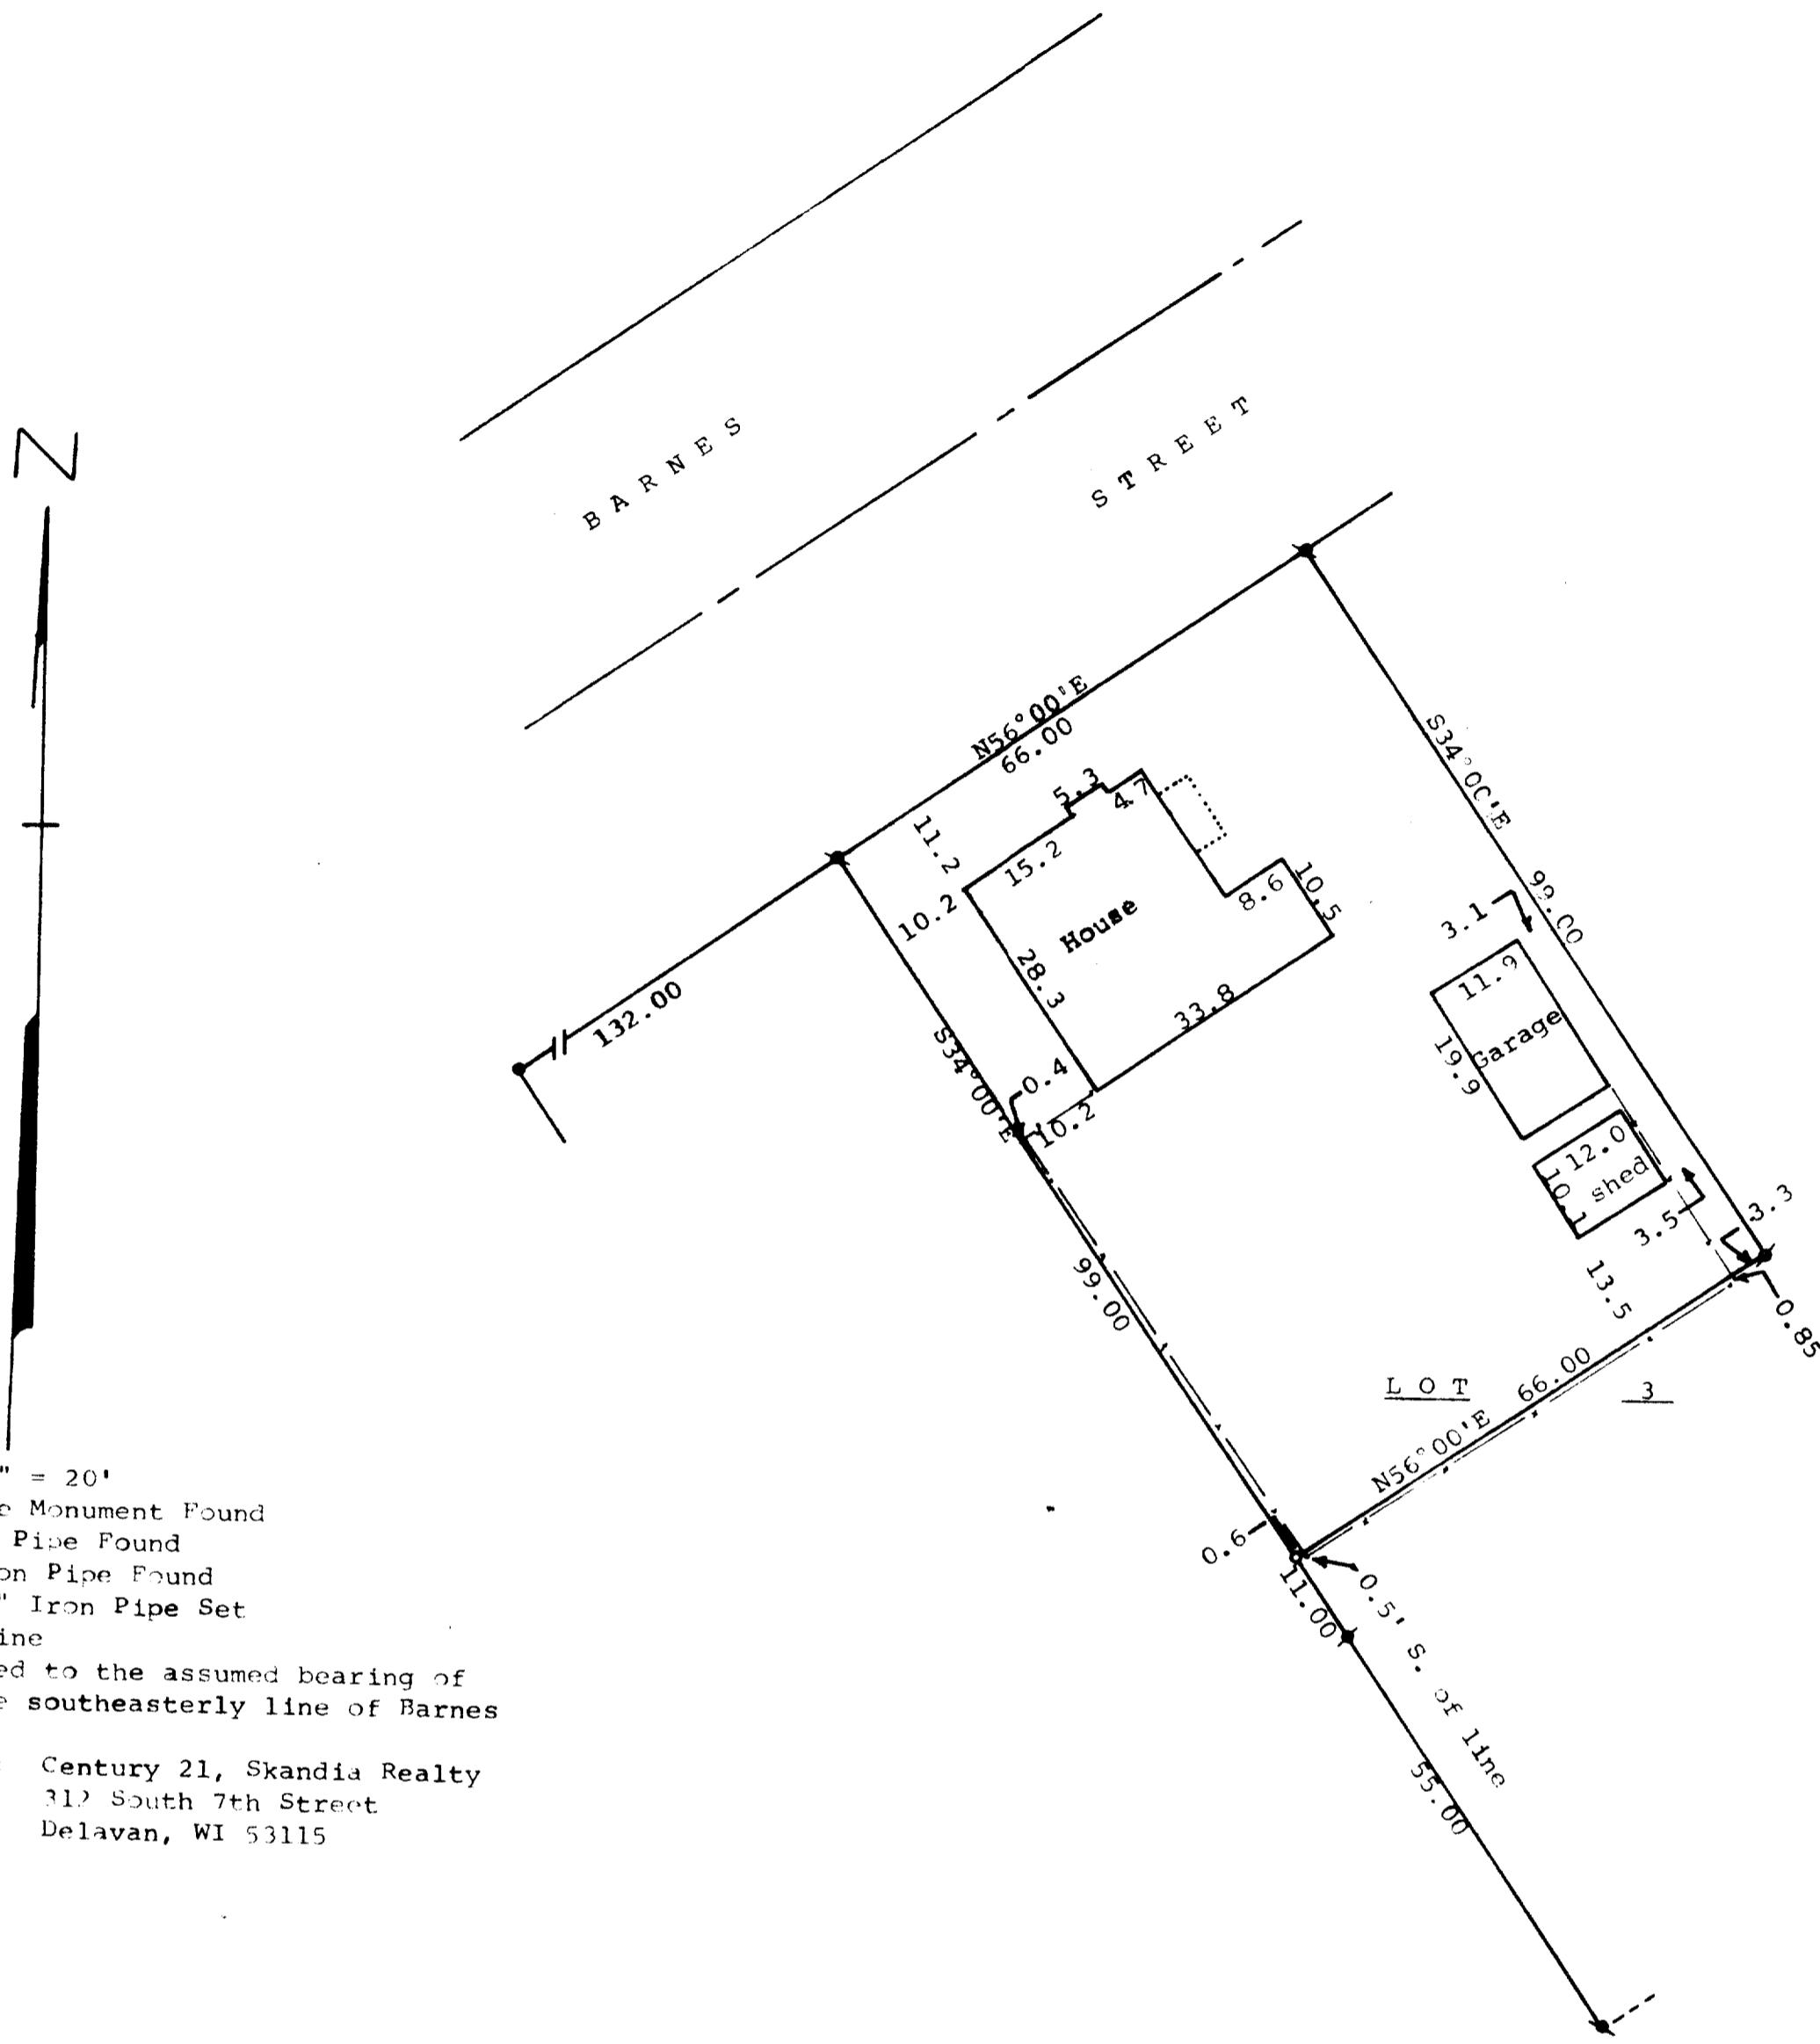

STATE OF WISCONSIN) ss
COUNTY OF WALWORTH)

I, George T. Dunham, Surveyor, certify that I have surveyed the property described as follows:

The Northerly 99.00 feet of Lot 3, Block 3, in Elmhurst Addition, City of Delavan, Walworth County, Wisconsin, and that the map shown above is a correct representation thereof and shows the size and location of the property, its exterior boundaries, the location of all visible structures and dimensions of all principal buildings thereon, boundary fences, apparent easements, roadways and visible encroachments, if any, and that I have surveyed the property herein described according to the official records, to the best of my knowledge and belief.

March 26, 1987

George T. Dunham
George T. Dunham, Surveyor

