


ABELL
SURVEYING & MAPPING
DELAVER, WISCONSIN 53115
414-728-6737

SCHAUF STREET

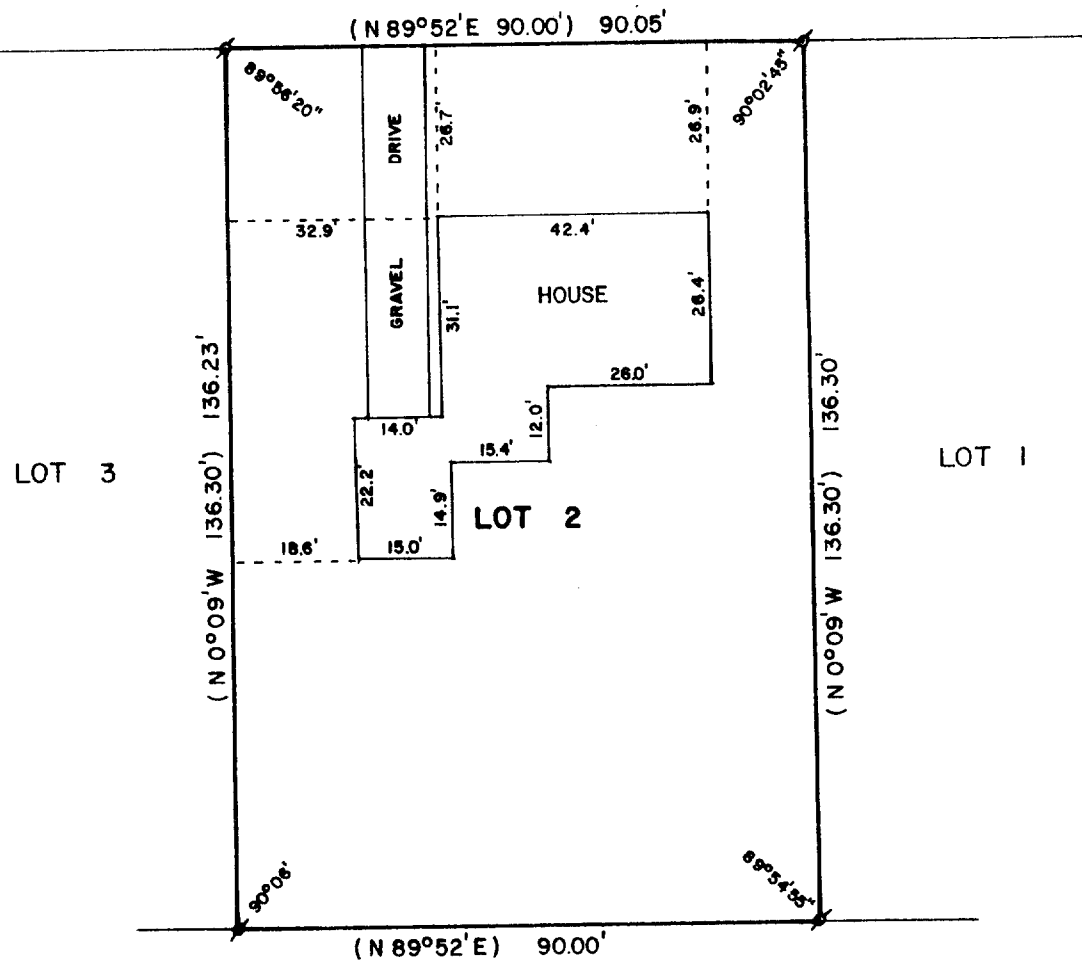

PLAT OF SURVEY OF

LOT 2 OF HILLTOP SUBDIVISION, LOCATED IN THE SOUTH-
WEST 1/4 OF SECTION 18, T2N, R16E, CITY OF DELAVER,
WALWORTH COUNTY, WISCONSIN.


ORDERED BY: CENTURY 21 - SKANDIA REALTY
312 S. 7th STREET
DELAVER, WI 53115



SCALE - 1"=30'

LEGEND

σ - IRON PIPE FOUND
() - RECORDED AS

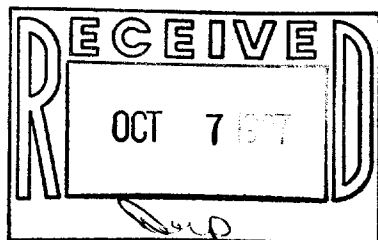

I, DAVID F. ABELL, DO HEREBY CERTIFY
THAT I HAVE SURVEYED THE PROPERTY
HEREON DESCRIBED ACCORDING TO THE
OFFICIAL RECORDS AND THAT THE PLAT
HEREON IS A CORRECT REPRESENTATION
OF THE PROPERTY LINES TO THE BEST OF
MY KNOWLEDGE AND BELIEF.

David F. Abell
DAVID F. ABELL
WISCONSIN REGISTERED LAND SURVEYOR, S-1596

DATE *June 1, 1987* JOB NUMBER - 87071
NOTE: THIS IS NOT A CERTIFIED COPY UNLESS SEALED.