


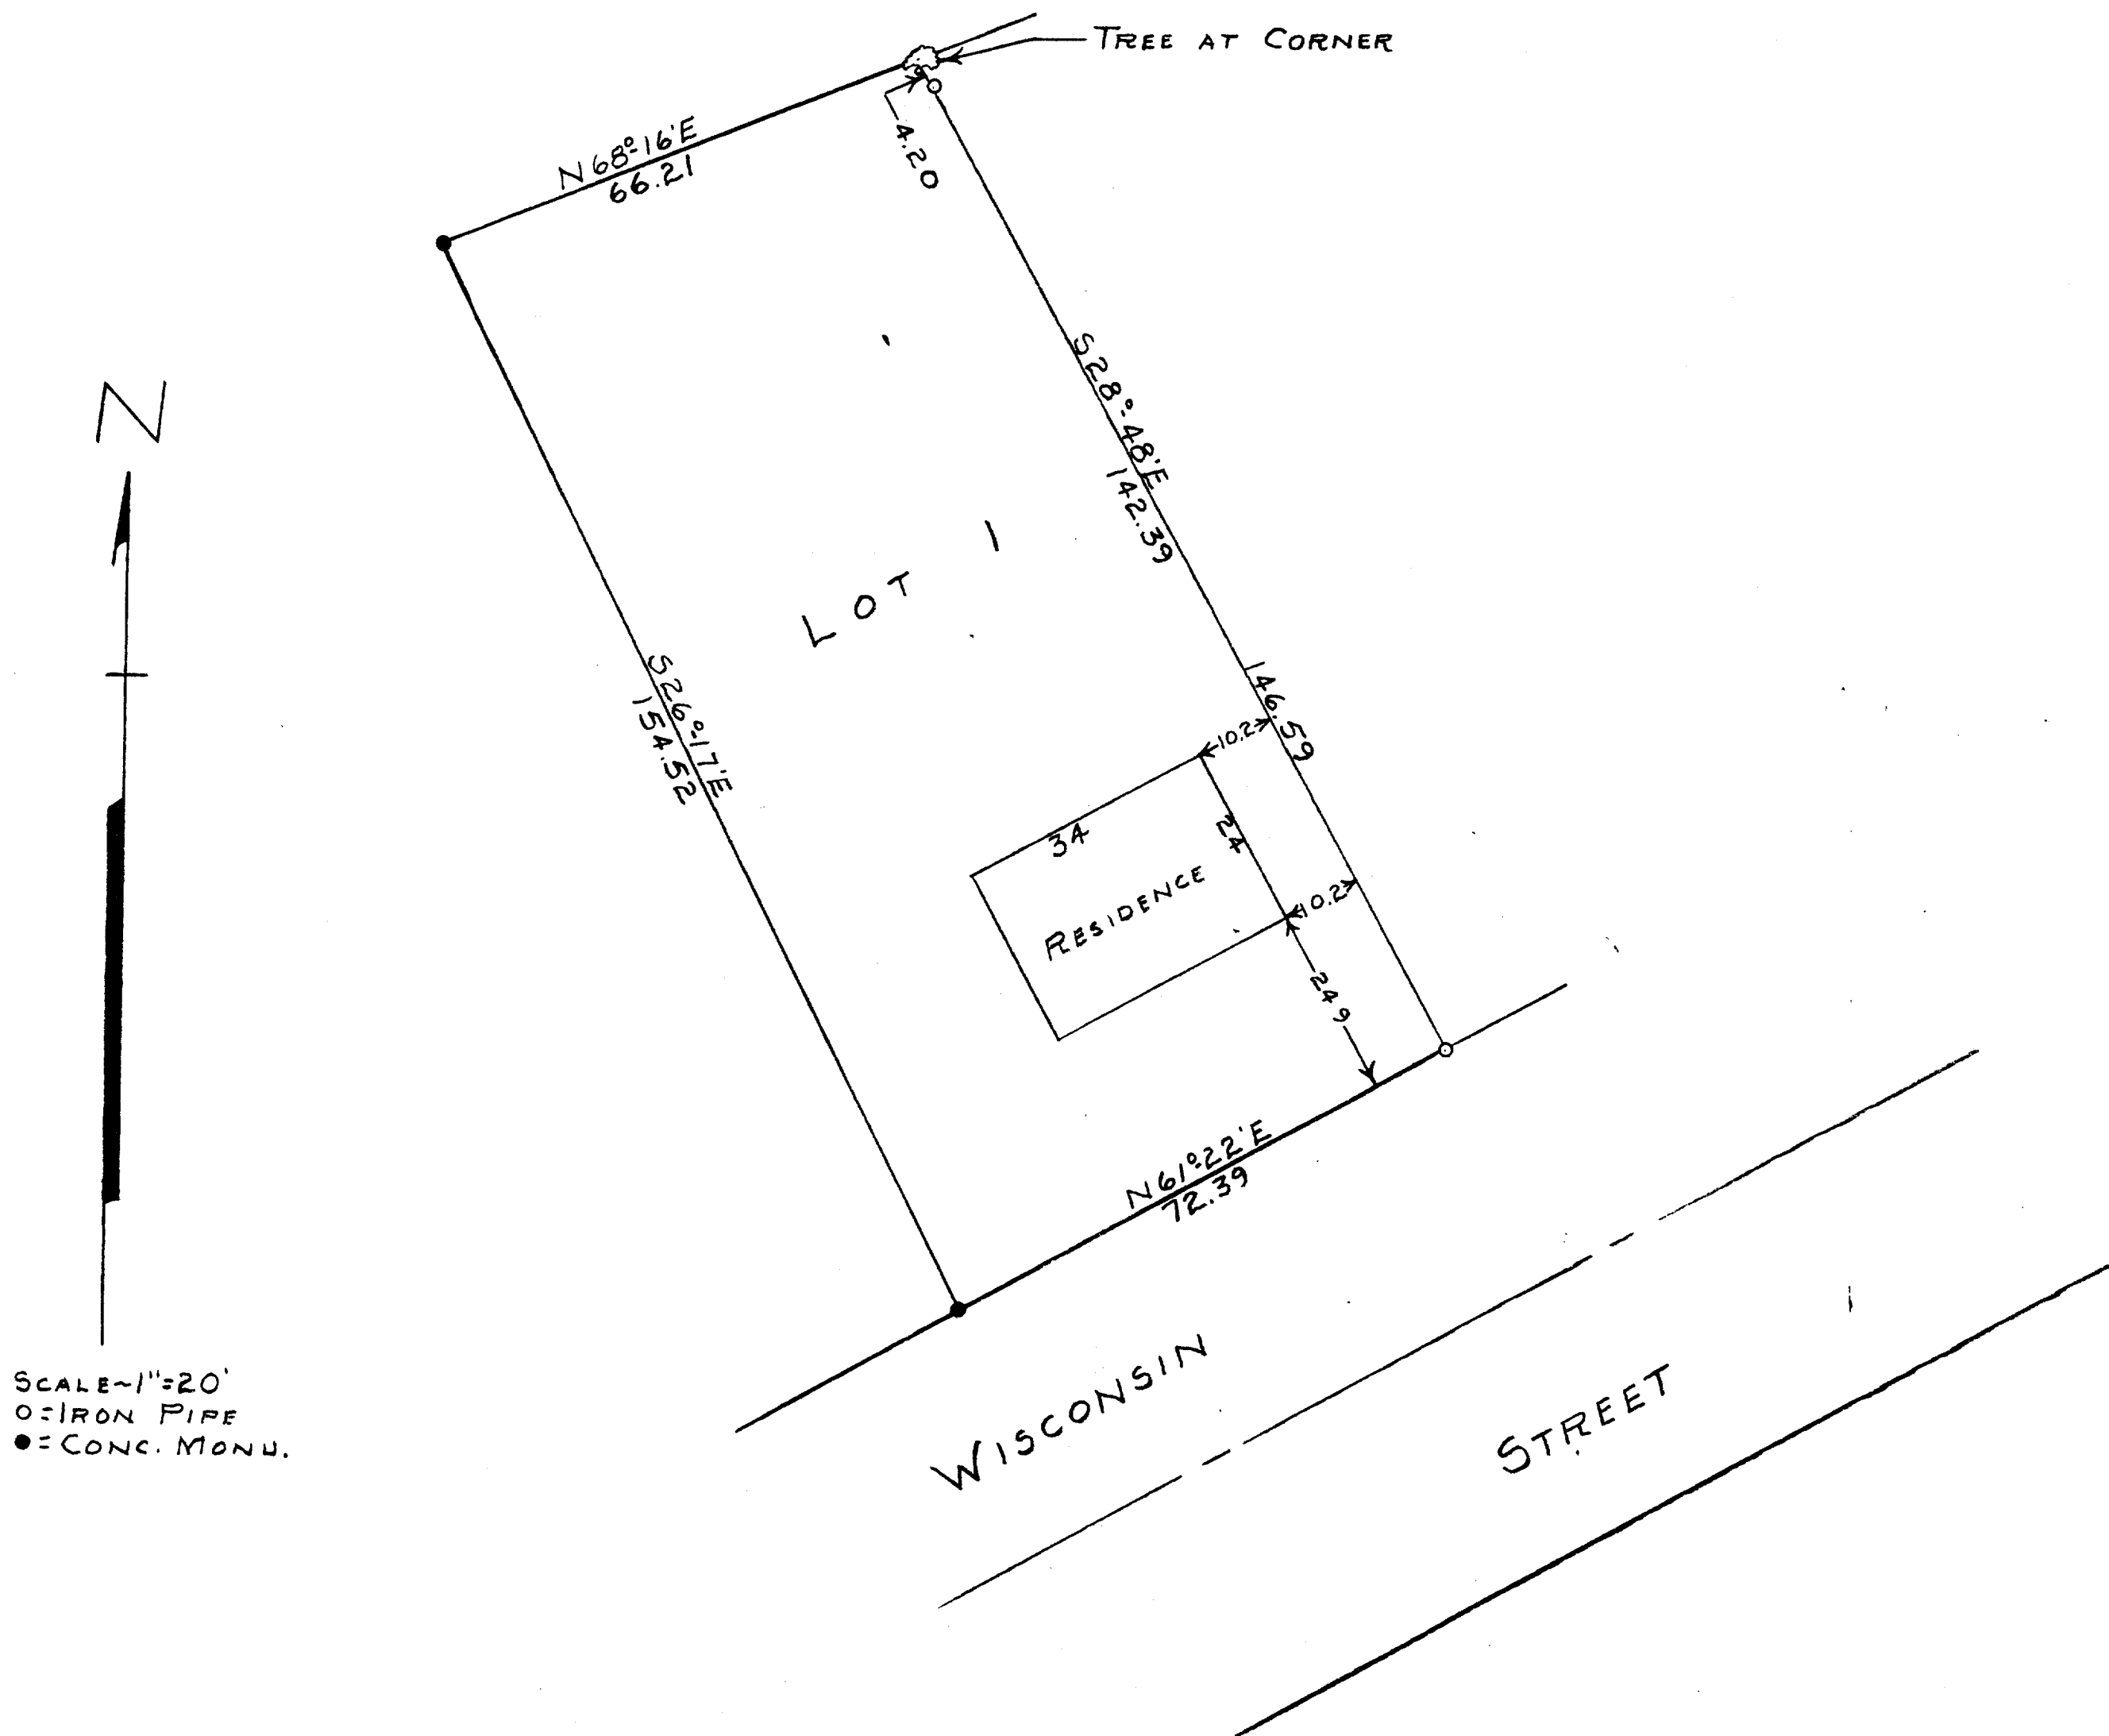

STATE OF WISCONSIN)
COUNTY OF WALWORTH)

I, GEORGE T. DUNHAM, DO HEREBY CERTIFY THAT I HAVE SURVEYED THE
PROPERTY DESCRIBED AS FOLLOWS:

LOT 1, BLOCK 2 OF SUNNY SIDE SUBDIVISION LOCATED IN THE CITY
OF DELAVAN, WALWORTH COUNTY, WISCONSIN
AND THAT THE PLAT SHOWN ABOVE IS A CORRECT REPRESENTATION OF THE PROPERTY
LINES AND OF THE IMPROVEMENTS LOCATED THEREON.
OCT. 5, 1956

George T. Dunham
GEORGE T. DUNHAM, SURVEYOR
DELAVAN, WISCONSIN