


ABELL
SURVEYING & MAPPING
 DELAVAN, WISCONSIN 53115
 414-728-6737

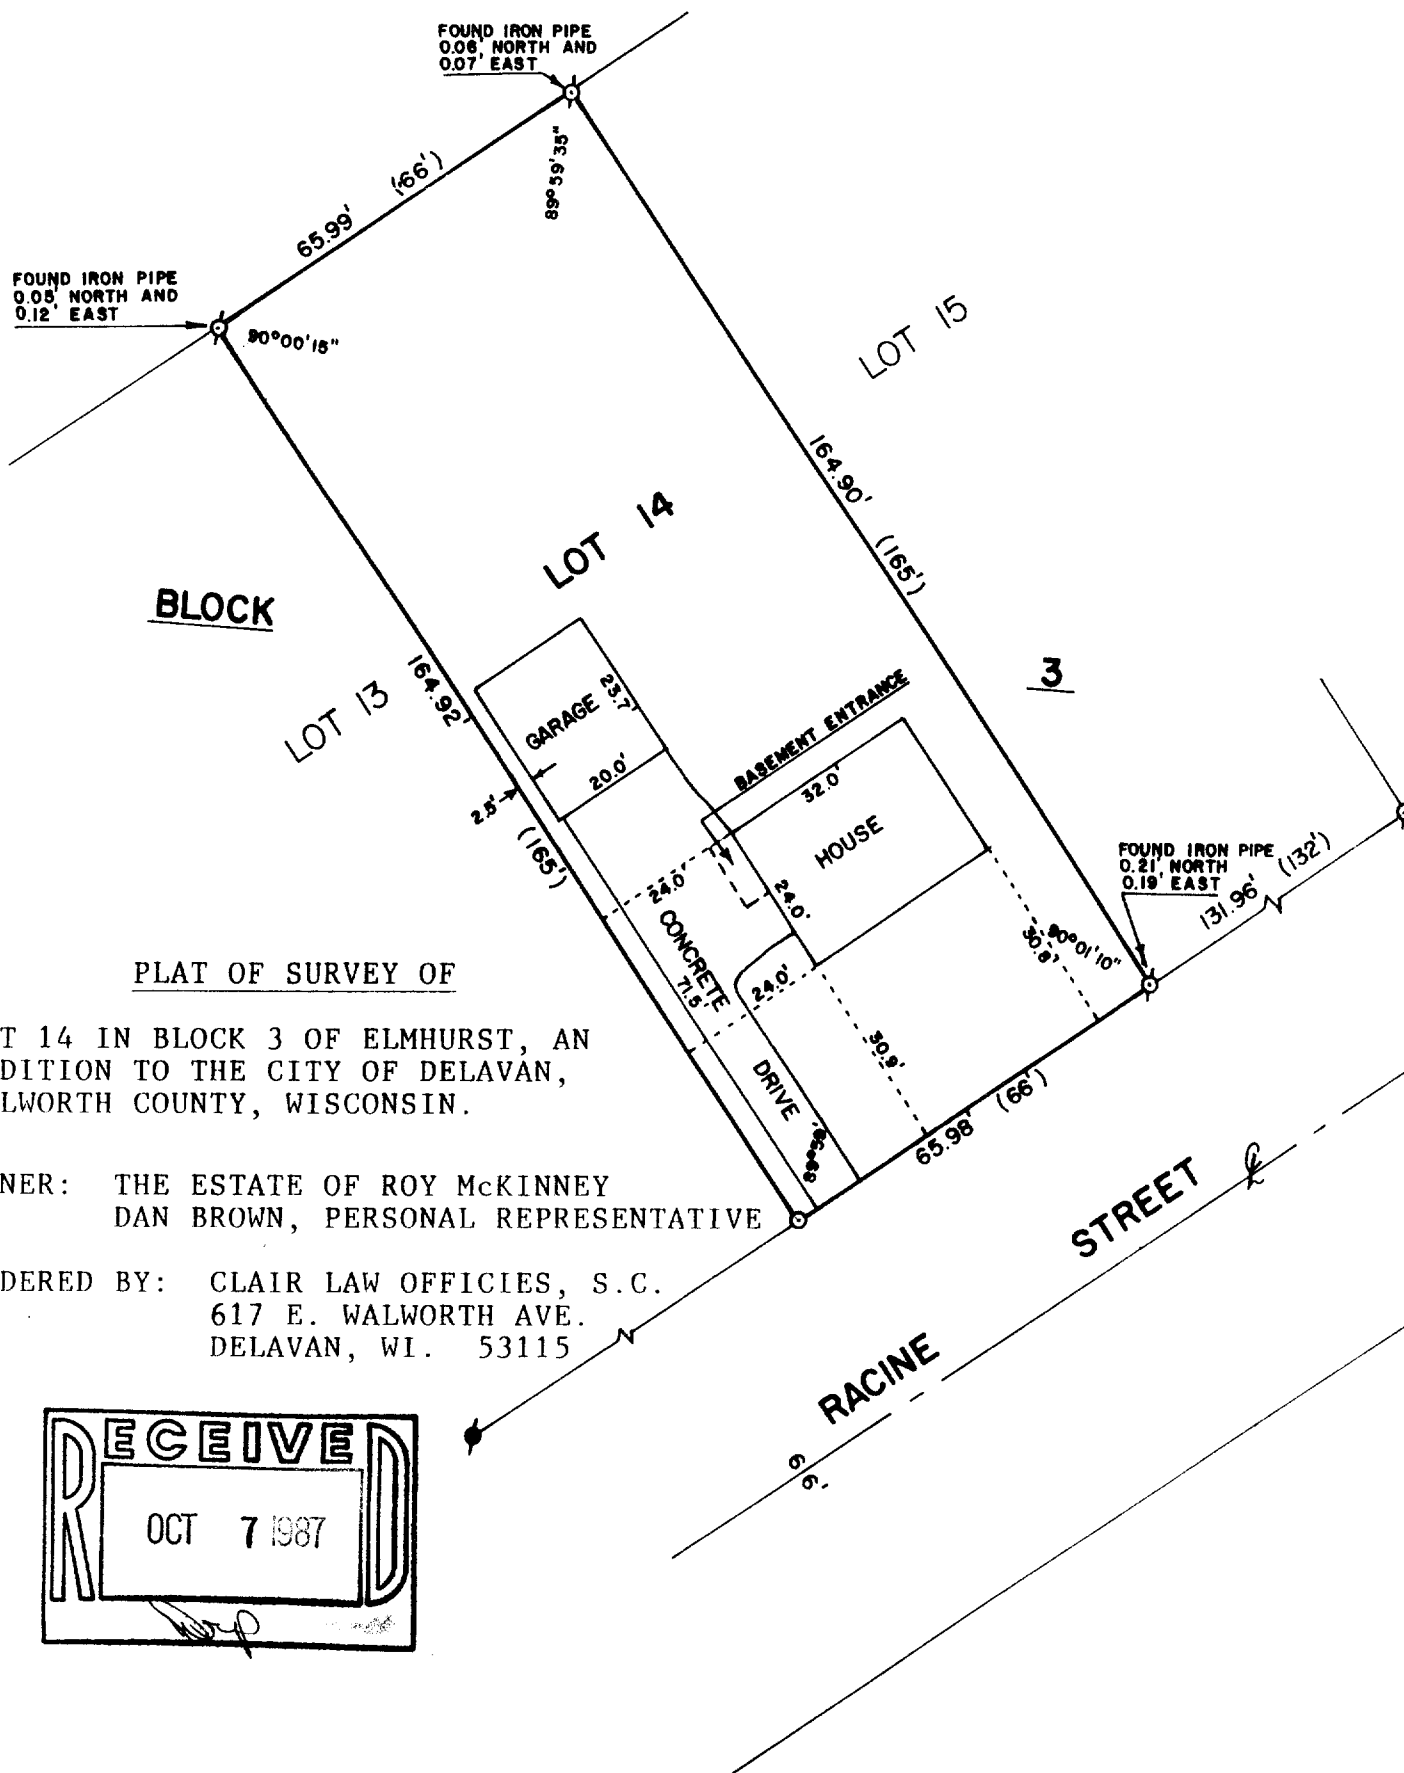


PLAT OF SURVEY OF

LOT 14 IN BLOCK 3 OF ELMHURST, AN
 ADDITION TO THE CITY OF DELAVAN,
 WALWORTH COUNTY, WISCONSIN.

OWNER: THE ESTATE OF ROY McKINNEY
 DAN BROWN, PERSONAL REPRESENTATIVE

ORDERED BY: CLAIR LAW OFFICES, S.C.
 617 E. WALWORTH AVE.
 DELAVAN, WI. 53115

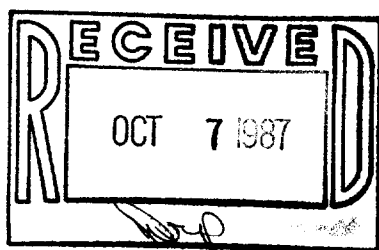

SCALE - 1"=30'

LEGEND

- ⊗ - IRON PIPE FOUND
- - CONCRETE MONUMENT FOUND
- - 3/4" DIA. IRON ROD SET
- () - RECORDED AS

I, DAVID F. ABELL, DO HEREBY CERTIFY
 THAT I HAVE SURVEYED THE PROPERTY
 HEREON DESCRIBED ACCORDING TO THE
 OFFICIAL RECORDS AND THAT THE PLAT
 HEREON IS A CORRECT REPRESENTATION
 OF THE PROPERTY LINES TO THE BEST OF
 MY KNOWLEDGE AND BELIEF.

David F. Abell
 DAVID F. ABELL
 WISCONSIN REGISTERED LAND SURVEYOR, S-1596

August 29, 1987
 DATE JOB NUMBER - 87121
 NOTE: THIS IS NOT A CERTIFIED COPY UNLESS SEALED.